PP-20-25.21

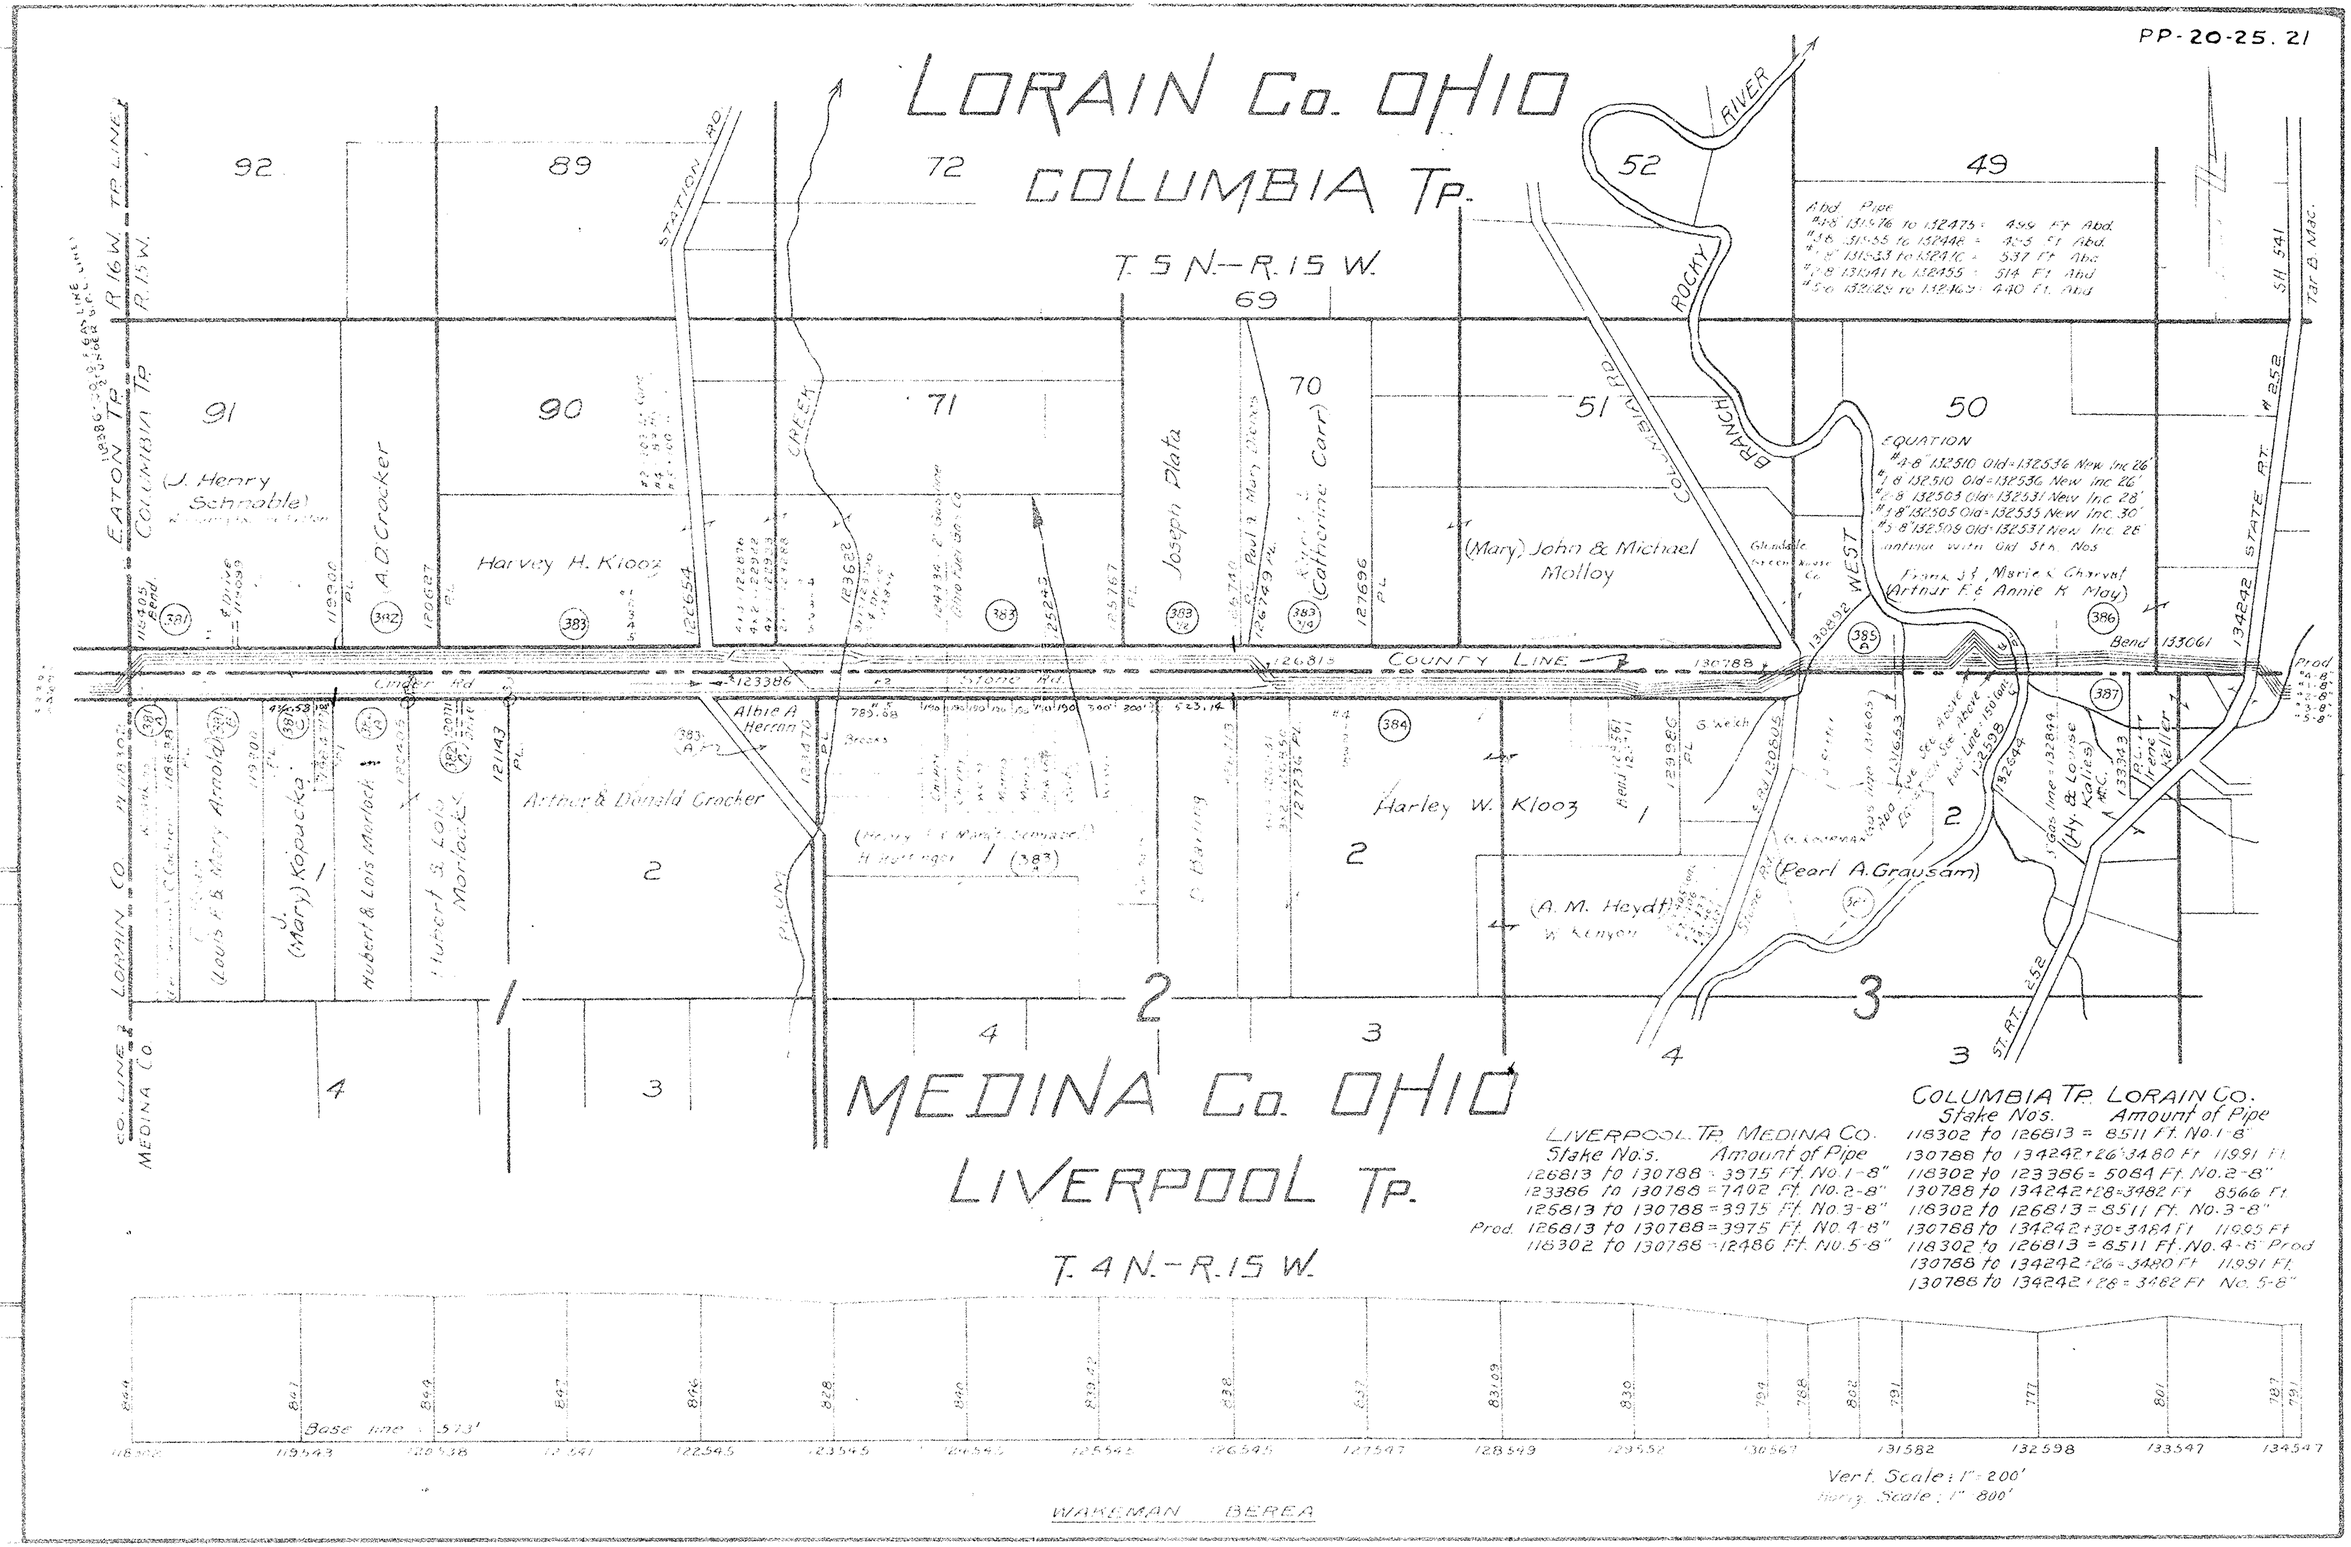

Abd.	Pipe		
#4-8	131576 to 132475 =	499	Ft Abd.
#5-8	131555 to 132448 =	423	Ft Abd.
#1-8	131533 to 132470 =	537	Ft Abd.
#3-8	131541 to 132455 =	514	Ft Abd.
#5-8	132129 to 132469 =	440	Ft. Abd.

EQUATION
#4-8 132510 Old = 132536 New Inc 26'
#1-8 132510 Old = 132536 New Inc 26'
#2-8 132503 Old = 132531 New Inc 28'
#3-8 132505 Old = 132535 New Inc 30'
#5-8 132509 Old = 132531 New Inc 28'
Continue with Old Sta. Nos.

LIVERPOOL Tp. MEDINA Co.

Stake No's.	Amount of Pipe
126813 to 130788 =	3975 Ft. No. 1-8"
123386 to 130788 =	7402 Ft. No. 2-8"
126813 to 130788 =	3975 Ft. No. 3-8"
Prod. 126813 to 130788 =	3975 Ft. No. 4-8"
118302 to 130788 =	12486 Ft. No. 5-8"

COLUMBIA Tp. LORAIN Co.

Stake Nos.	Amount of Pipe
118302 to 126813 =	8511 Ft. No. 1-8"
130788 to 134242+26=3480 Ft	11991 Ft
118302 to 123386 =	5084 Ft. No. 2-8"
130788 to 134242+28=3482 Ft	8566 Ft
118302 to 126813 =	8511 Ft. No. 3-8"
130788 to 134242+30=3484 Ft	11995 Ft
118302 to 126813 =	8511 Ft. No. 4-8" Prod
130788 to 134242+26=3480 Ft	11991 Ft.
130786 to 134242+28=3482 Ft	No. 5-8"

MADE
Revision By
Printing Date