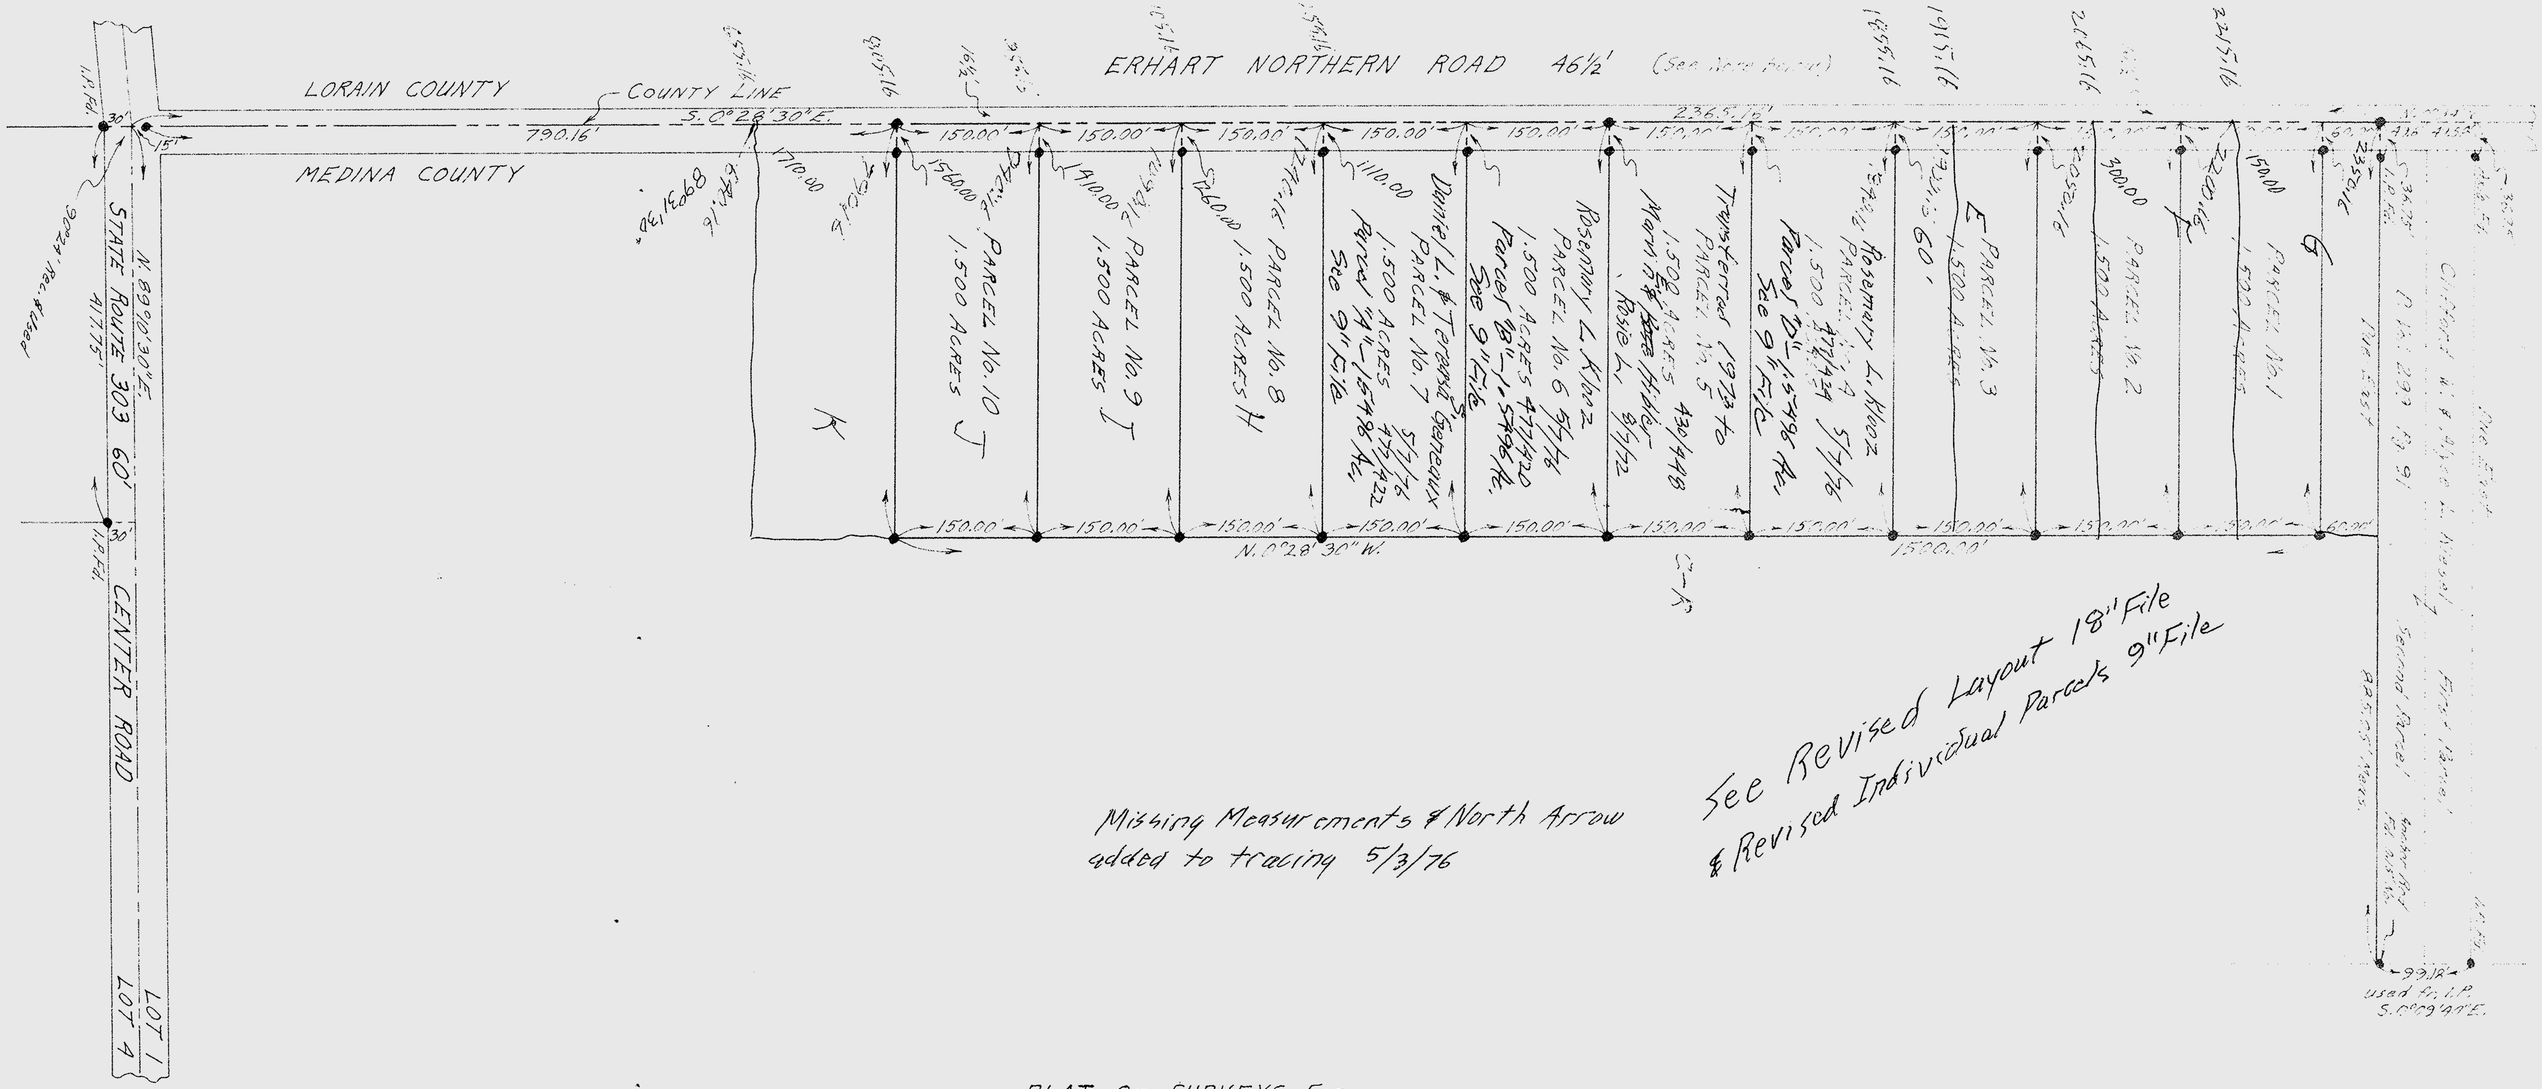
ERHART NORTHERN ROAD 46½'
LORAIN COUNTY
COUNTY LINE
MEDINA COUNTY
S. 0°28'30" E.
790.16'
STATE ROUTE 303 60'
CENTER ROAD
N. 89°00'30" E.
417.75'
LOT 1
LOT 4
PARCEL No. 10 J
1.500 ACRES
PARCEL No. 9 J
1.500 ACRES
PARCEL No. 8 H
1.500 ACRES
PARCEL No. 7 H
1.500 ACRES
Daniel L. & Teresa Greenlee
Parcel "H" 1.5748 Ac.
Rosemary L. Klooz
Parcel "B" 1.5748 Ac.
See 9" File
Rosemary L. Klooz
PARCEL No. 6 57/4
1.500 ACRES 43740
Parcel "B" 1.5748 Ac.
See 9" File
Warren & Rose Hilier
1.500 ACRES 43048
Transferred 1978 to
PARCEL No. 5
Parcel "D" 1.5748 Ac.
See 9" File
Rosemary L. Klooz
PARCEL No. 4 57/2
1.500 ACRES 47434
60'
PARCEL No. 3
1.500 ACRES
PARCEL No. 2
1.500 ACRES
PARCEL No. 1
1.500 ACRES
N. 0°28' 30" W.
150.00'
236.5'
1500.20'
430.43'
99.18'
used 4" I.P.
S. 0°09'00" E.
Clifford W. & Alice M. Wood
P.B. 293 Pg. 91
Second Parcel
Fred Bauer
Parcel No. 1
Parcel No. 2
Parcel No.