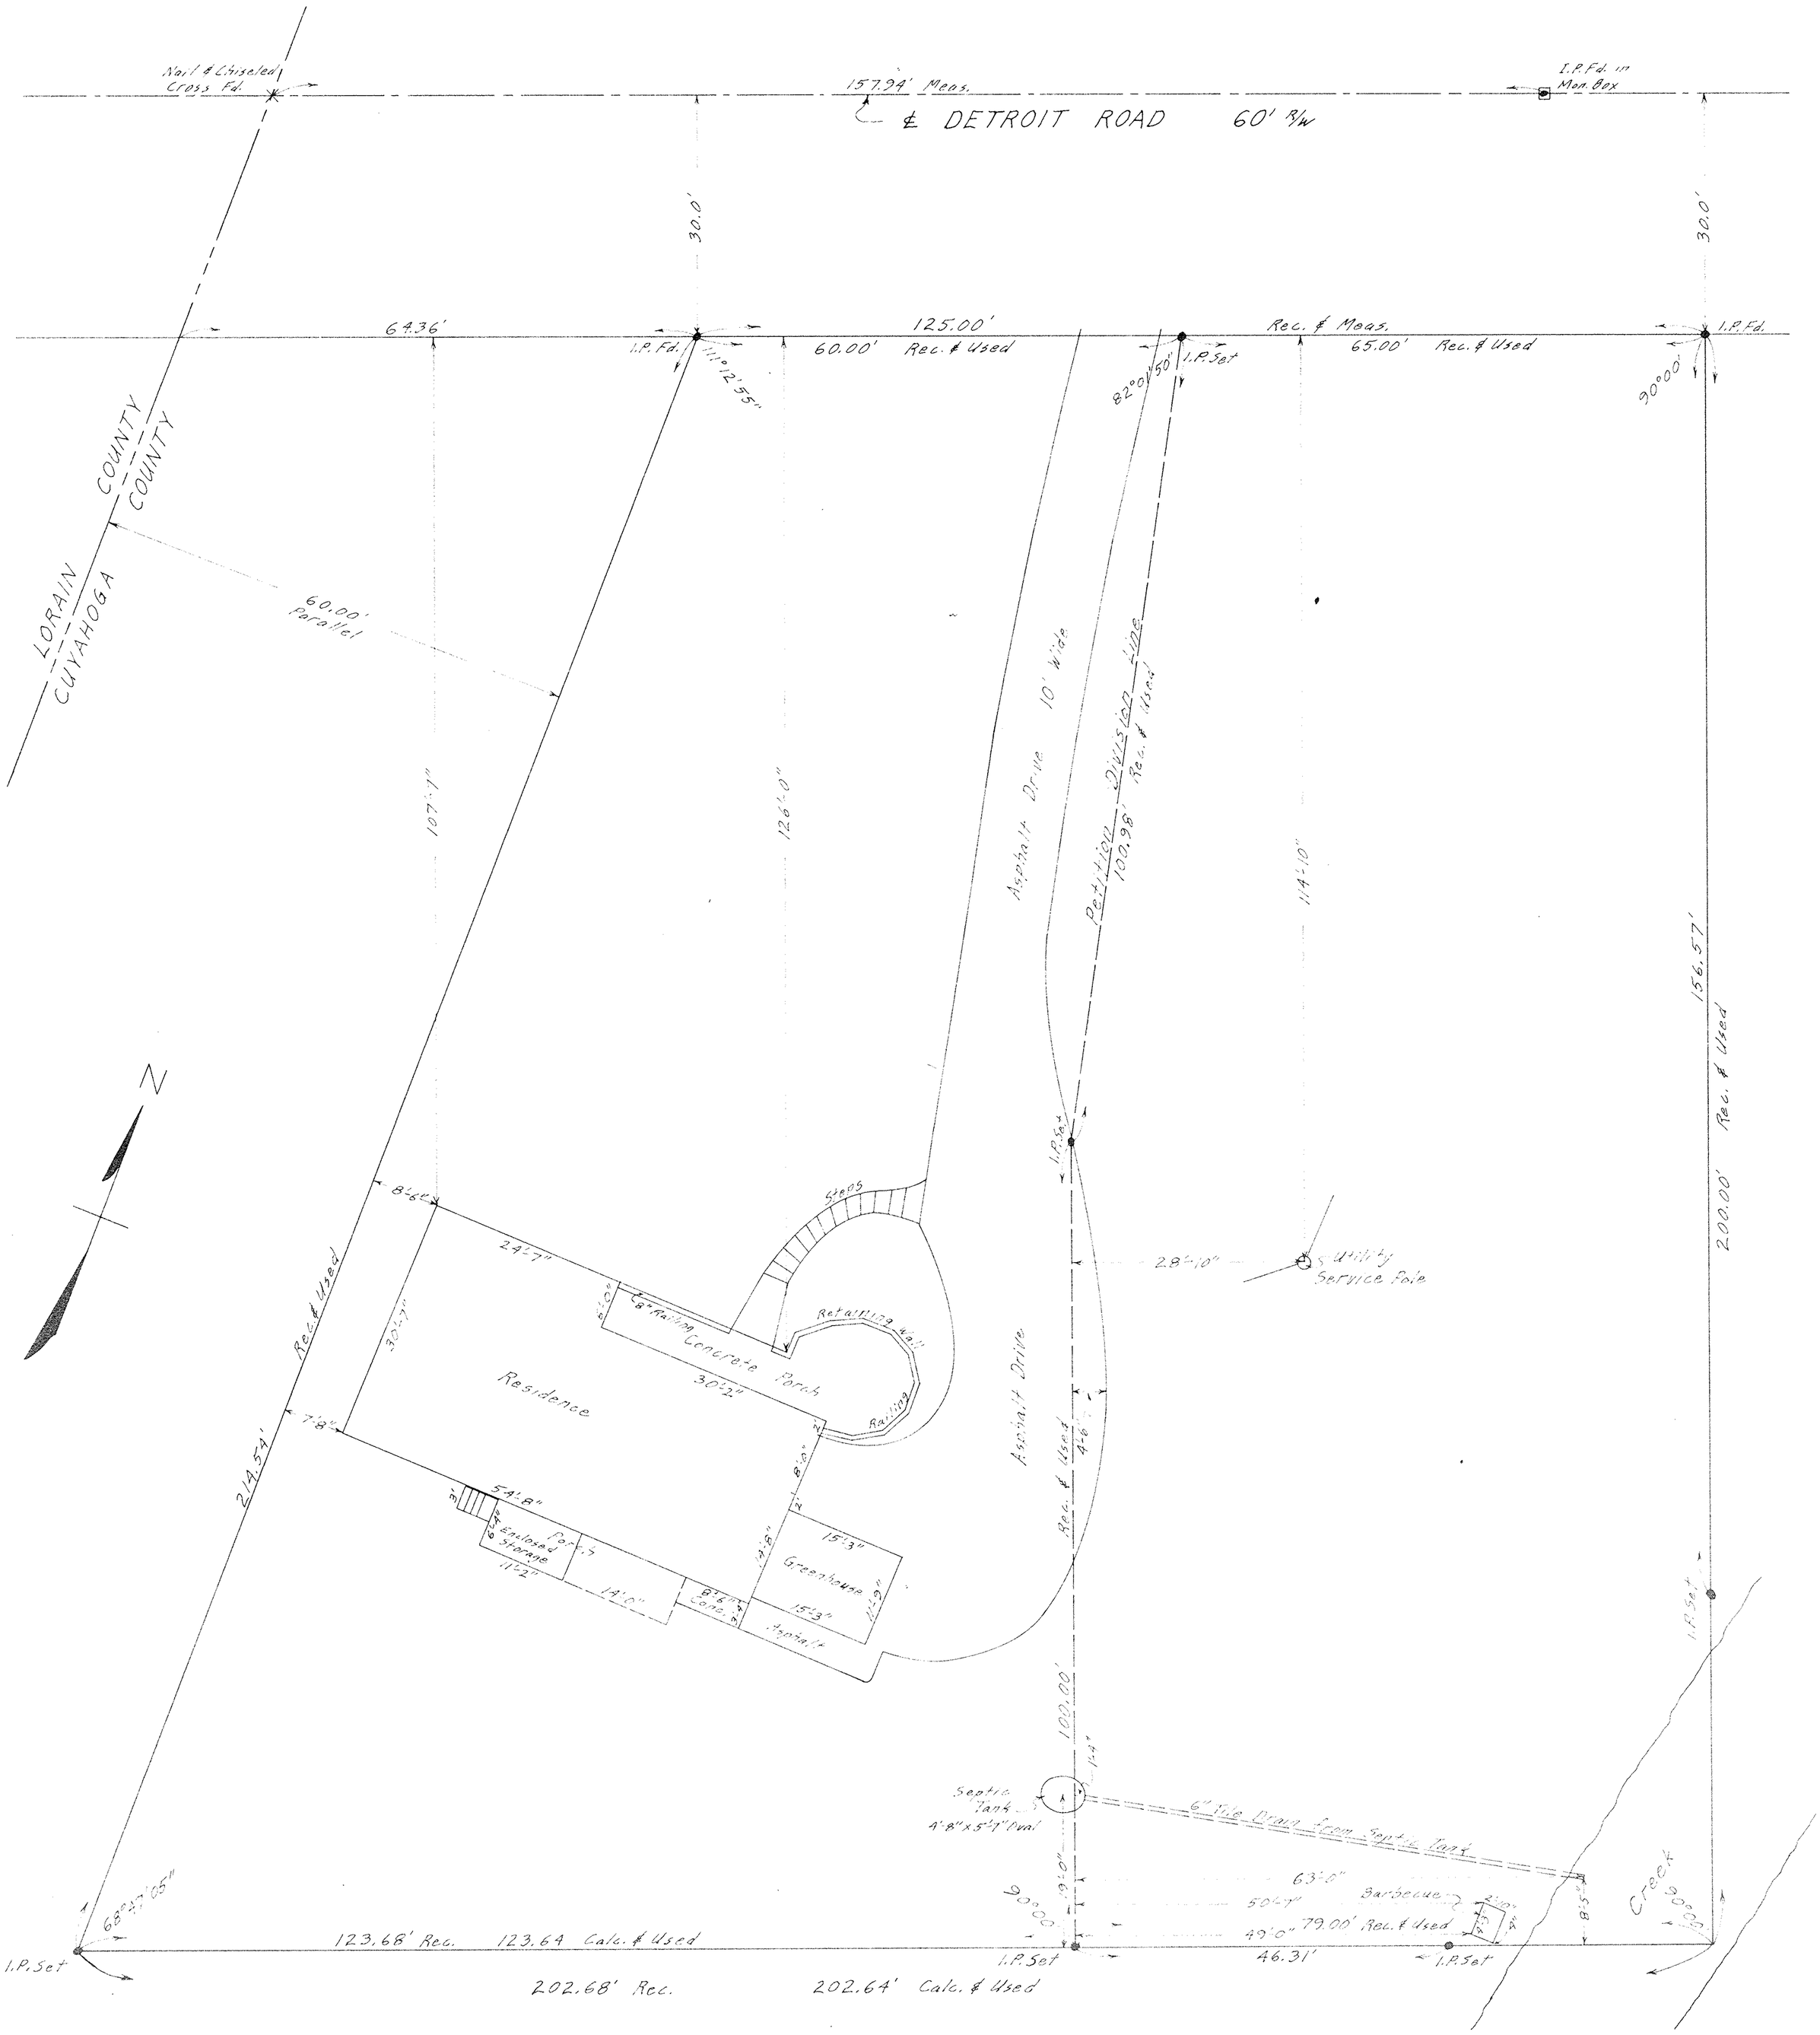

PLAT OF PROPERTY LINE AND TOPOGRAPHIC SURVEY FOR
RICHARD C. & SUSAN R. BAINBRIDGE

ORIGINAL LOT NO. 51 DOVER TOWNSHIP
WESTLAKE CITY CUYAHOGA COUNTY OHIO

SCALE: 1" = 10' NOVEMBER 1965

Gary E. Penfound Registered Surveyor No. 4457

Field Book 21 Pages 75 & 76

I hereby certify the above plat to be correct.
Gary E. Penfound