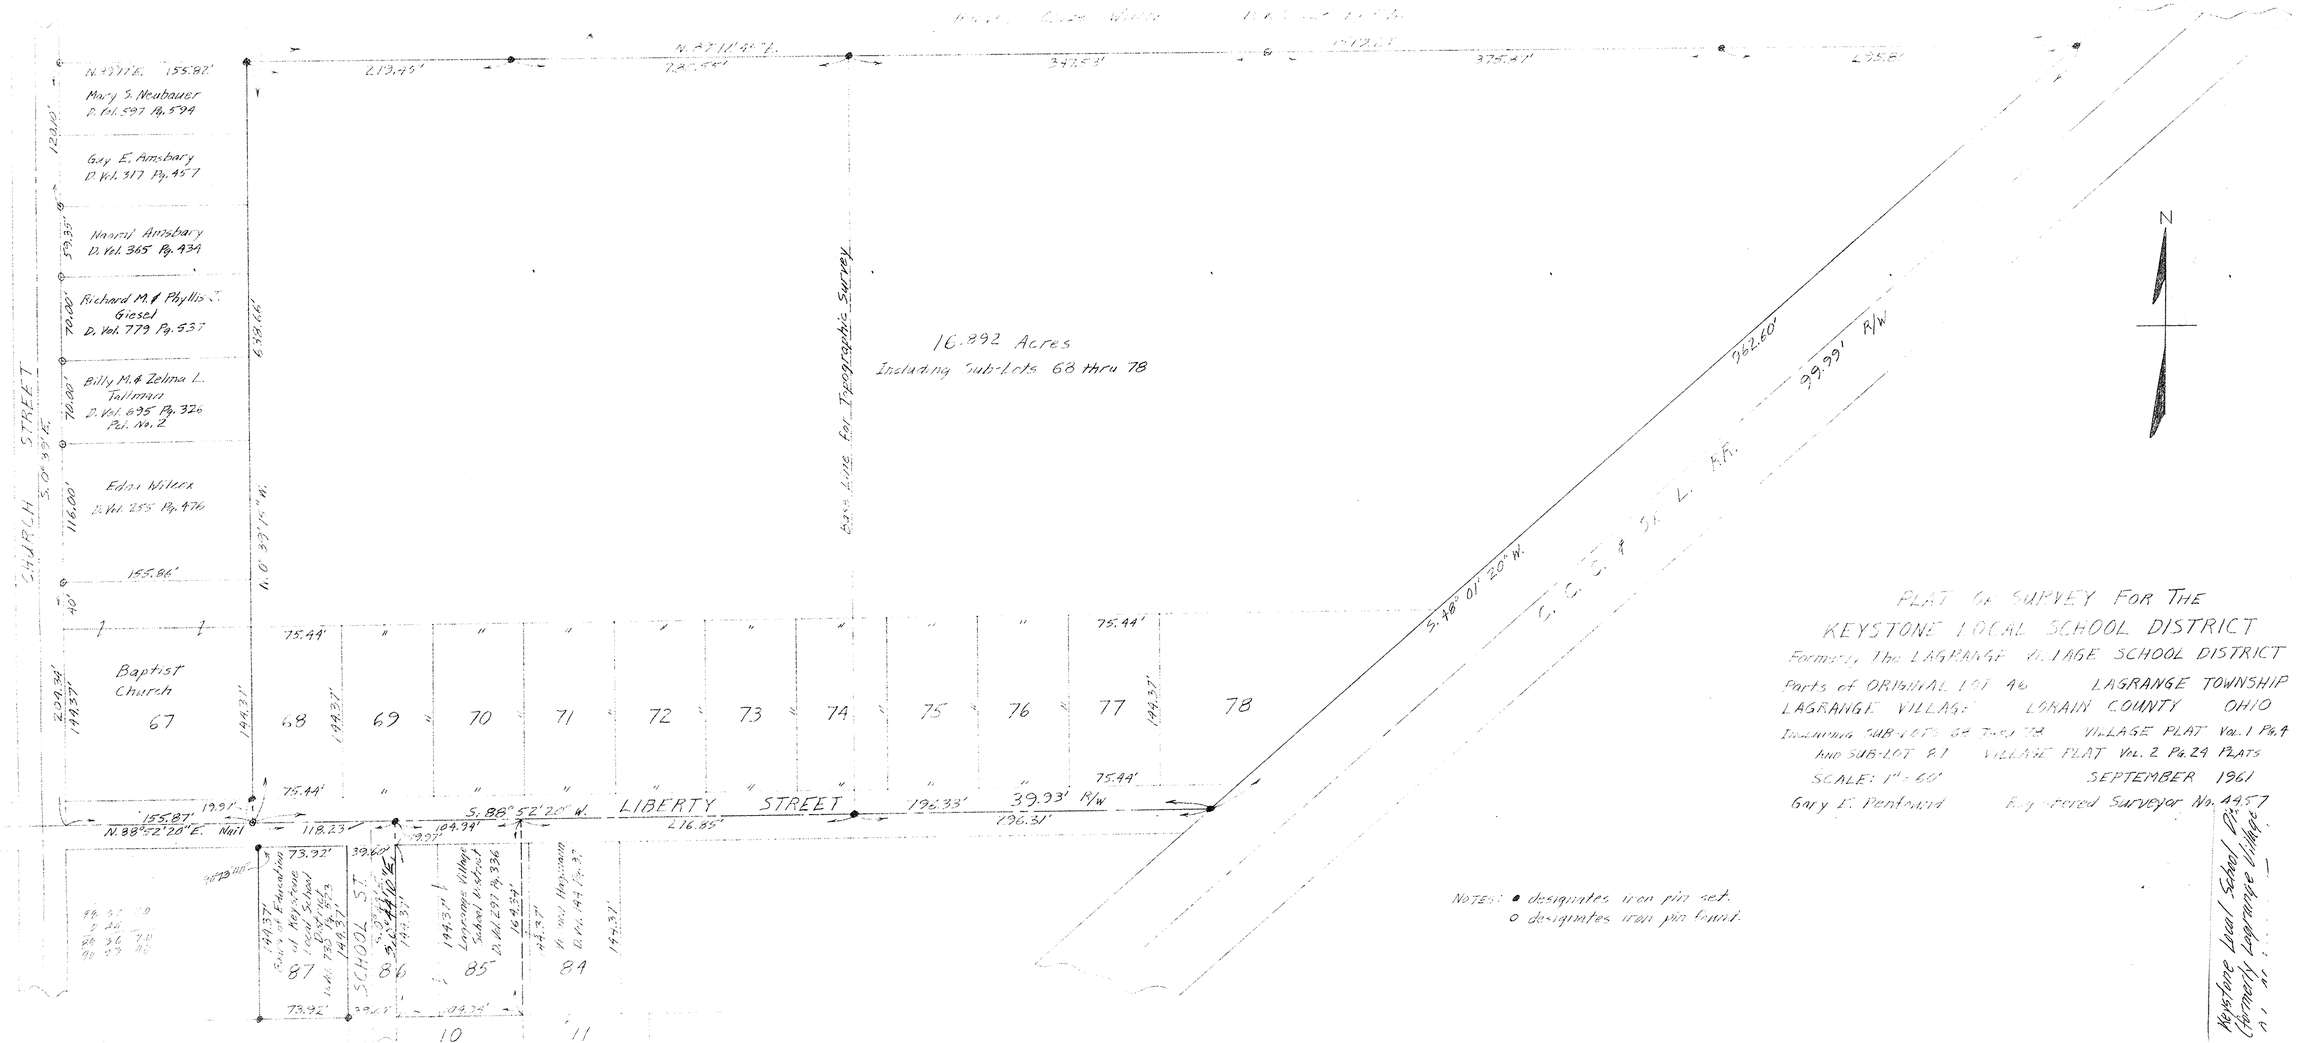

PLAT OF SURVEY FOR THE
KEYSTONE LOCAL SCHOOL DISTRICT
Formerly The LAGRANGE VILLAGE SCHOOL DISTRICT

Parts of ORIGINAL LOT 46 LAGRANGE TOWNSHIP
LAGRANGE VILLAGE LORAIN COUNTY OHIO
Including SUB-LOTS 68 THRU 78 VILLAGE PLAT Vol. 1 Pg. 4
AND SUB-LOT 81 VILLAGE PLAT Vol. 2 Pg. 29 PLATS

SCALE: 1" = 60' SEPTEMBER 1961

Gary E. Penfound Registered Surveyor No. 4457