# SUNRISE ALLOTMENT NO. 1

PART OF ORIGINAL LOT NO. 20 LAGRANGE TOWNSHIP

LORAIN COUNTY OHIO

SCALE: 1"=60' SEPTEMBER 1957

C. E. PENFOUND REGISTERED SURVEYOR

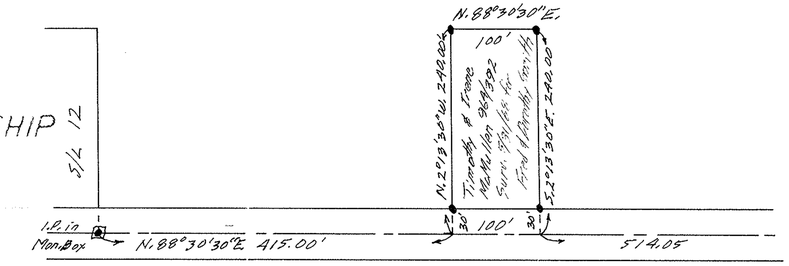


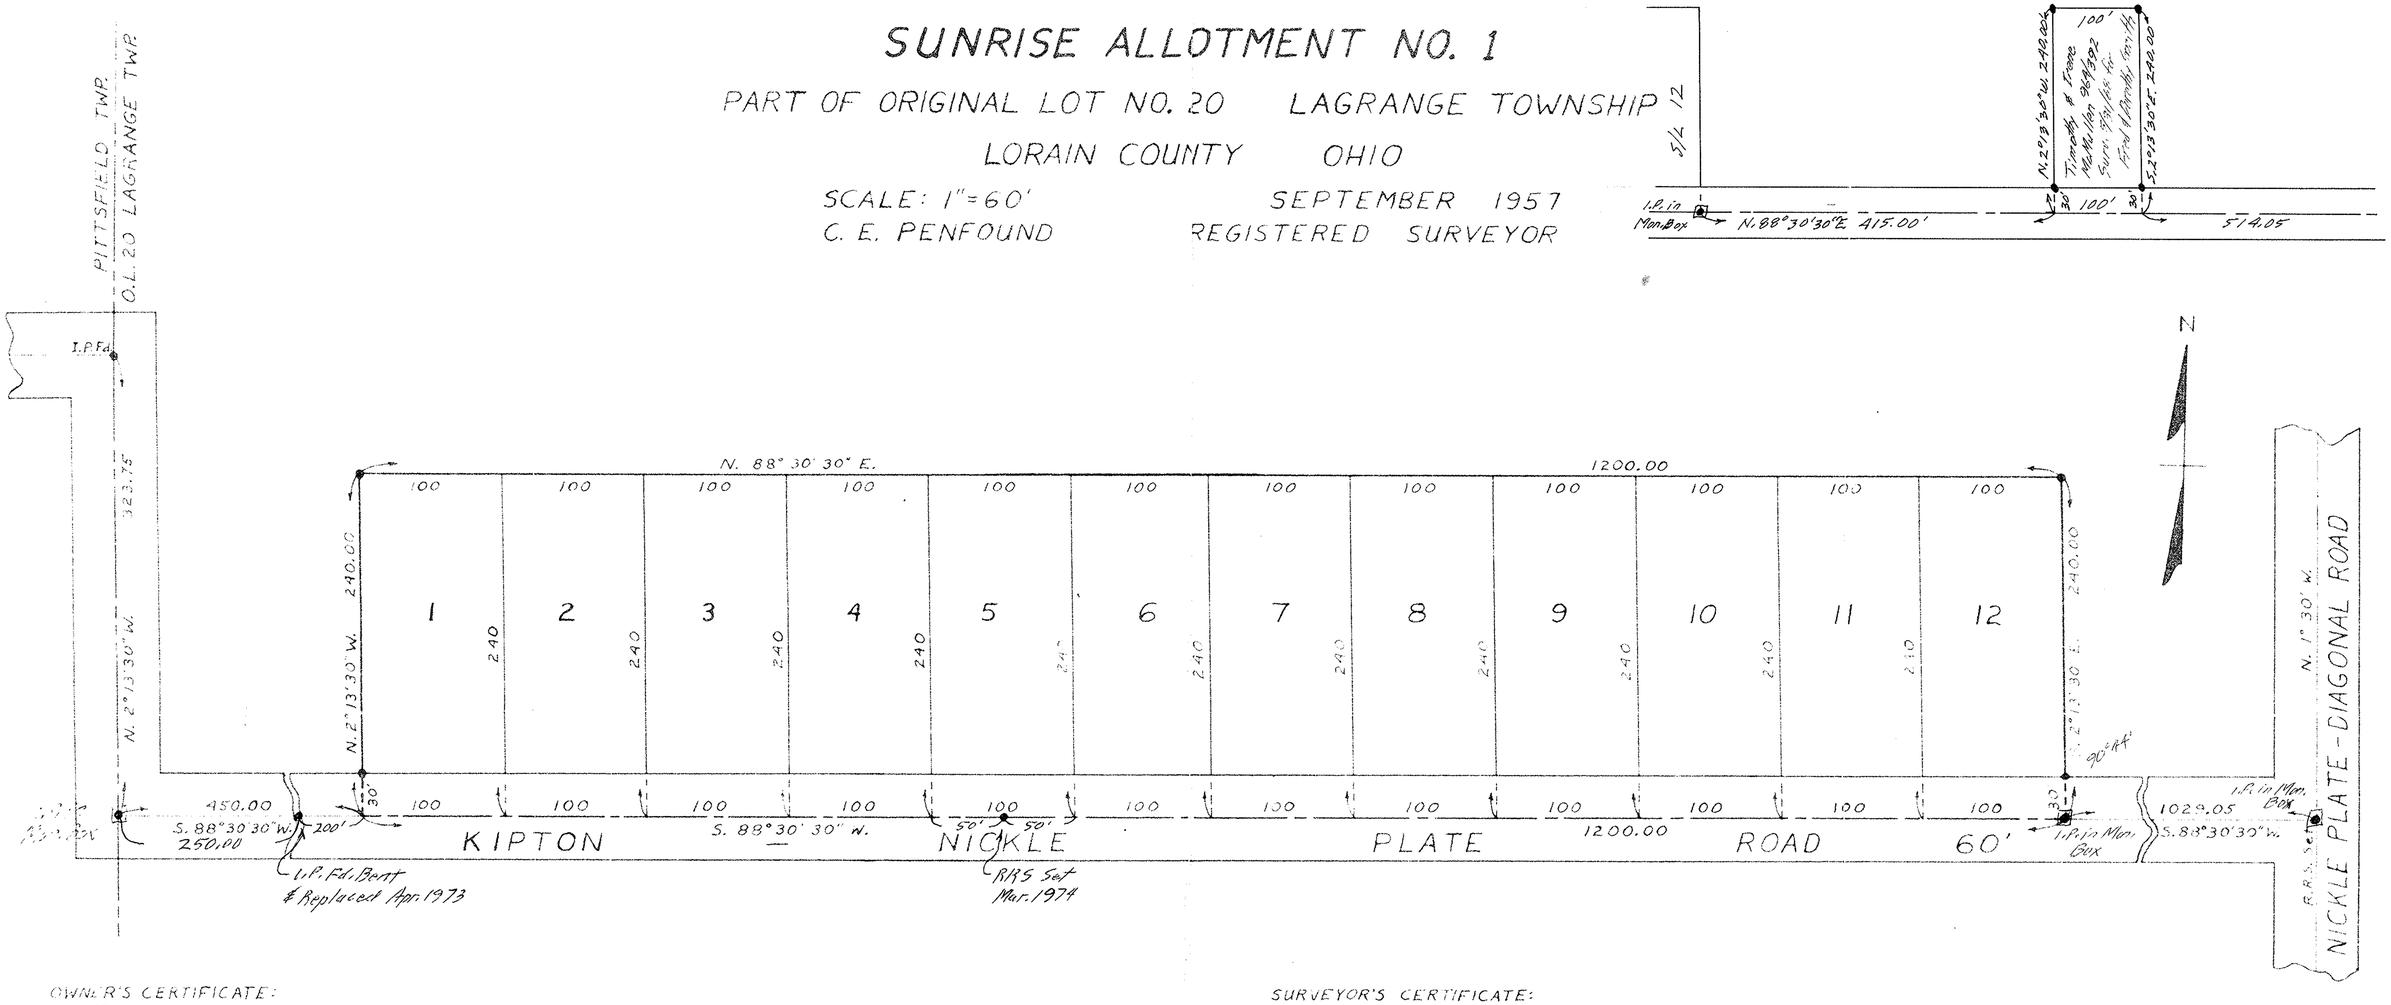


OWNER'S CERTIFICATE:

This is to certify that the undersigned Dorothy A. Smith, owner of the lands embraced by this plat of SUNRISE ALLOTMENT NO. 1, does hereby accept the same to be correct.

State of Ohio
County of Lorain S.S.:

Before me, a Notary Public in and for said County and State, personally appeared the above named Dorothy A. Smith, who acknowledged the signing of this plat to be her own free act and deed.

In witness whereof I have hereunto set my hand and official seal at _____, Ohio, on this _____ Day of _____, 1957.

_____ Notary Public

My Commission expires _____

This plat of SUNRISE ALLOTMENT NO. 1 is hereby approved by the ~~Board of County~~ Planning Commission~~ers~~ of ~~Lorain County,~~ Ohio, on this _____ Day of _____, 1957.

The City of Oberlin

President _____

Secretary ~~Clerk~~ _____

SURVEYOR'S CERTIFICATE:

This is to certify that at the request of the owner I have surveyed and platted SUNRISE ALLOTMENT NO. 1 as shown hereon. Distances are shown in feet and decimal parts thereof. Iron pin monuments were found or set as shown. Heavy black line indicates outline of plat. This plat embraces 6.6110 Acres of land in Original Lot No. 20 of Lagrange Township, inclusive of the land to the centerline of the Kipton Nickle Plate Road as shown hereon.

All of which I certify to be correct.

_____ Registered Surveyor No. 3200

This plat of SUNRISE ALLOTMENT NO. 1 is hereby approved by the Board of Trustees of Lagrange Township on this _____ Day of _____, 1957.

_____ Clerk _____

This plat of SUNRISE ALLOTMENT NO. 1 is hereby approved by the Zoning Board of Lagrange Township on this _____ Day of _____, 1957.

_____ Clerk _____