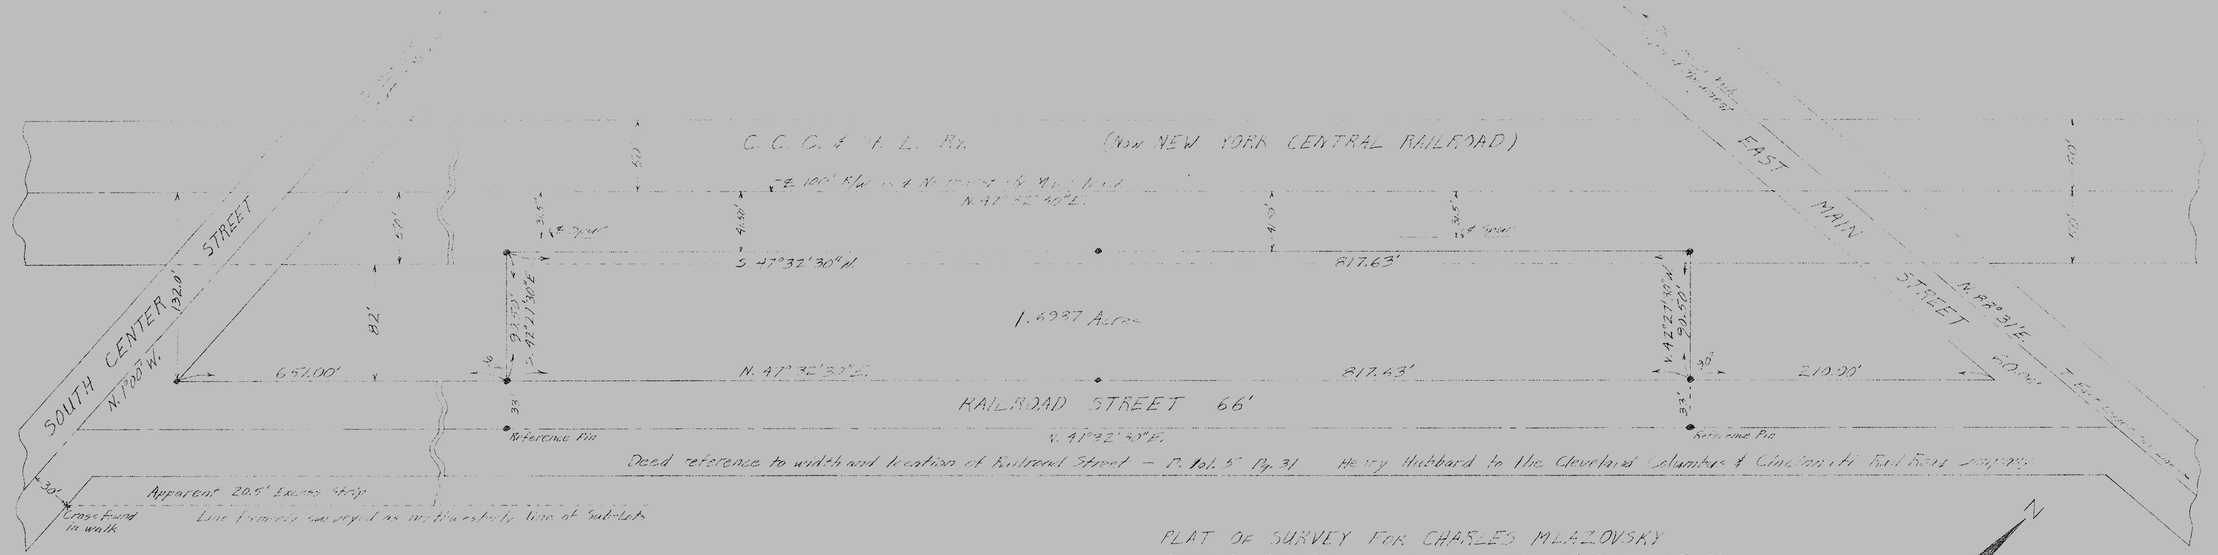

PLAT OF SURVEY FOR CHARLES MLAZOVSKY
PART OF RIGHT-OF-WAY OF NEW YORK CENTRAL R.R. CO.
ORIGINAL LOT 55 LAGRANGE TOWNSHIP
LAGRANGE VILLAGE LORAIN COUNTY OHIO
SCALE: 1" = 50' MARCH 1963
GARY E. FENFOUND REGISTERED SURVEYOR NO. 4457