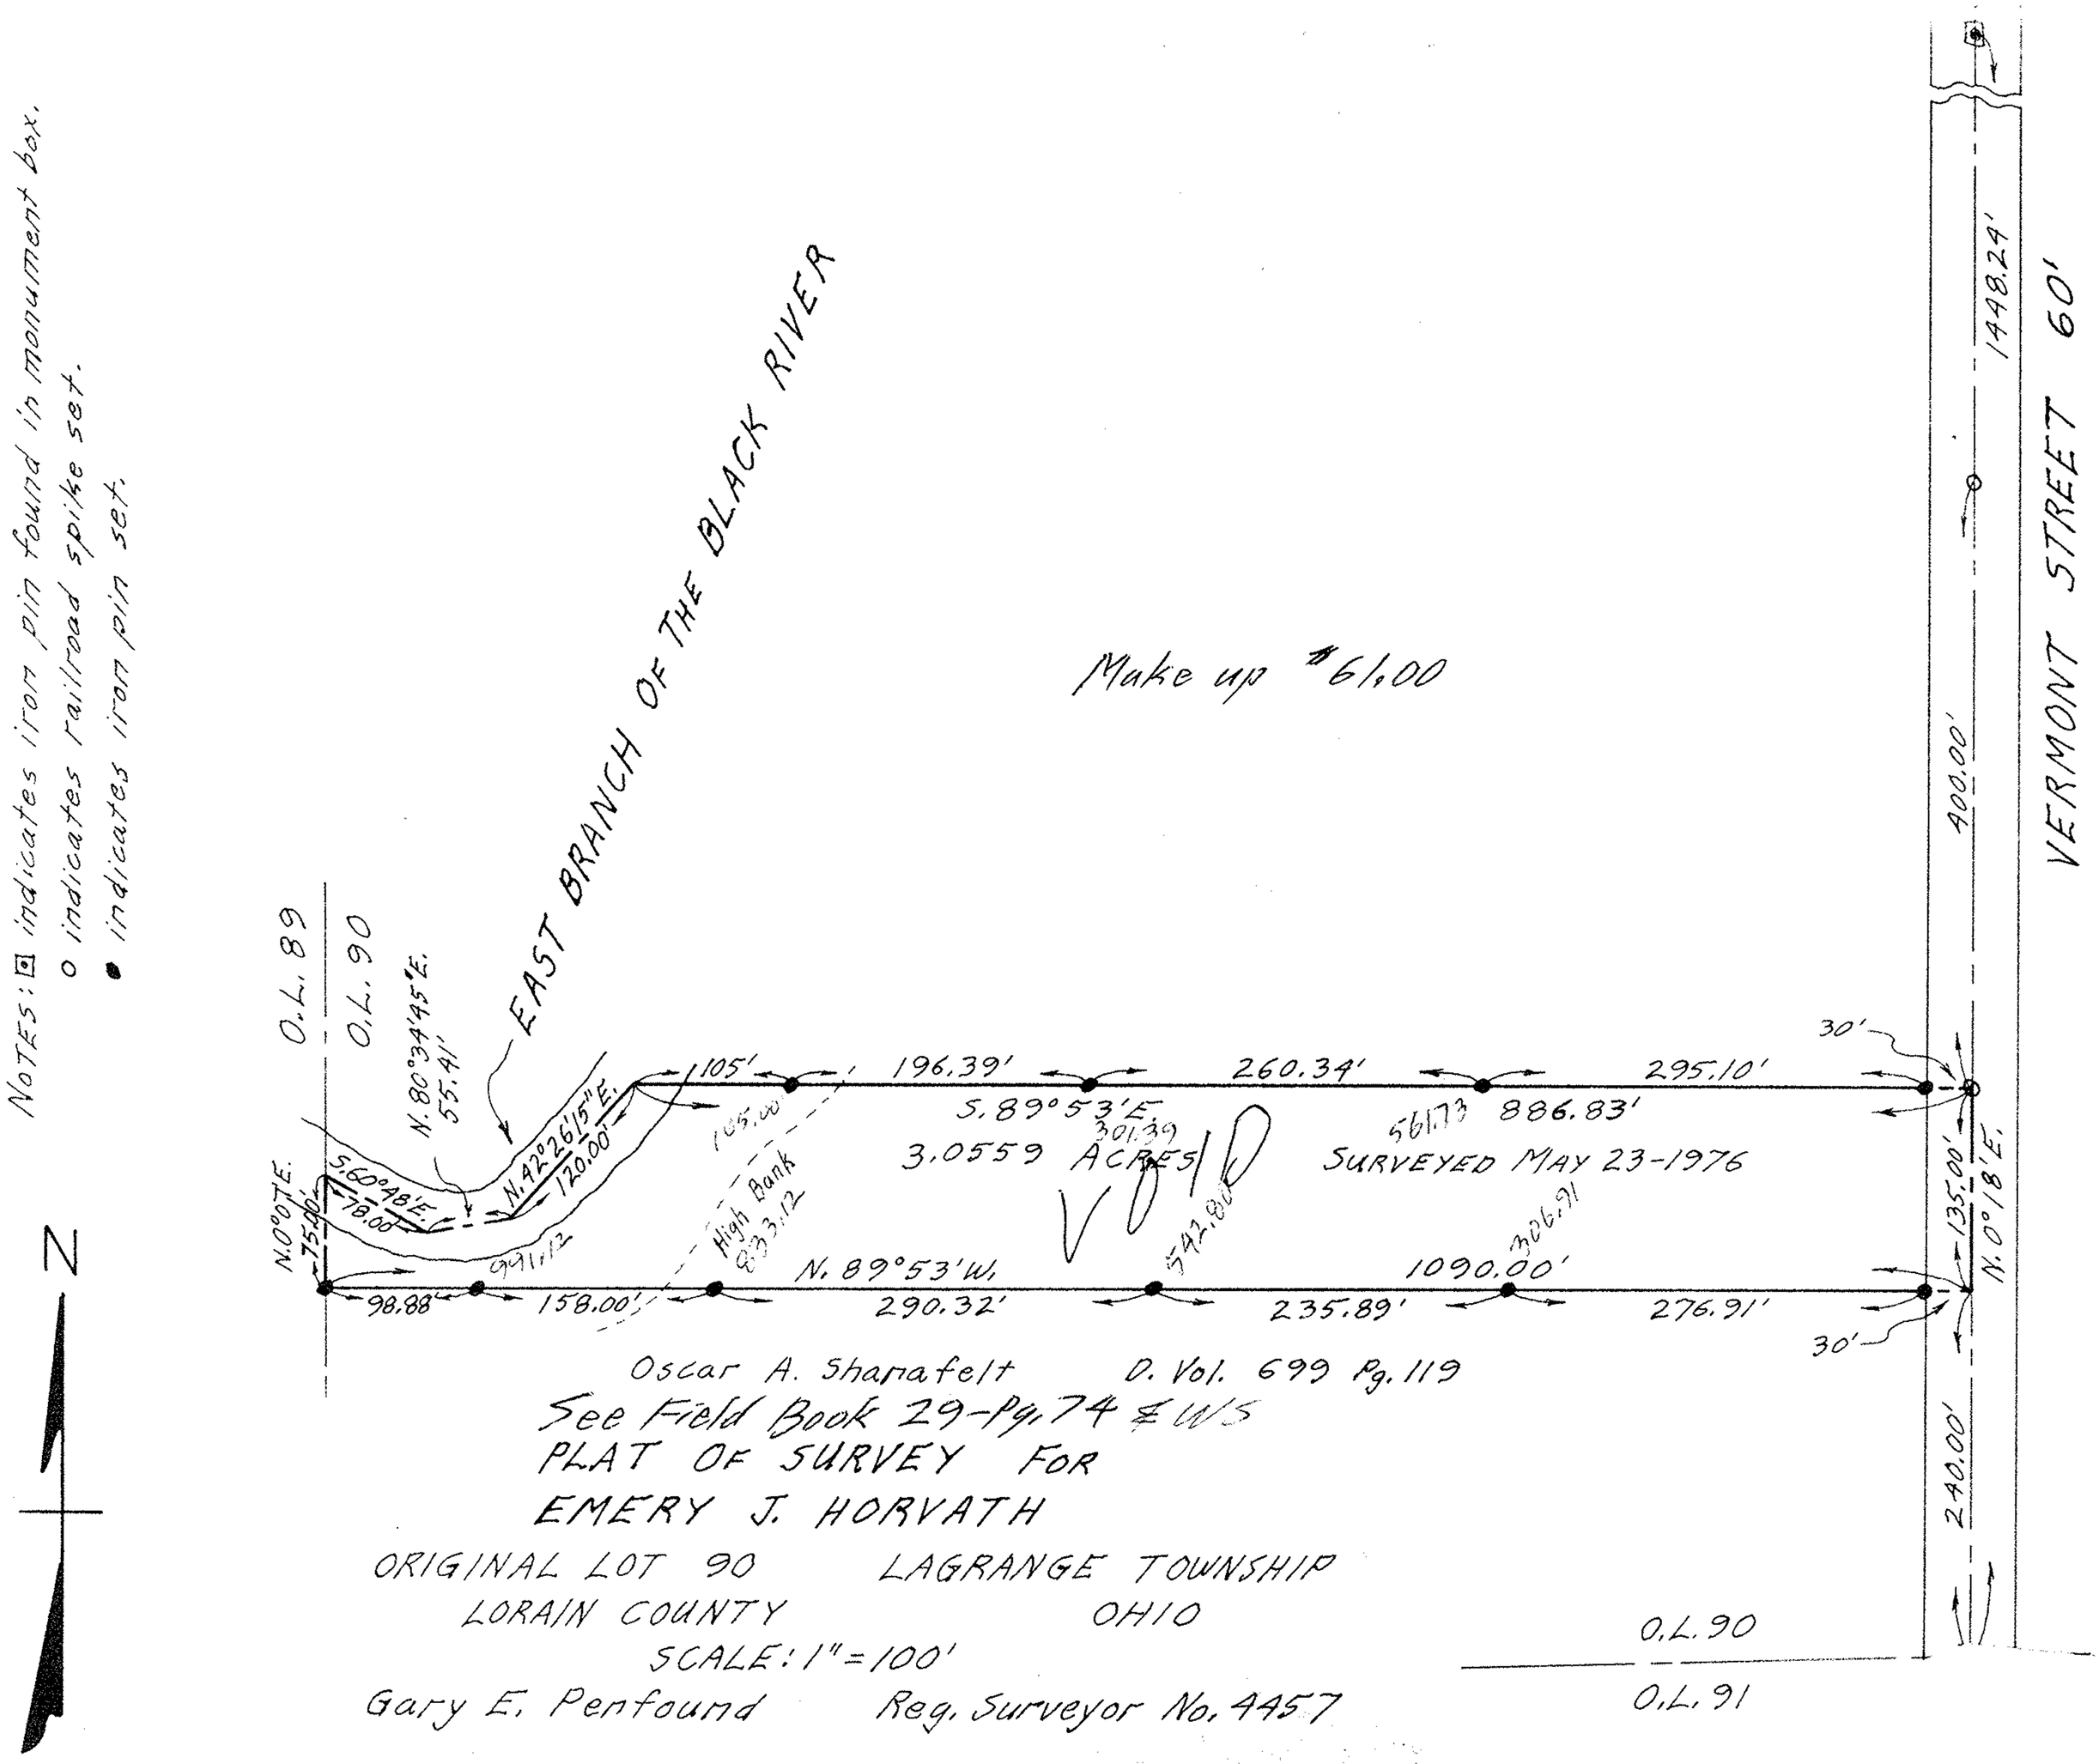
NOTES: ⊡ indicates iron pin found in monument box.
o indicates railroad spike set.
• indicates iron pin set.
N
EAST BRANCH OF THE BLACK RIVER
Make up $61.00
O.L. 89
O.L. 90
N.80°34'45"E.
55.41'
N.42°26'15"E.
120.00'
S.60°48'E.
78.00'
N.0°07'E.
75.00'
105'
196.39'
260.34'
295.10'
S.89°53'E.
886.83'
3.0559 ACRES
SURVEYED MAY 23-1976
High Bank
833.12
991.12
301.39
561.73
542.80
306.91
N.89°53'W.
1090.00'
98.88'
158.00'
290.32'
235.89'
276.91'
30'
30'
400.00'
1448.24'
135.00'
N.0°18'E.
240.00'
VERMONT STREET 60'
O.L. 90
O.L. 91
Oscar A. Sharafelt D. Vol. 699 Pg. 119
See Field Book 29-Pg. 74 & WS
PLAT OF SURVEY FOR
EMERY J. HORVATH
ORIGINAL LOT 90 LAGRANGE TOWNSHIP
LORAIN COUNTY OHIO
SCALE: 1"=100'
Gary E. Penfound Reg. Surveyor No. 4457