


- indicates iron pin set.
- indicates white stripe set in pavement.
- indicates location of high bank.
- - - indicates edge of wooded field.

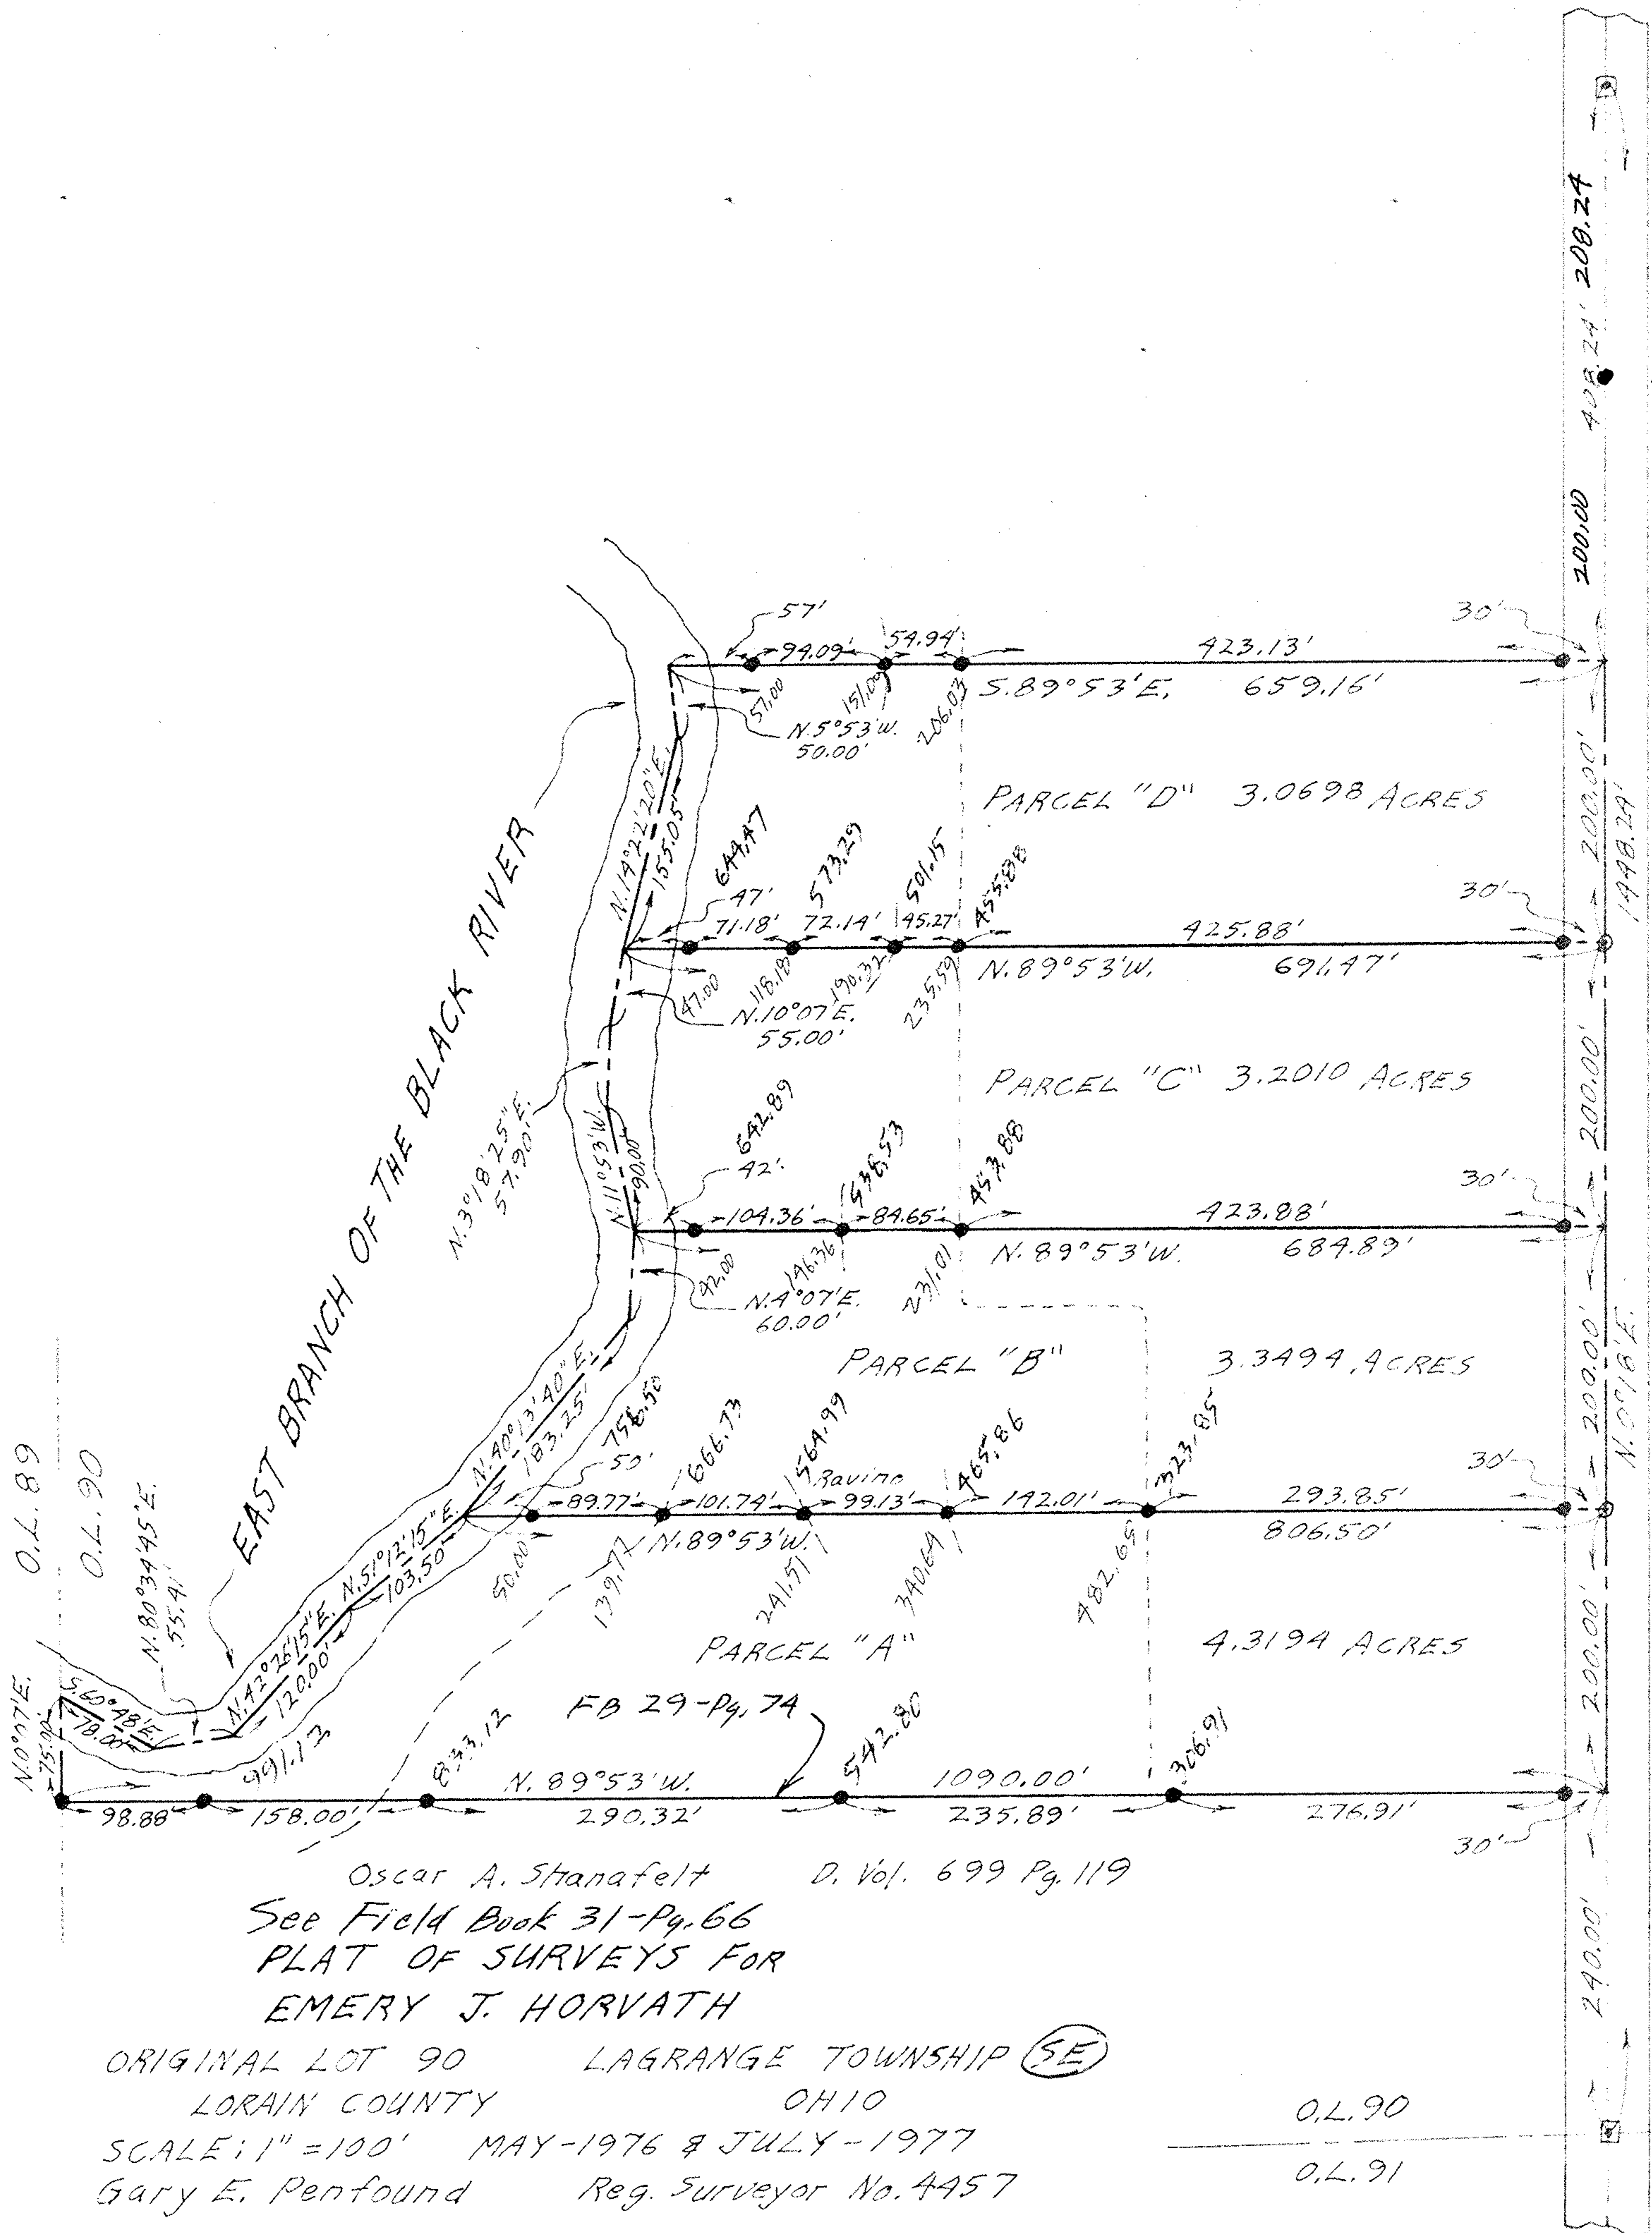

RRS Set