PLAT OF SURVEYS FOR
RUDOLPH & IRIS POGACSNIK
ORIGINAL LOT NO. 65 LAGRANGE TOWNSHIP
LORAIN COUNTY OHIO
SCALE: 1" = 100' FEBRUARY -- MARCH 1976
Gary E. Penfound Reg. Surveyor No. 4457
See Field Book 29 - Pgs. 58 & 59

See also 24" File
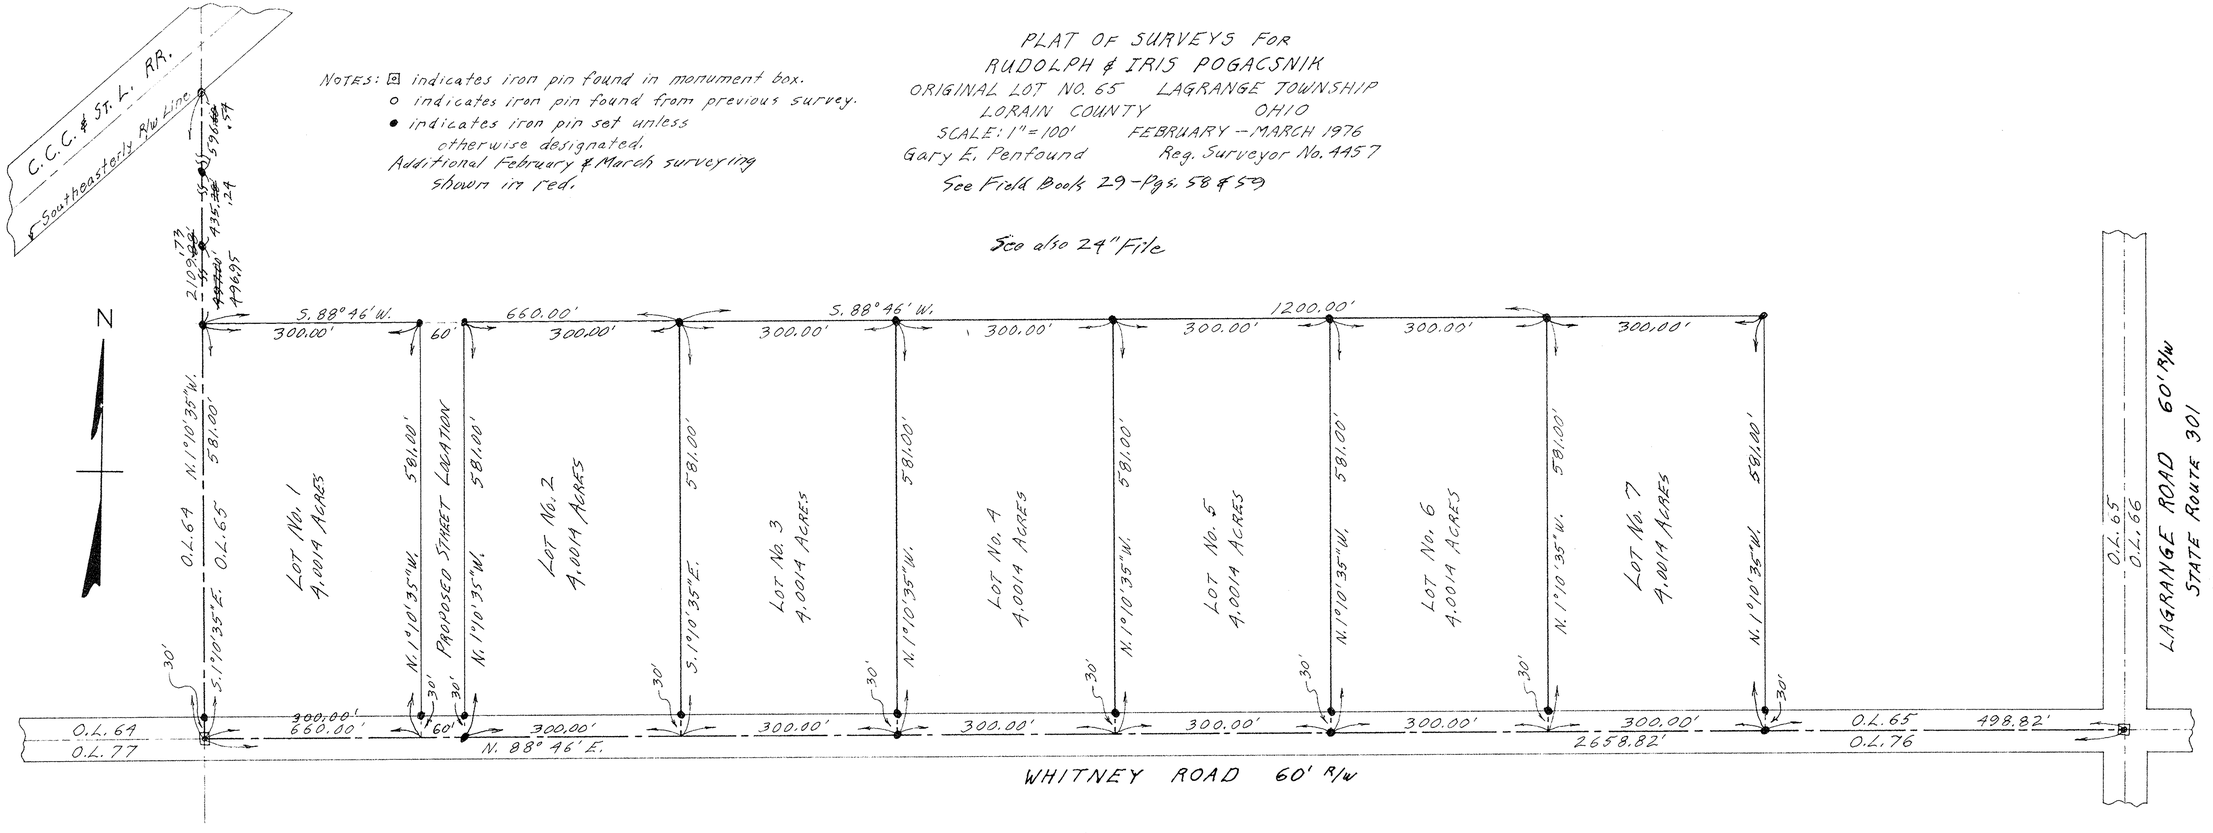
NOTES: ⊠ indicates iron pin found in monument box.
o indicates iron pin found from previous survey.
● indicates iron pin set unless otherwise designated.
Additional February & March surveying shown in red.