RECEIVED
LORAIN COUNTY
COMMISSIONERS

2005 OCT -7 P 3:15

THERESA L. UPTON
CLERK

P.P. NO. 14-00-026-000-002	
SPLIT # 05-001191-X	DATE OF SURVEY 9-22-02
MAP PAGE 14-B	
SURVEYOR Donald E. Himes	

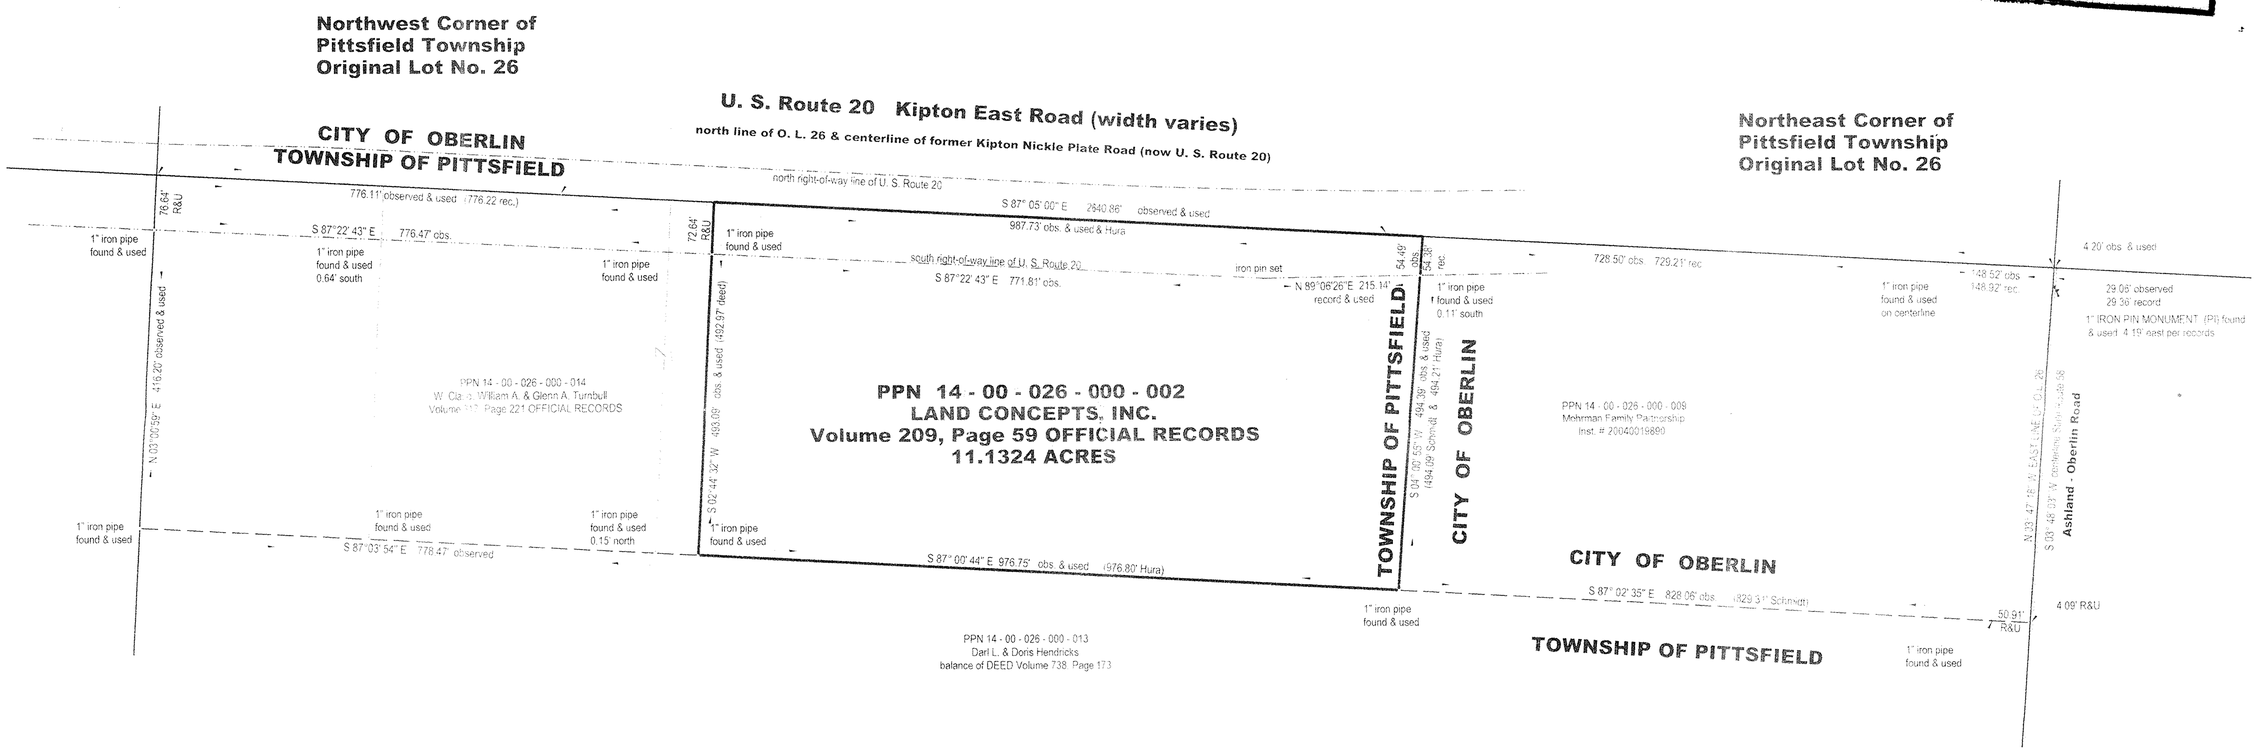

PRINTED
SEP 30 2005
ZWICK ASSOCIATES INC

NOTES & REFERENCES:

1) STATE OF OHIO, County of Lorain S. H. 886 Sec. A R/W PLANS sheets 9 &10 of 17 used to establish north & south right-of-way lines of KIPTON EAST ROAD , U. S. Route 20 (Oct. 1937)

2) STATE OF OHIO, County of Lorain State Route 58 Right-of Way Plans used (Nov. 1968)

3) 1985 boundary survey by Kleinoeder-Schmidt used

4) 1989 survey by N. R. Hura used

SCALE: 1" = 100'
0' 50' 100' 200'

I declare this plat to be a true representation of an actual field survey made by me in September, 2005. Distances are given in feet and decimal parts thereof. North datum used is the bearing of record for the north line of O. L. 26 and is for the purpose of describing angles only. Property corners were found or set as indicated. All iron pins set are 5/8-inch diameter rebar, 30 inches long, with "ZWICK" cap.

Donald E. Himes, Registered Surveyor No. 6163
September22, 2005

DONALD E. HIMES 6163 REGISTERED SURVEYOR

ZWICK ASSOCIATES, Inc.
Engineers - Surveyors - Planners
8750 Stearns Road, Olmsted Township, Ohio 44138-1743
tel: 440 - 235 - 2729 fax: 440 - 235 - 0604 E-mail: zwick@eng.ohiocoxmail.com

LAND CONCEPTS, Inc.
PLAT OF SURVEY FOR PROPOSED
ANNEXATION TO THE CITY OF OBERLIN
PART OF ORIGINAL PITTSFIELD TOWNSHIP Lot No. 26
COUNTY OF LORAIN, STATE OF OHIO

DEH	DEH	PDZ
September 2005		1" = 100'

T.M Pg 14-B