

SURVEY & LOT SPLIT FOR
RUSSELL NABAKOWSKI & RUDY YUHASZ

Part of Original Lot 6, Brownhelm Township, City of Vermilion, Lorain County, Ohio


February 1, 2003 Scale: 1" = 40'

P.A. Rosebeck & Associates - Registered Surveyor - 705 Willow Creek Dr., Amherst, OH 44001

Phone & Fax: 440-988-4657

#01563


APPROVED
LORAIN CO.
MAP DEPT.
DATE 1-8-04
PAGE 1-00-006A
BY R. MAINES
VOID
AFTER 03-01563

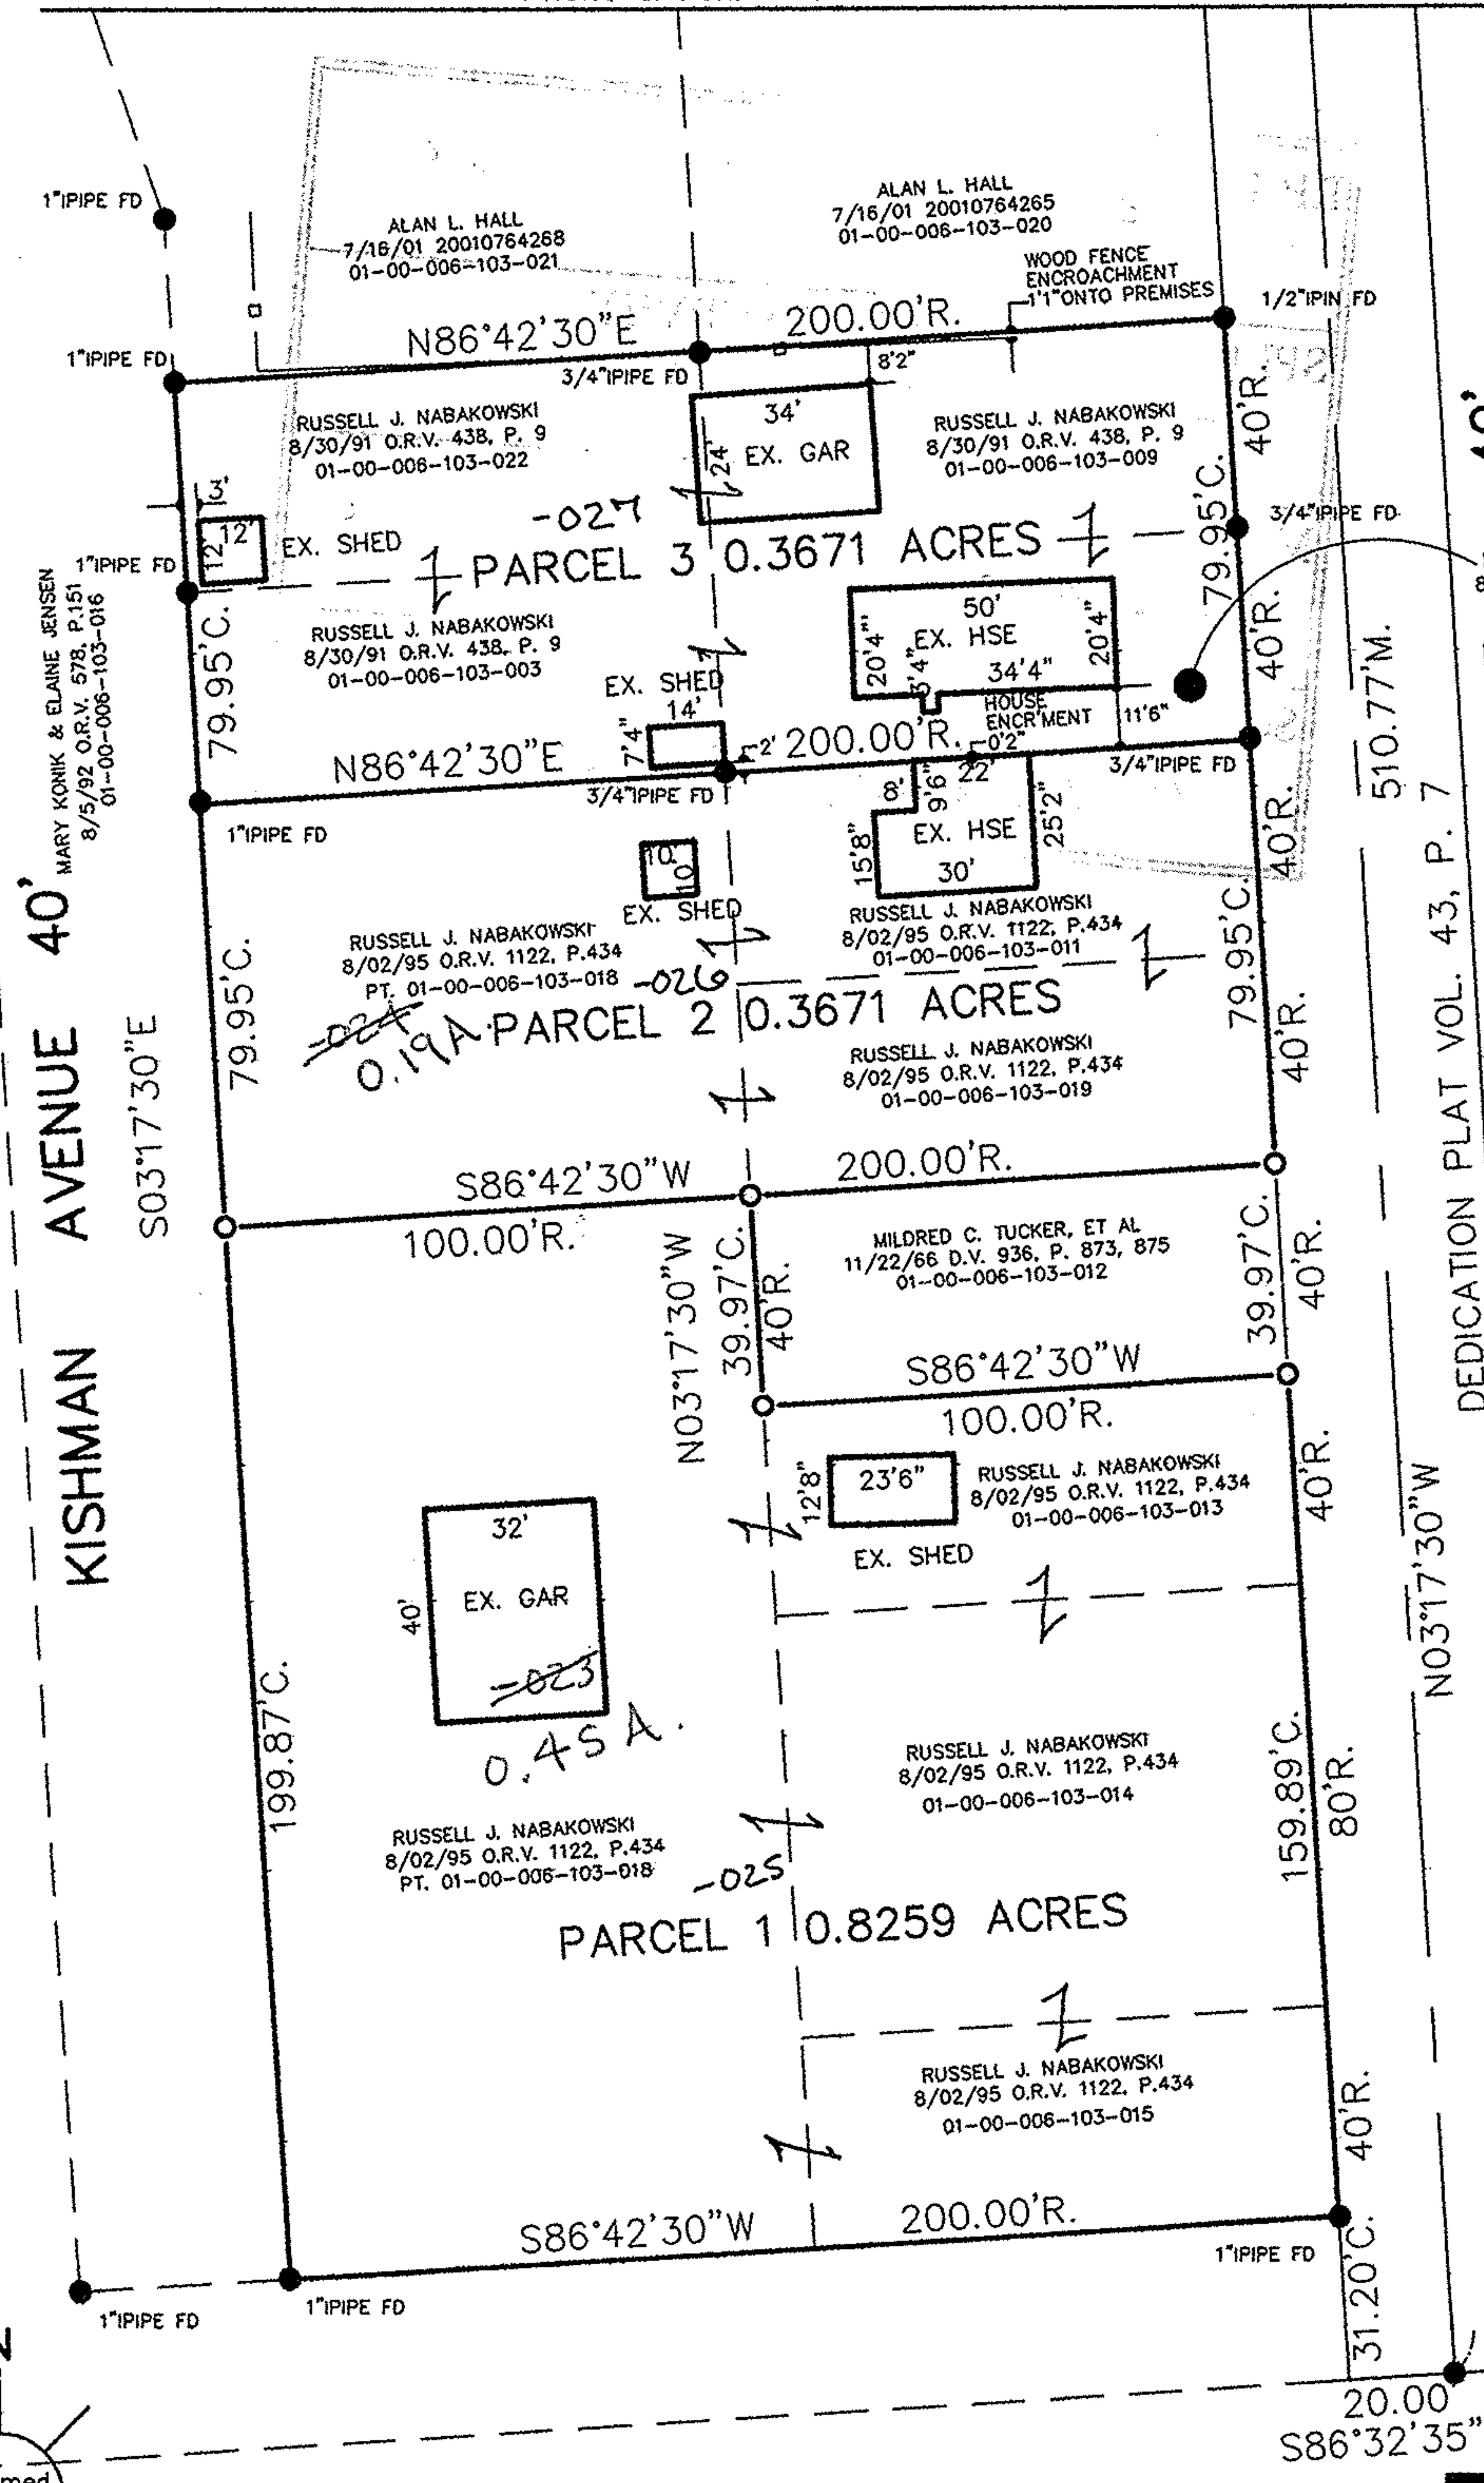


MARY KONIK & ELAINE JENSEN

KISHMAN AVENUE 40'
S03°17'30"E

40'
NICHOLSON AVENUE
DEDICATION PLAT VOL. 43, P. 7

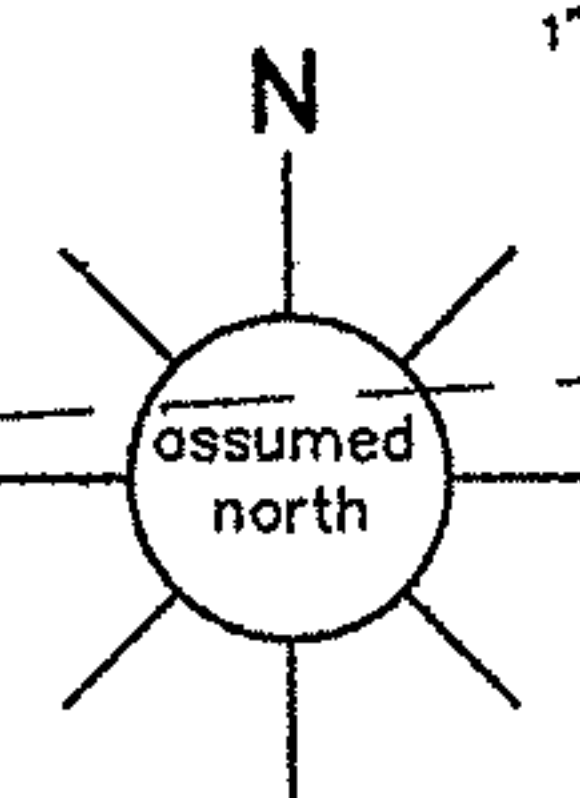

- LEGEND
- IRON PIN FOUND
 - IRON PIN SET

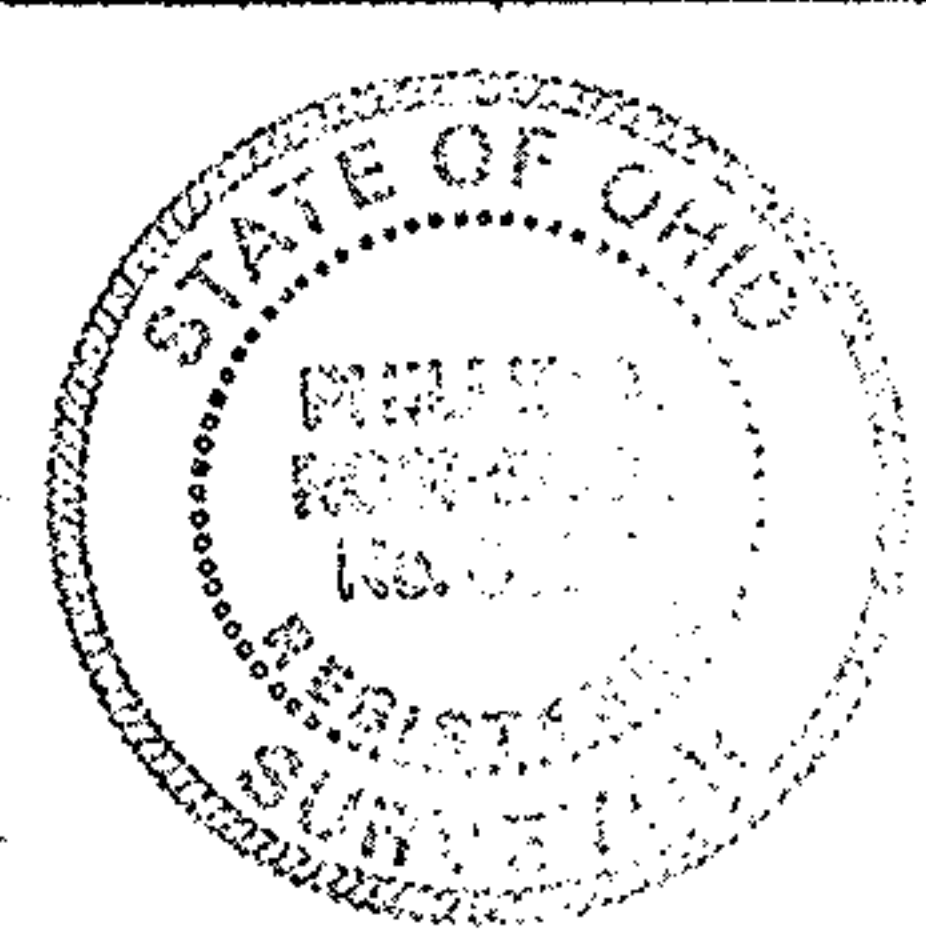

LOT 6, BROWNHELM TWP.,
LORAIN COUNTY, OHIO

file name:
yuhasz/nabakowski

I hereby certify the within to be a true representation of a survey
made by me on February 14, 2003.

[Signature]
Registered Surveyor No. 6696