


DESCRIPTION,  
REMAINING PARCEL:

SITUATED in the City of Vermilion, County of Lorain and State of Ohio. Being known as all of Sublots 92 and 109 and the easterly 7.94 feet of Sublots 91 and 110 of Sunnyside Beach Allotment as recorded in Volume 9, Page 17 of Plat Records, forming a parcel of land fronting 52.94 feet on Lorain Drive and extending southerly between lines perpendicular to Lorain Drive 199.15 feet on its westerly side and 195.39 feet on its easterly side to the northerly line of Amherst Drive, and having a frontage of 53.07 feet on Amherst Drive, but being subject to all legal highways.

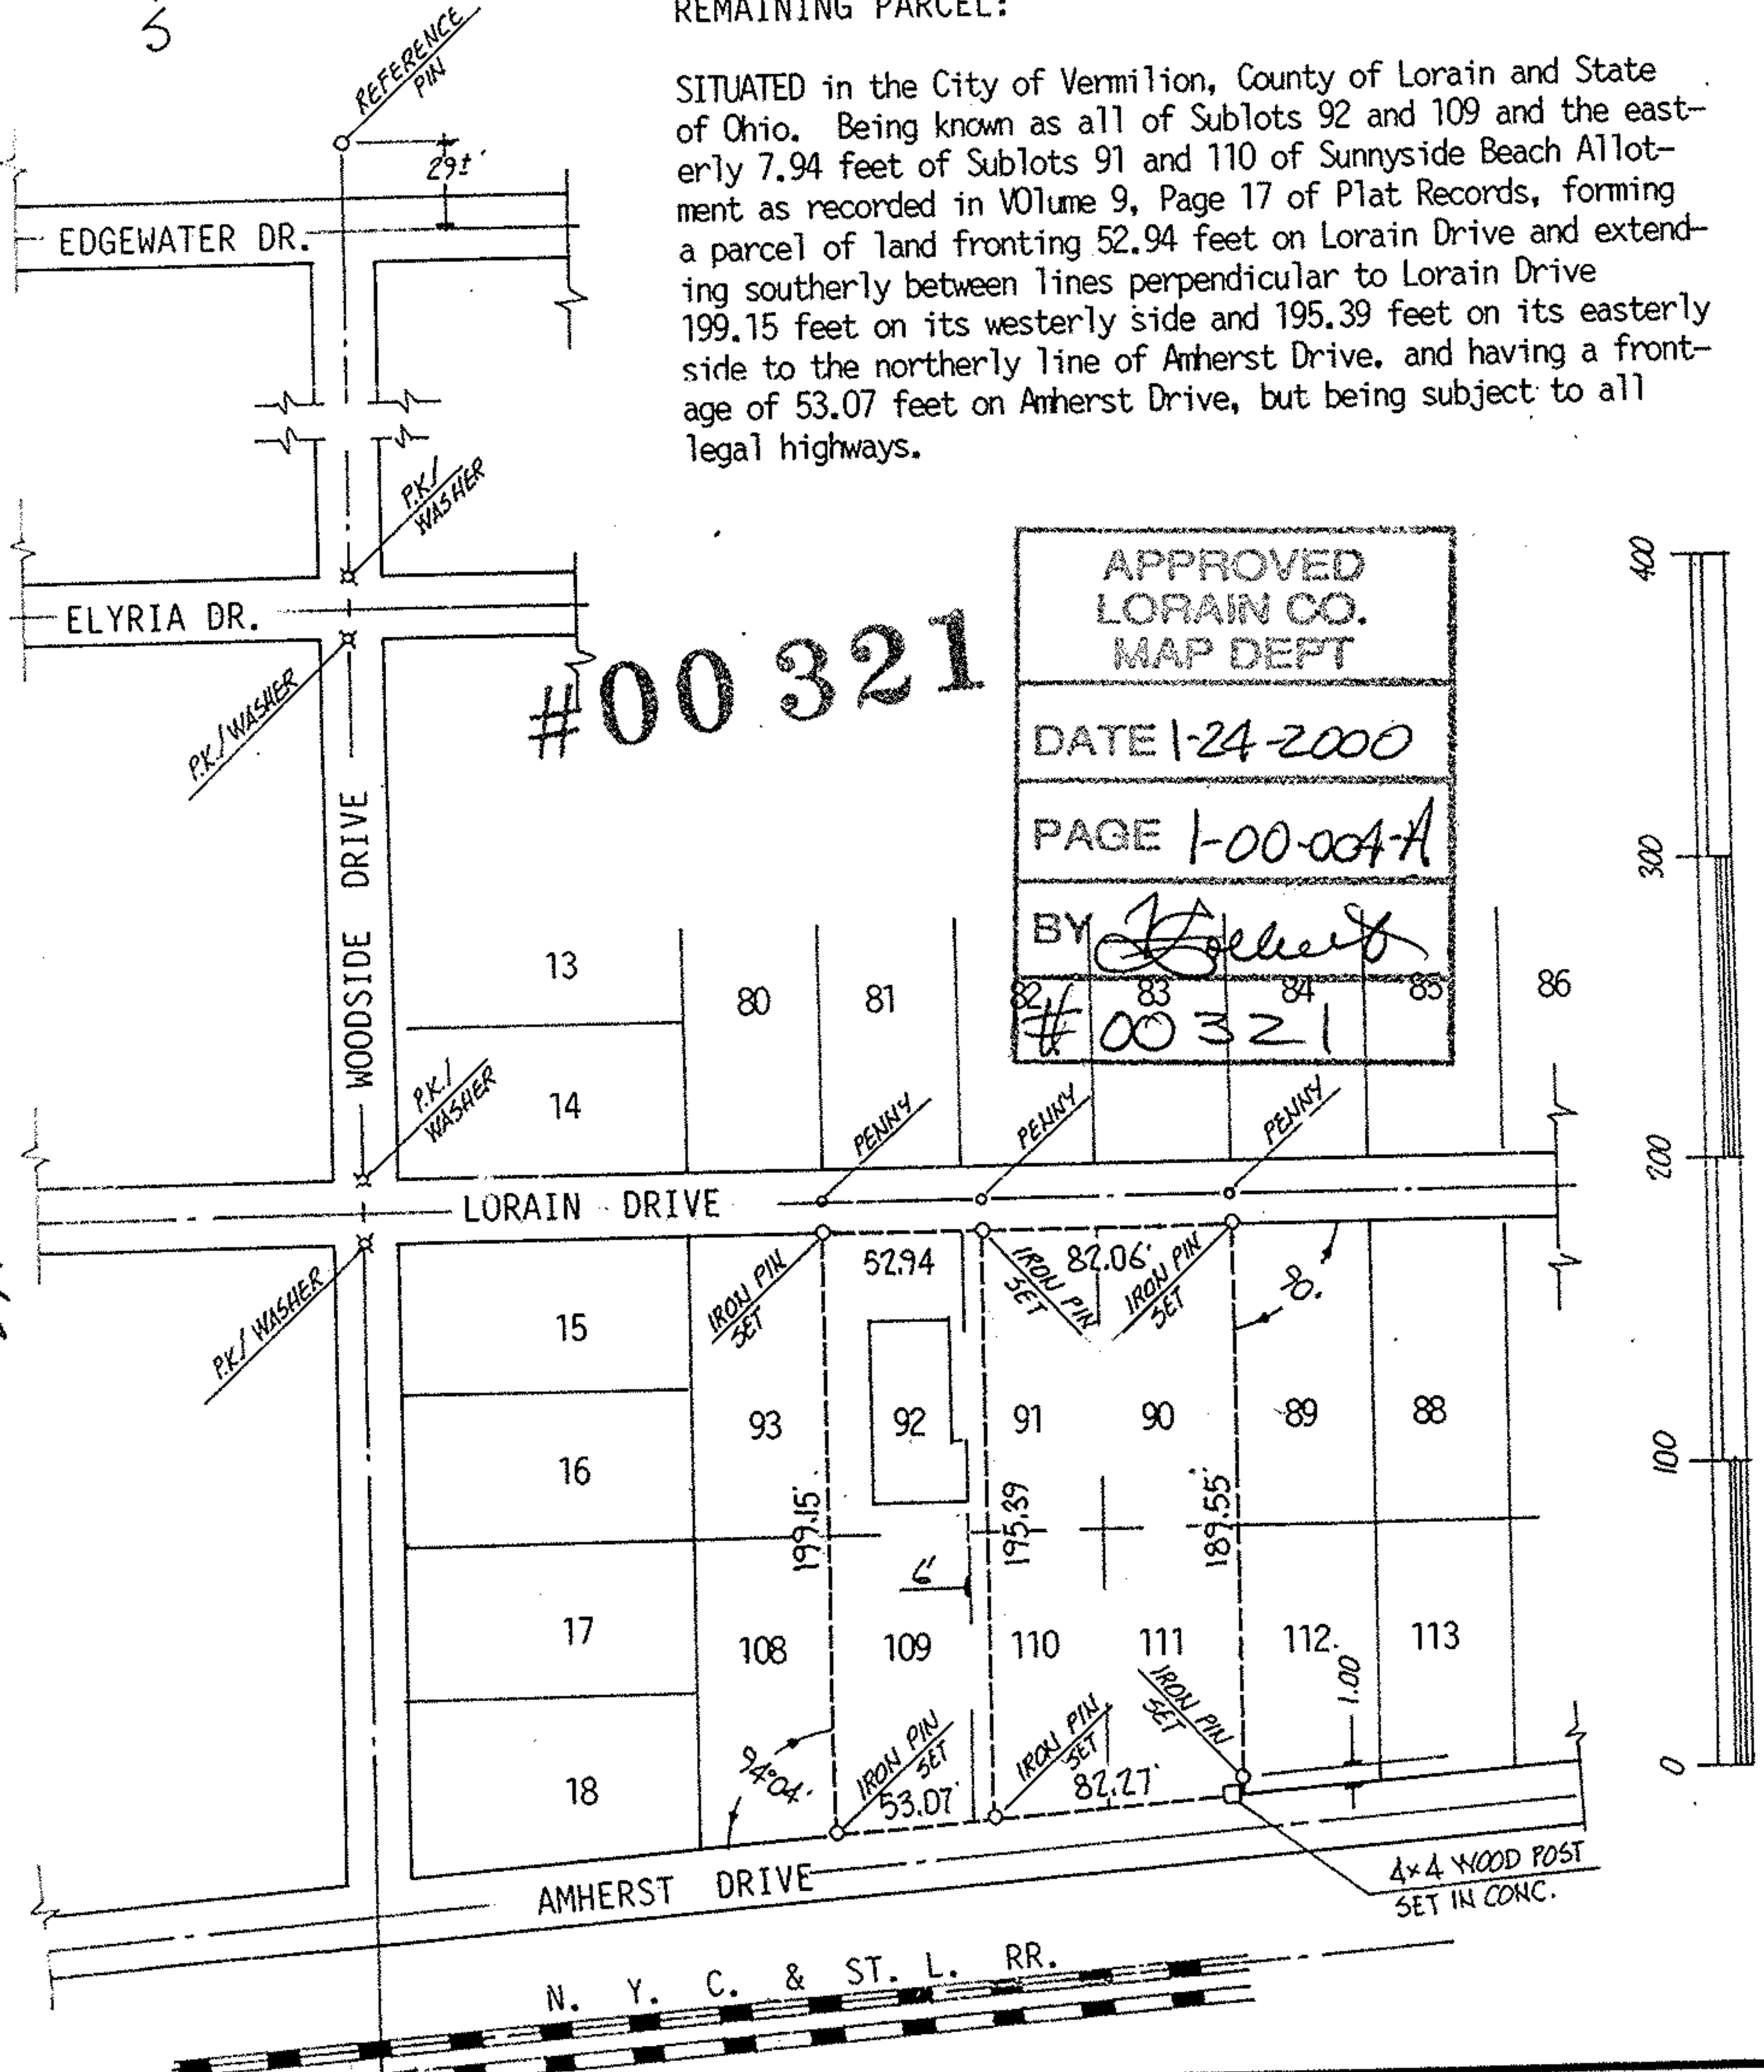

APPROVED  
LORAIN CO.  
MAP DEPT

DATE 1-24-2000

PAGE 1-00-004-A

BY *[Signature]*

# 00321

acreage NA  
date 09 NOV 99  
drawn MGH  
scale 1" = 80'

prepared for ANTHONY AUGUSTINE  
3219 LORAIN DRIVE

MICHAEL G. HURA, REGISTERED SURVEYOR  
12706 Mason Road, Vermilion Ohio (216)965-4040

**PERIMETER SURVEY**

SUBLOT(S) 90-91-92-109-110-111 OF SUNNYSIDE  
BEACH ALLOT. Volume 9 Page 17 of PLATS  
PART of O.L. \_\_\_\_\_ Tract \_\_\_\_\_ Section \_\_\_\_\_ of  
BROWNHELM TOWNSHIP LORAIN CO., OHIO



City of VERMILION  
Village of \_\_\_\_\_