


NORTH
SCALE: 1"=20'

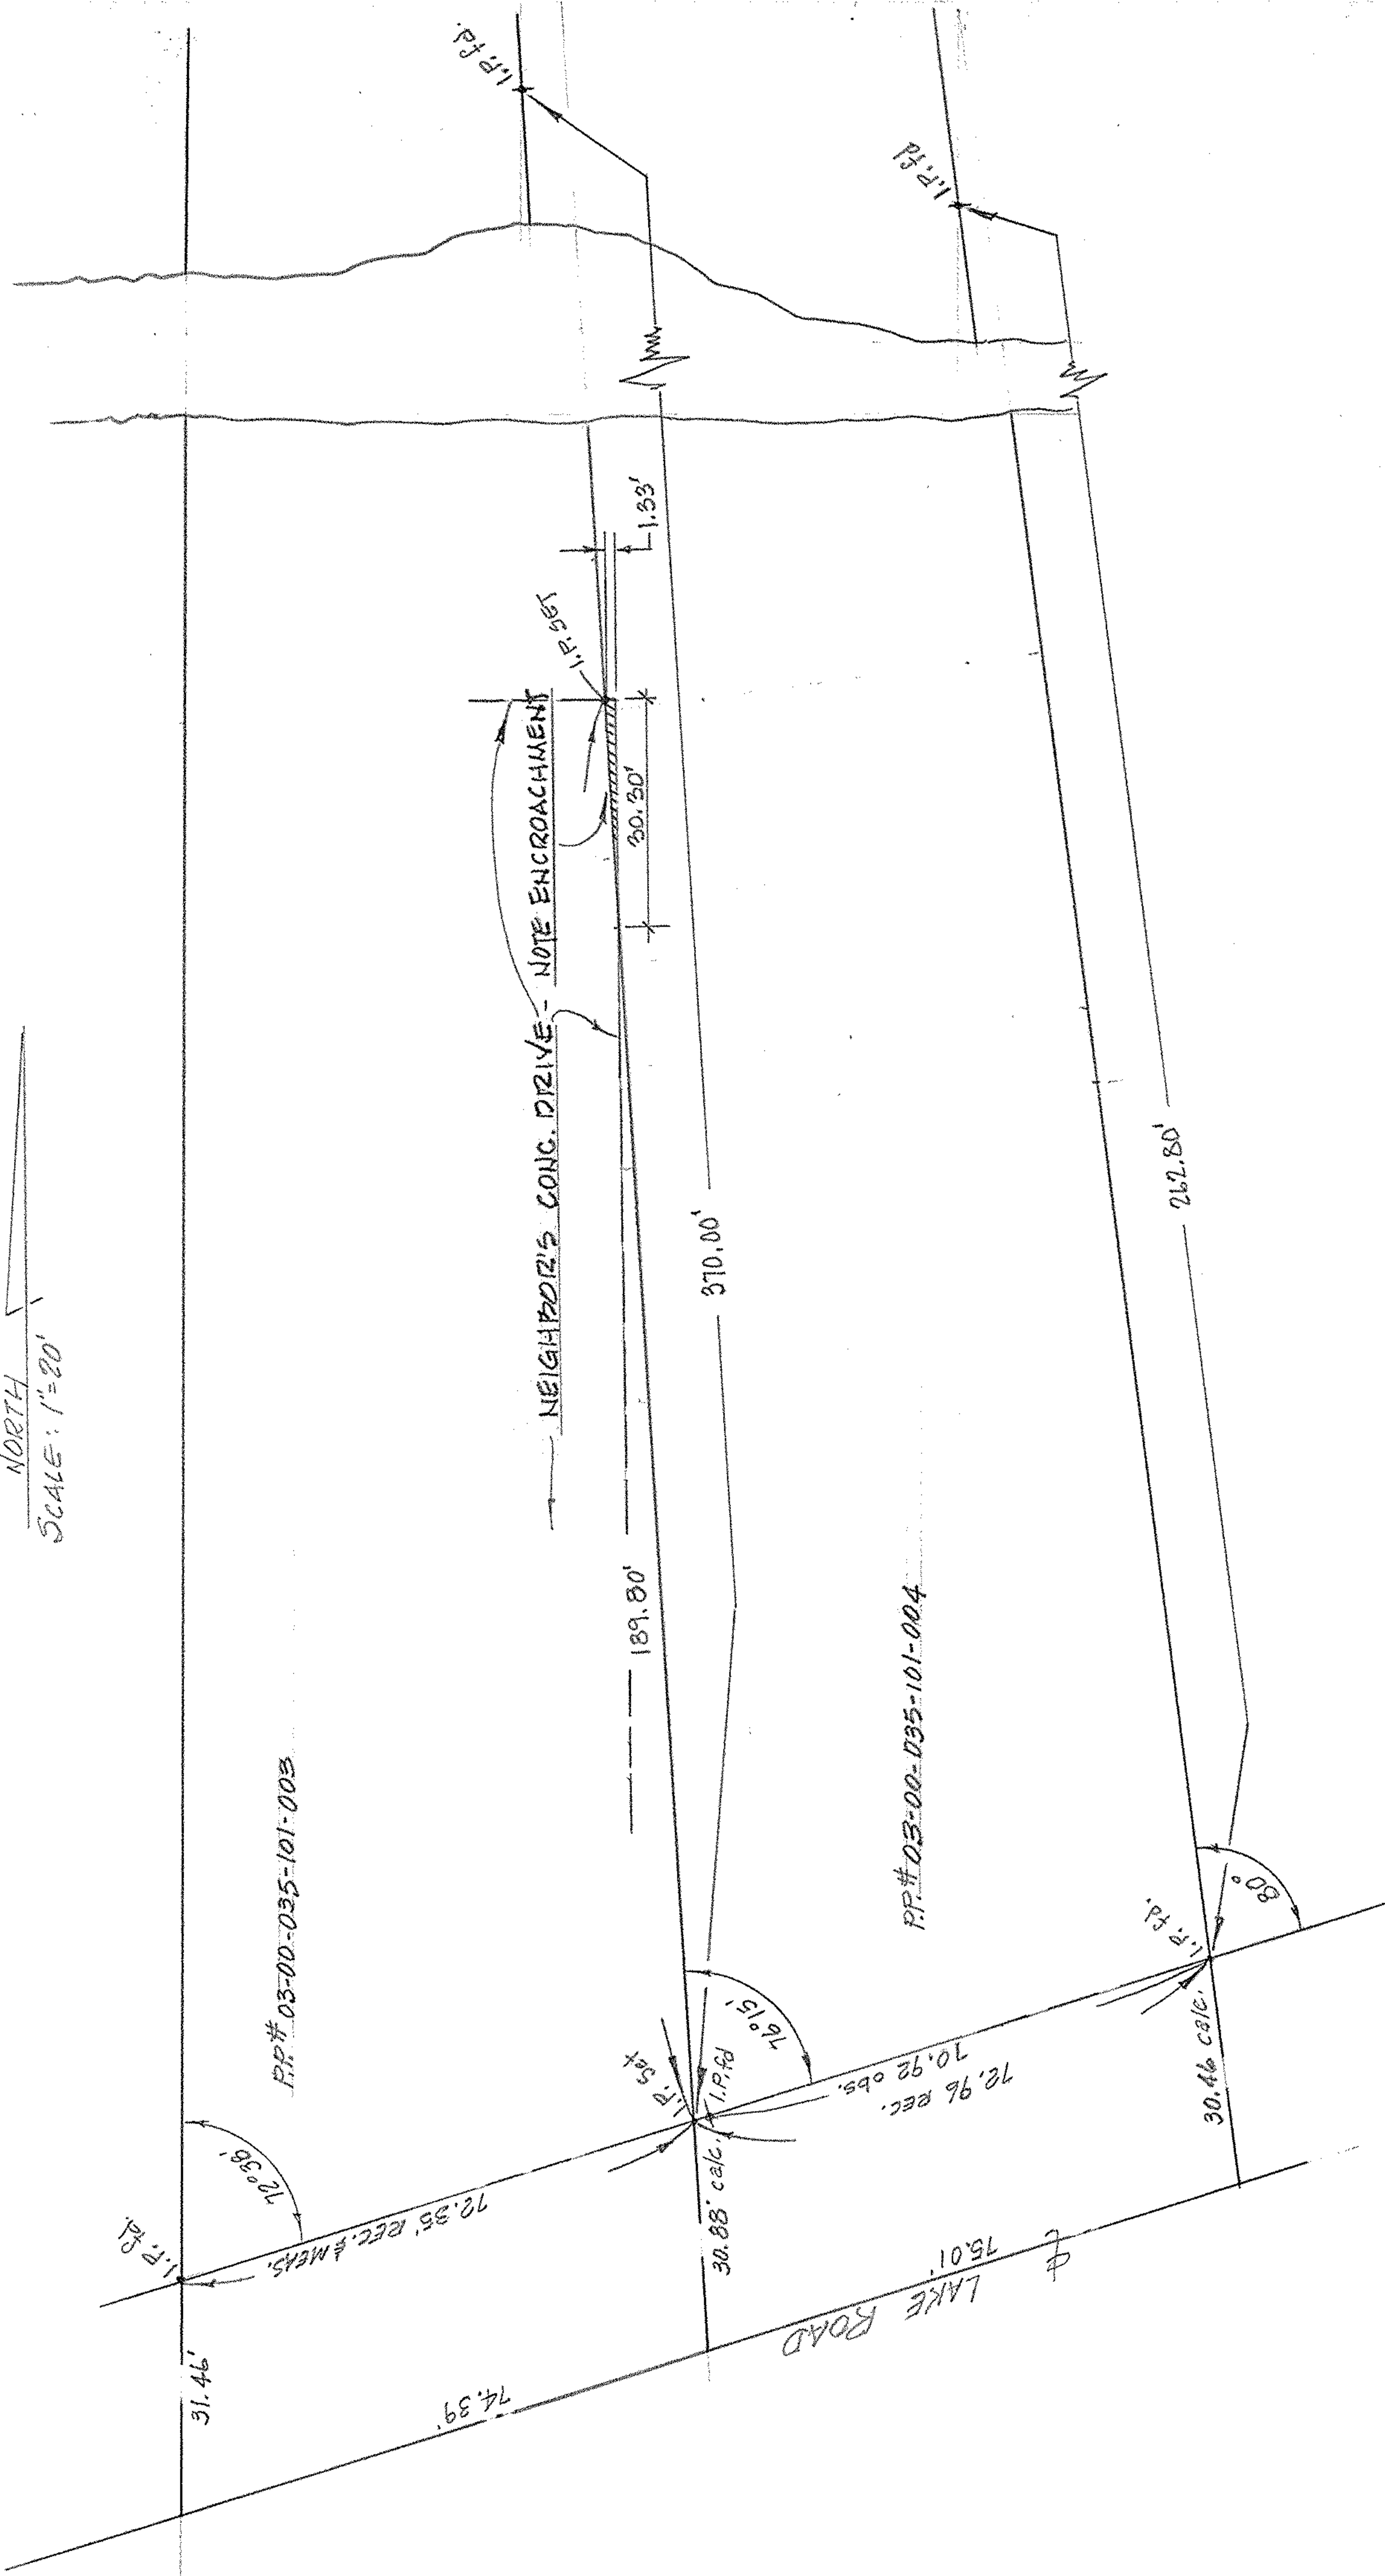

PP # 03-00-035-101-003

PP # 03-00-035-101-004

PLAN of SURVEY
FOR FRED VANDEBUSHILL
PART of ORIGINAL SHEFFIELD TWP LOT 35
CITY of SHEFFIELD LAKE, LORAIN COUNTY, OHIO

McGLINCHY and ASSOCIATES
ELYRIA OHIO
APRIL, 1978 JOB# 783239