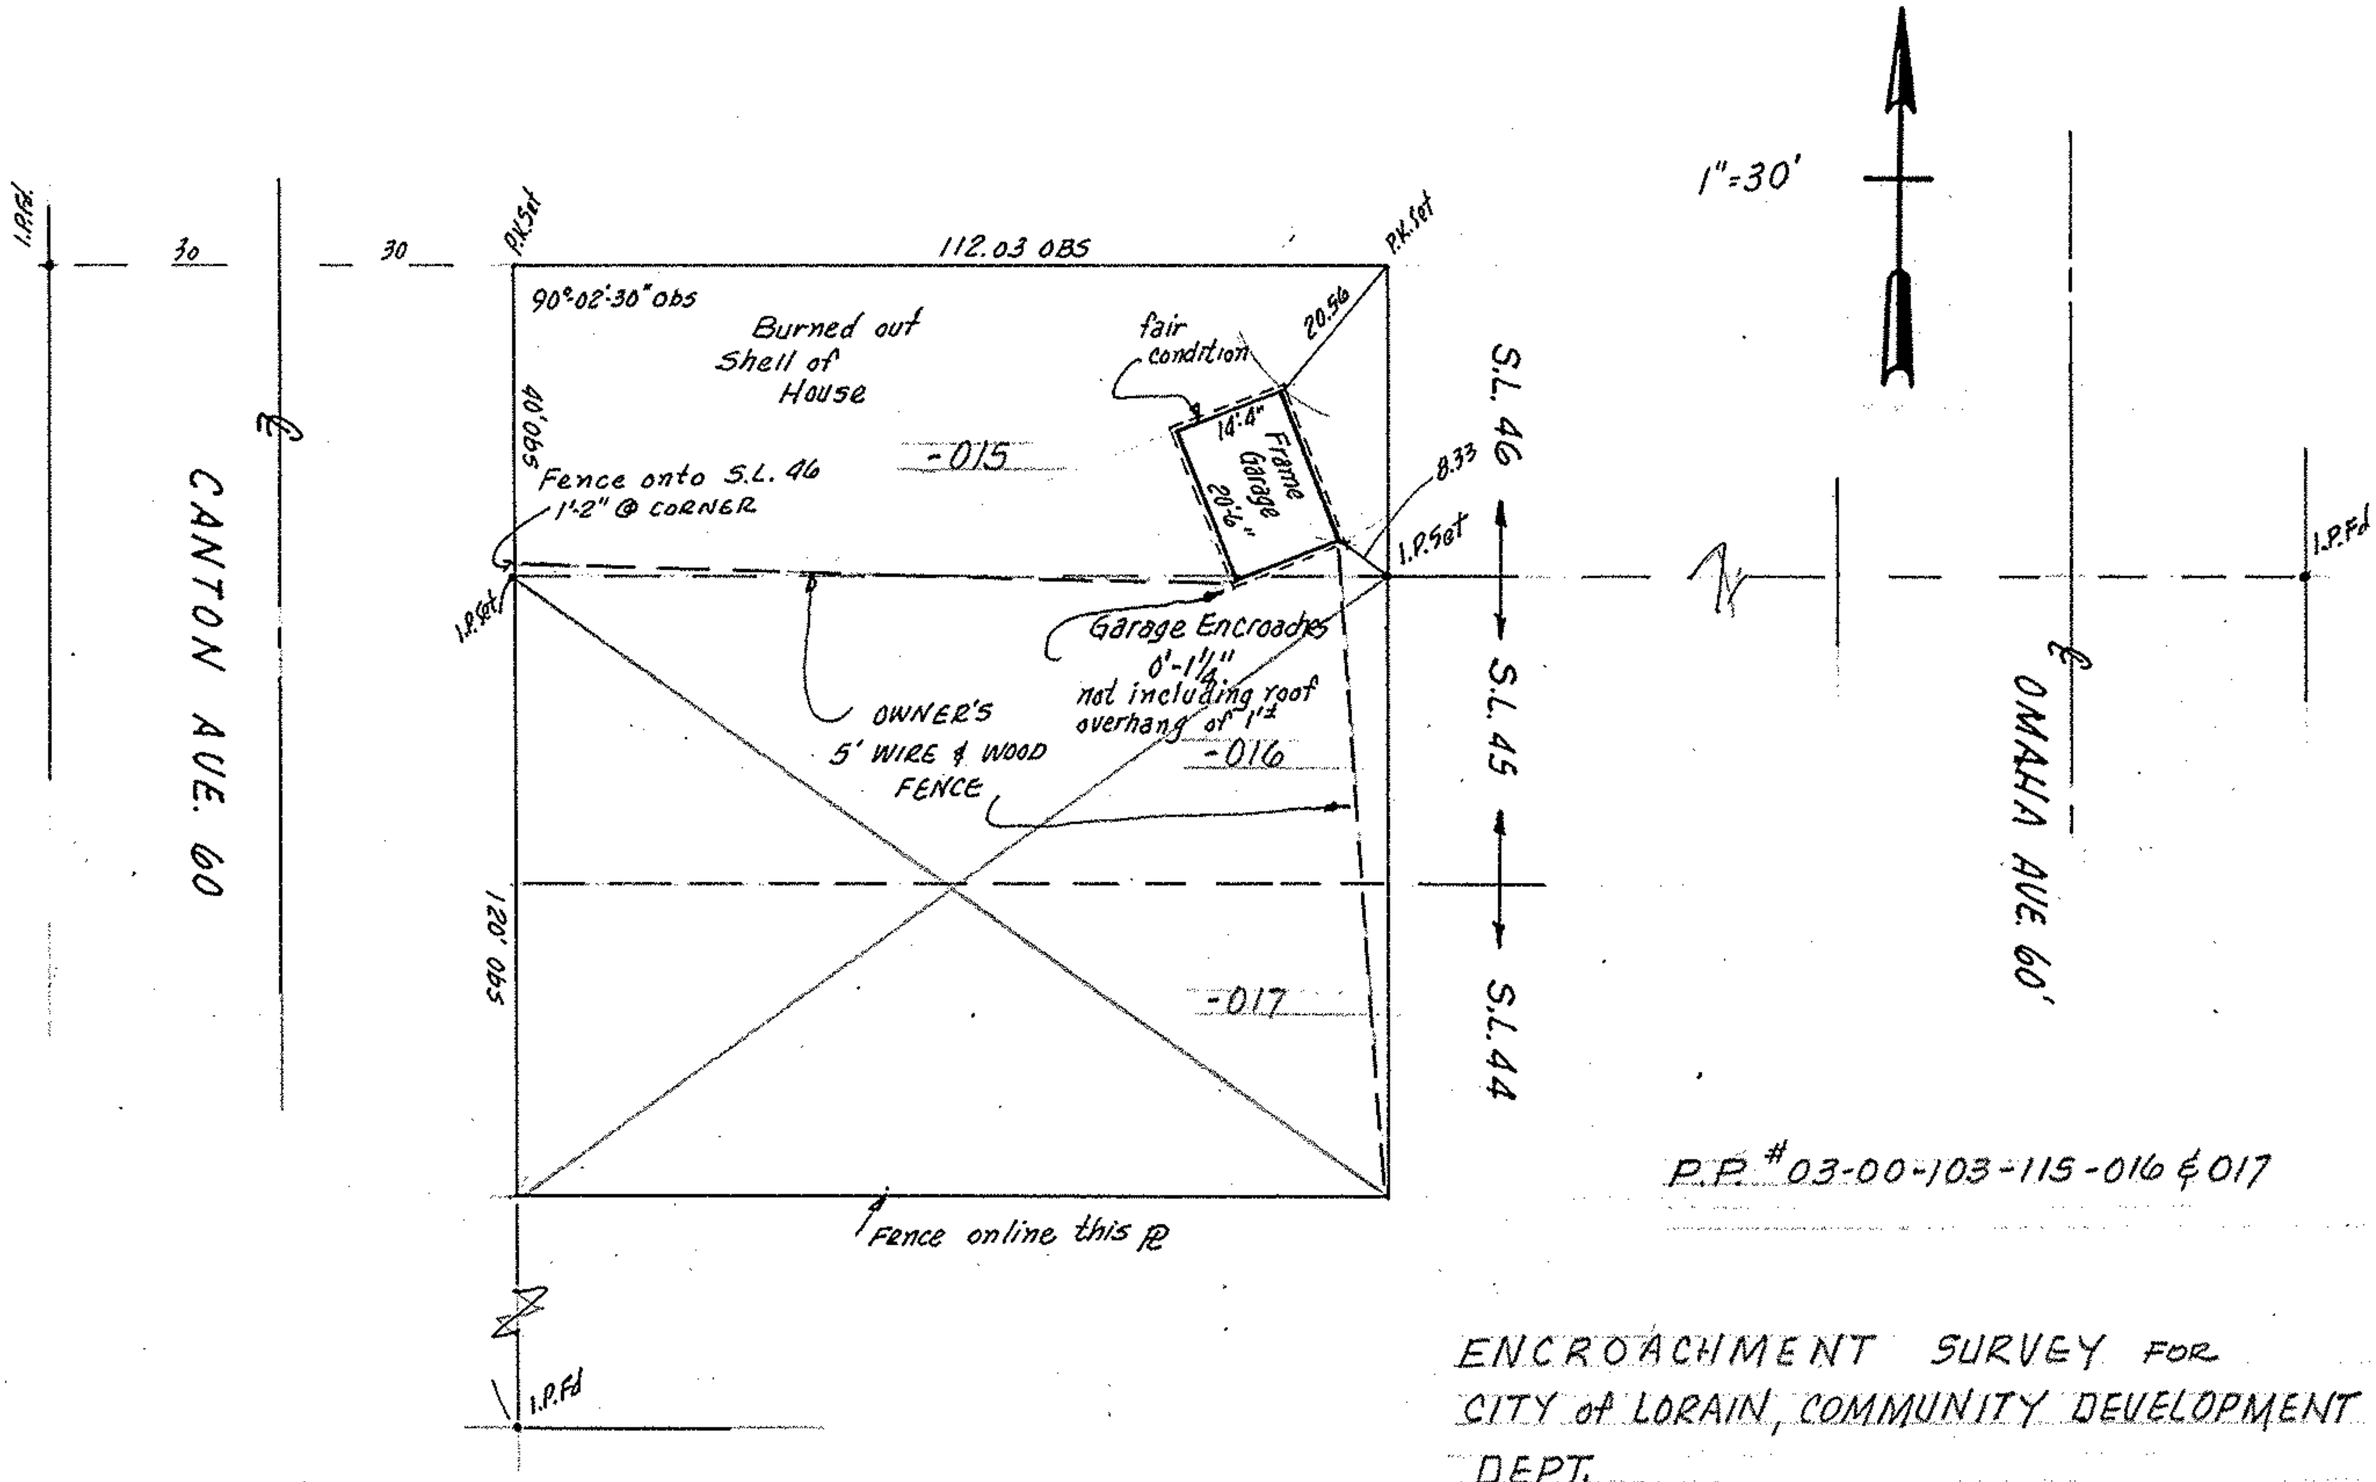

P.P. #03-00-103-115-016 & 017

ENCROACHMENT SURVEY FOR
CITY of LORAIN, COMMUNITY DEVELOPMENT
DEPT.

SUBLOTS 44, 45 & 46 of BLOCK 8 of CITY VIEW ALLOT.

PLAT VOL. 6 PAGE 8
PART of ORIG. SHEFFIELD TWP. LOT 103
NOW in CITY of LORAIN, OHIO

BY
McGLINCHY & ASSOCIATES
FEB. 16, 1978 #783007
CTIC E169,663