E. BROAD ST. - 66'

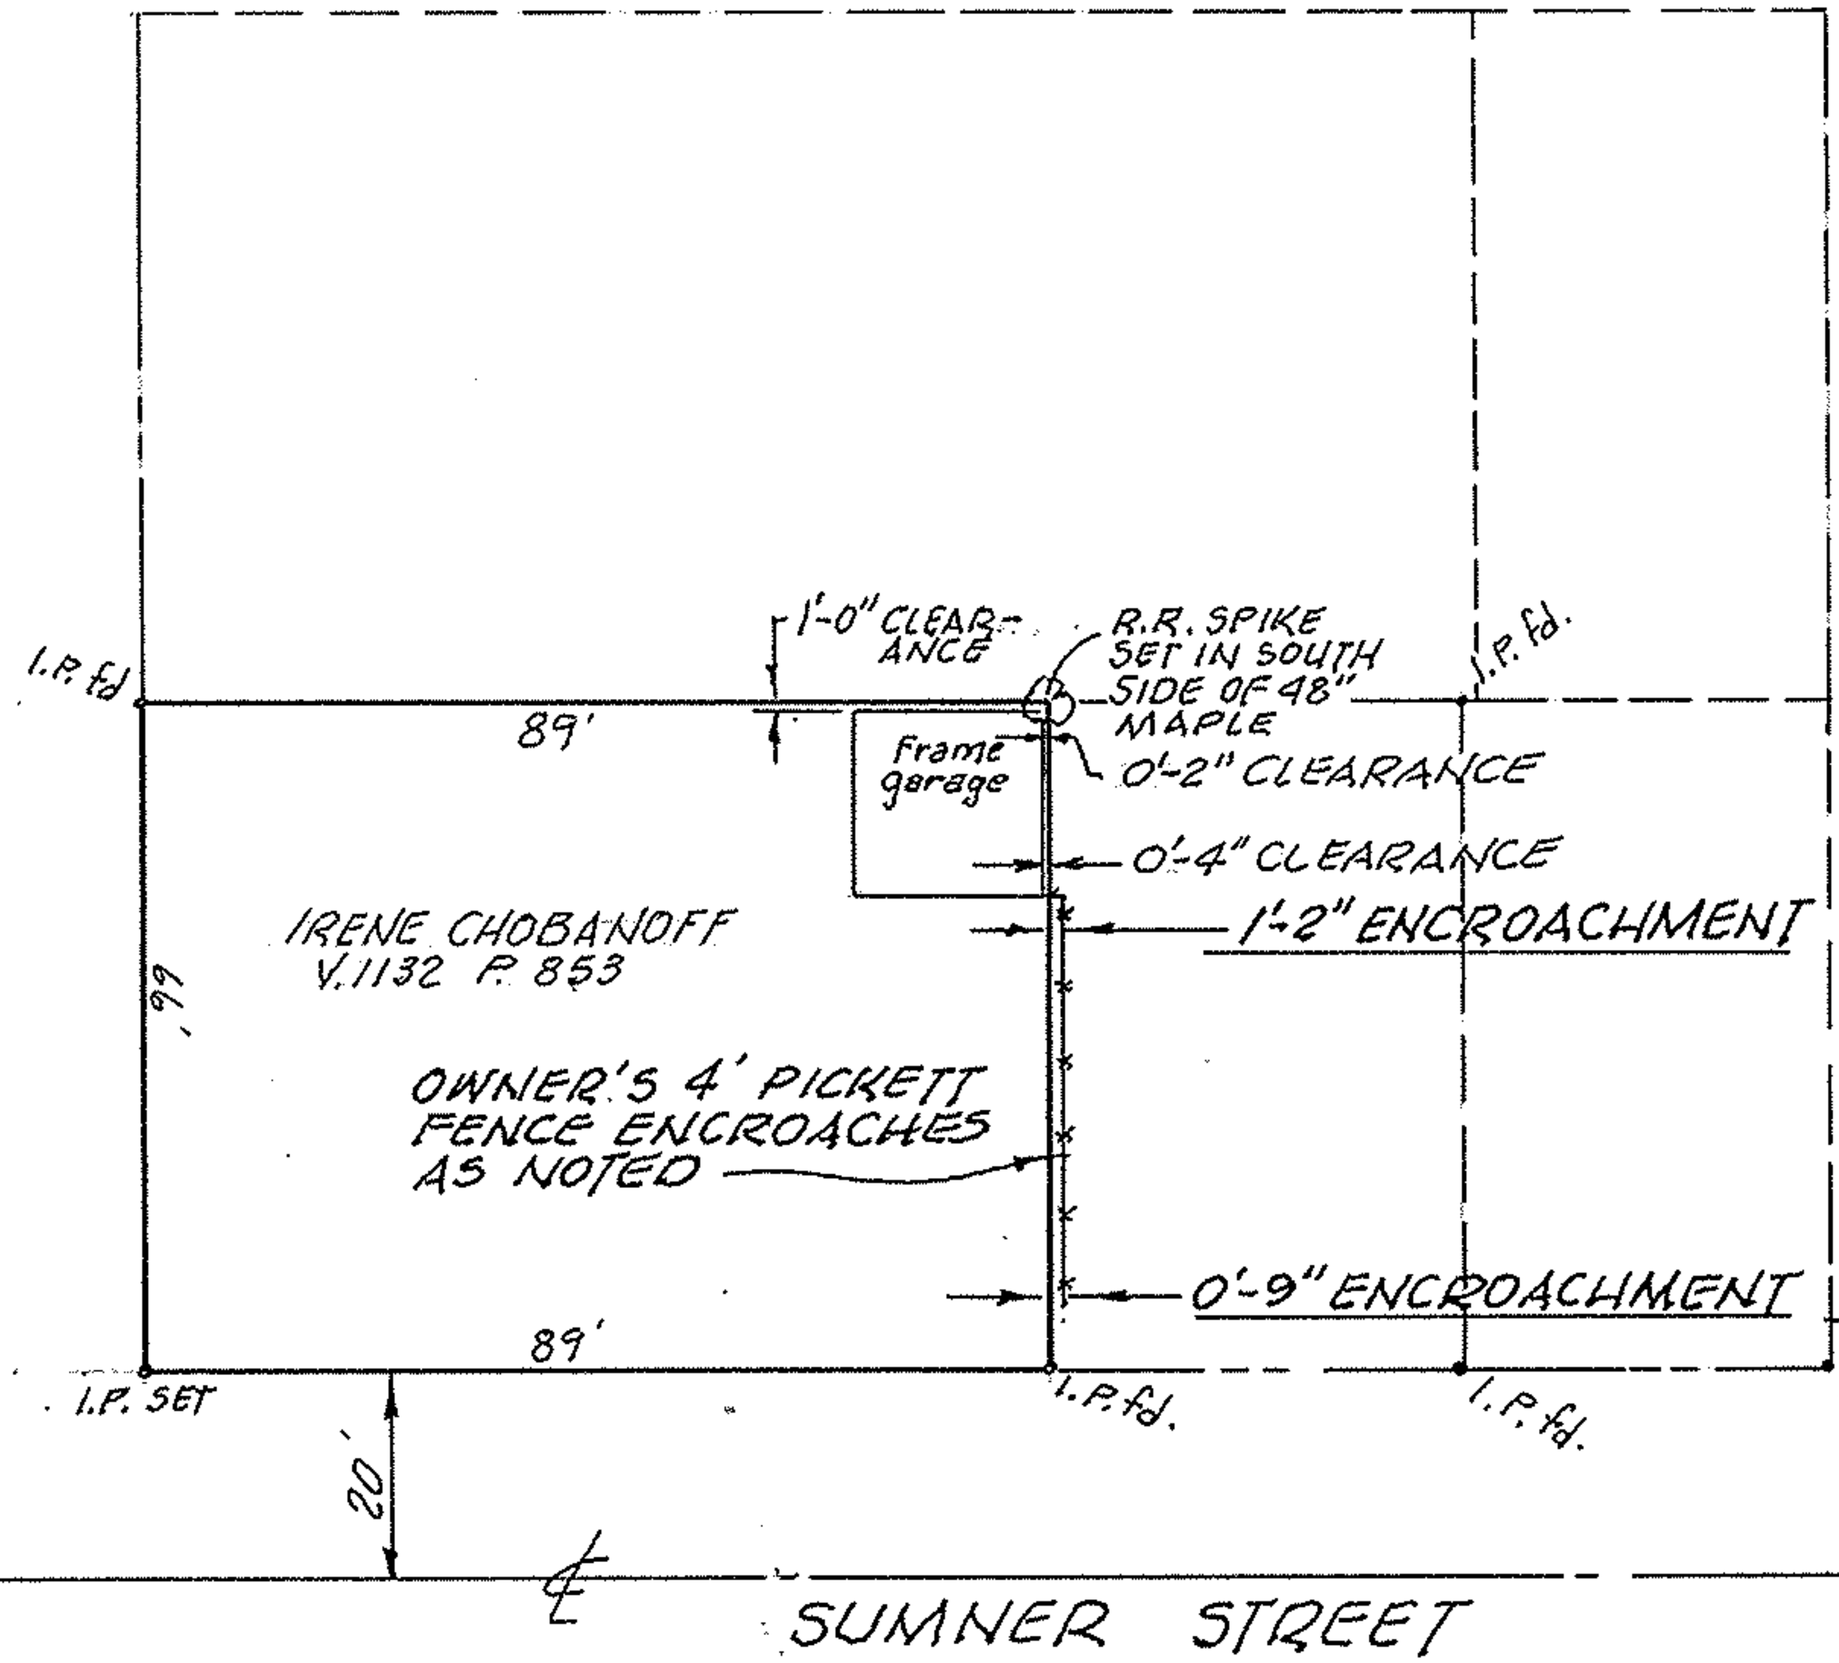

SCALE: 1" = 30'

SKETCH of SURVEY
for LEW MELROSE

PROPERTY LOC. @ E. BROAD ST. & SUMNER ST.
PART of ORIG. ELYRIA TOWNSHIP LOT 77
CITY of ELYRIA, LORAIN COUNTY, OHIO

McGLINCHY & ASSOCIATES
ELYRIA OHIO
JULY 1978 #783538