


RUSTIC HILL LANE - 60'

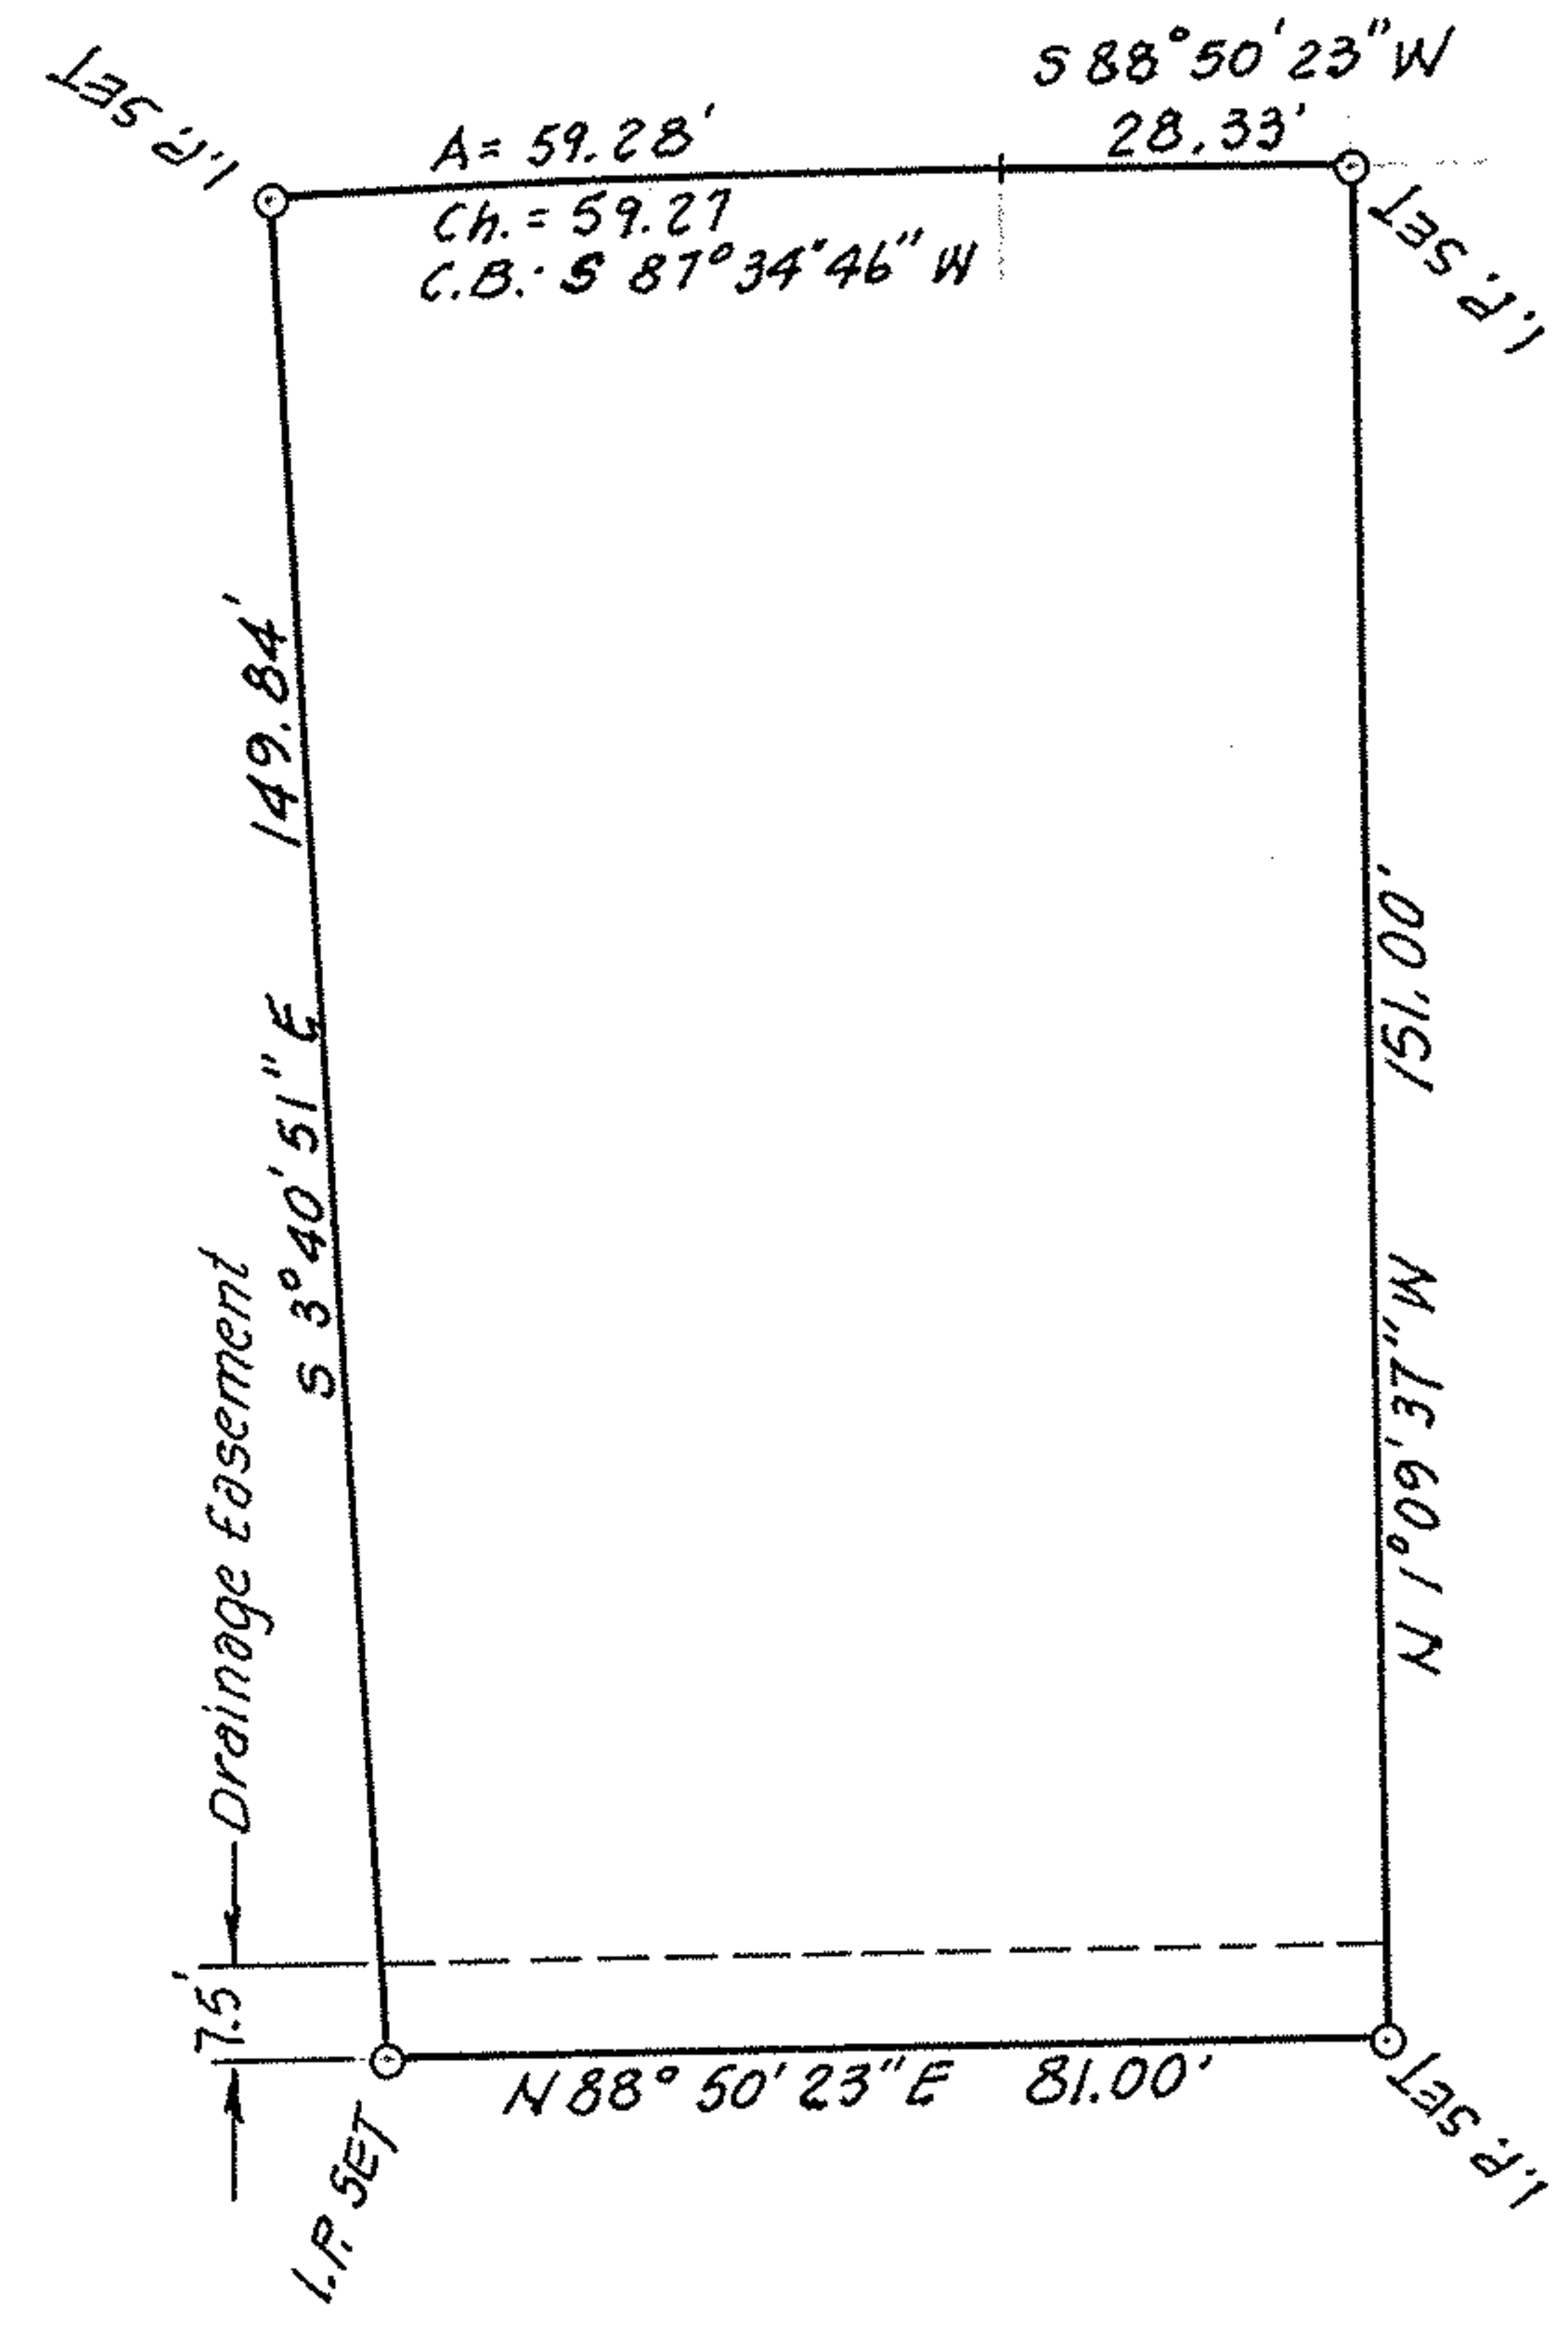

Drainage Easement

7.5'

I.P. SET

S 3° 40' 51\" E 149.84'

A = 59.28'
Ch. = 59.27
C.B. = S 87° 34' 46\" W

S 88° 50' 23\" W
28.33'

I.P. SET

N 1° 09' 37\" W 151.00'

I.P. SET

MAP of SURVEY
PREPARED FOR ANTHONY D'AGOSTINO

NORTH
SCALE: 1" = 30'

LEGAL DESCRIPTION:

Situated in the Township of Amherst, County of Lorain and State of Ohio. Being known as SUBLOT 74 in HIDDEN VALLEY SUBDIVISION No. 1, as recorded in Volume 31, Pages 31 & 34 of Lorain County Plat Records, but subject to all legal highways and easements of record.

McGLINCHY & ASSOCIATES
538 W. BROAD ST. - ELYRIA, OHIO
JUNE, 1976 #783389