


EMMA LAUENER
VOL 1187 PG 360

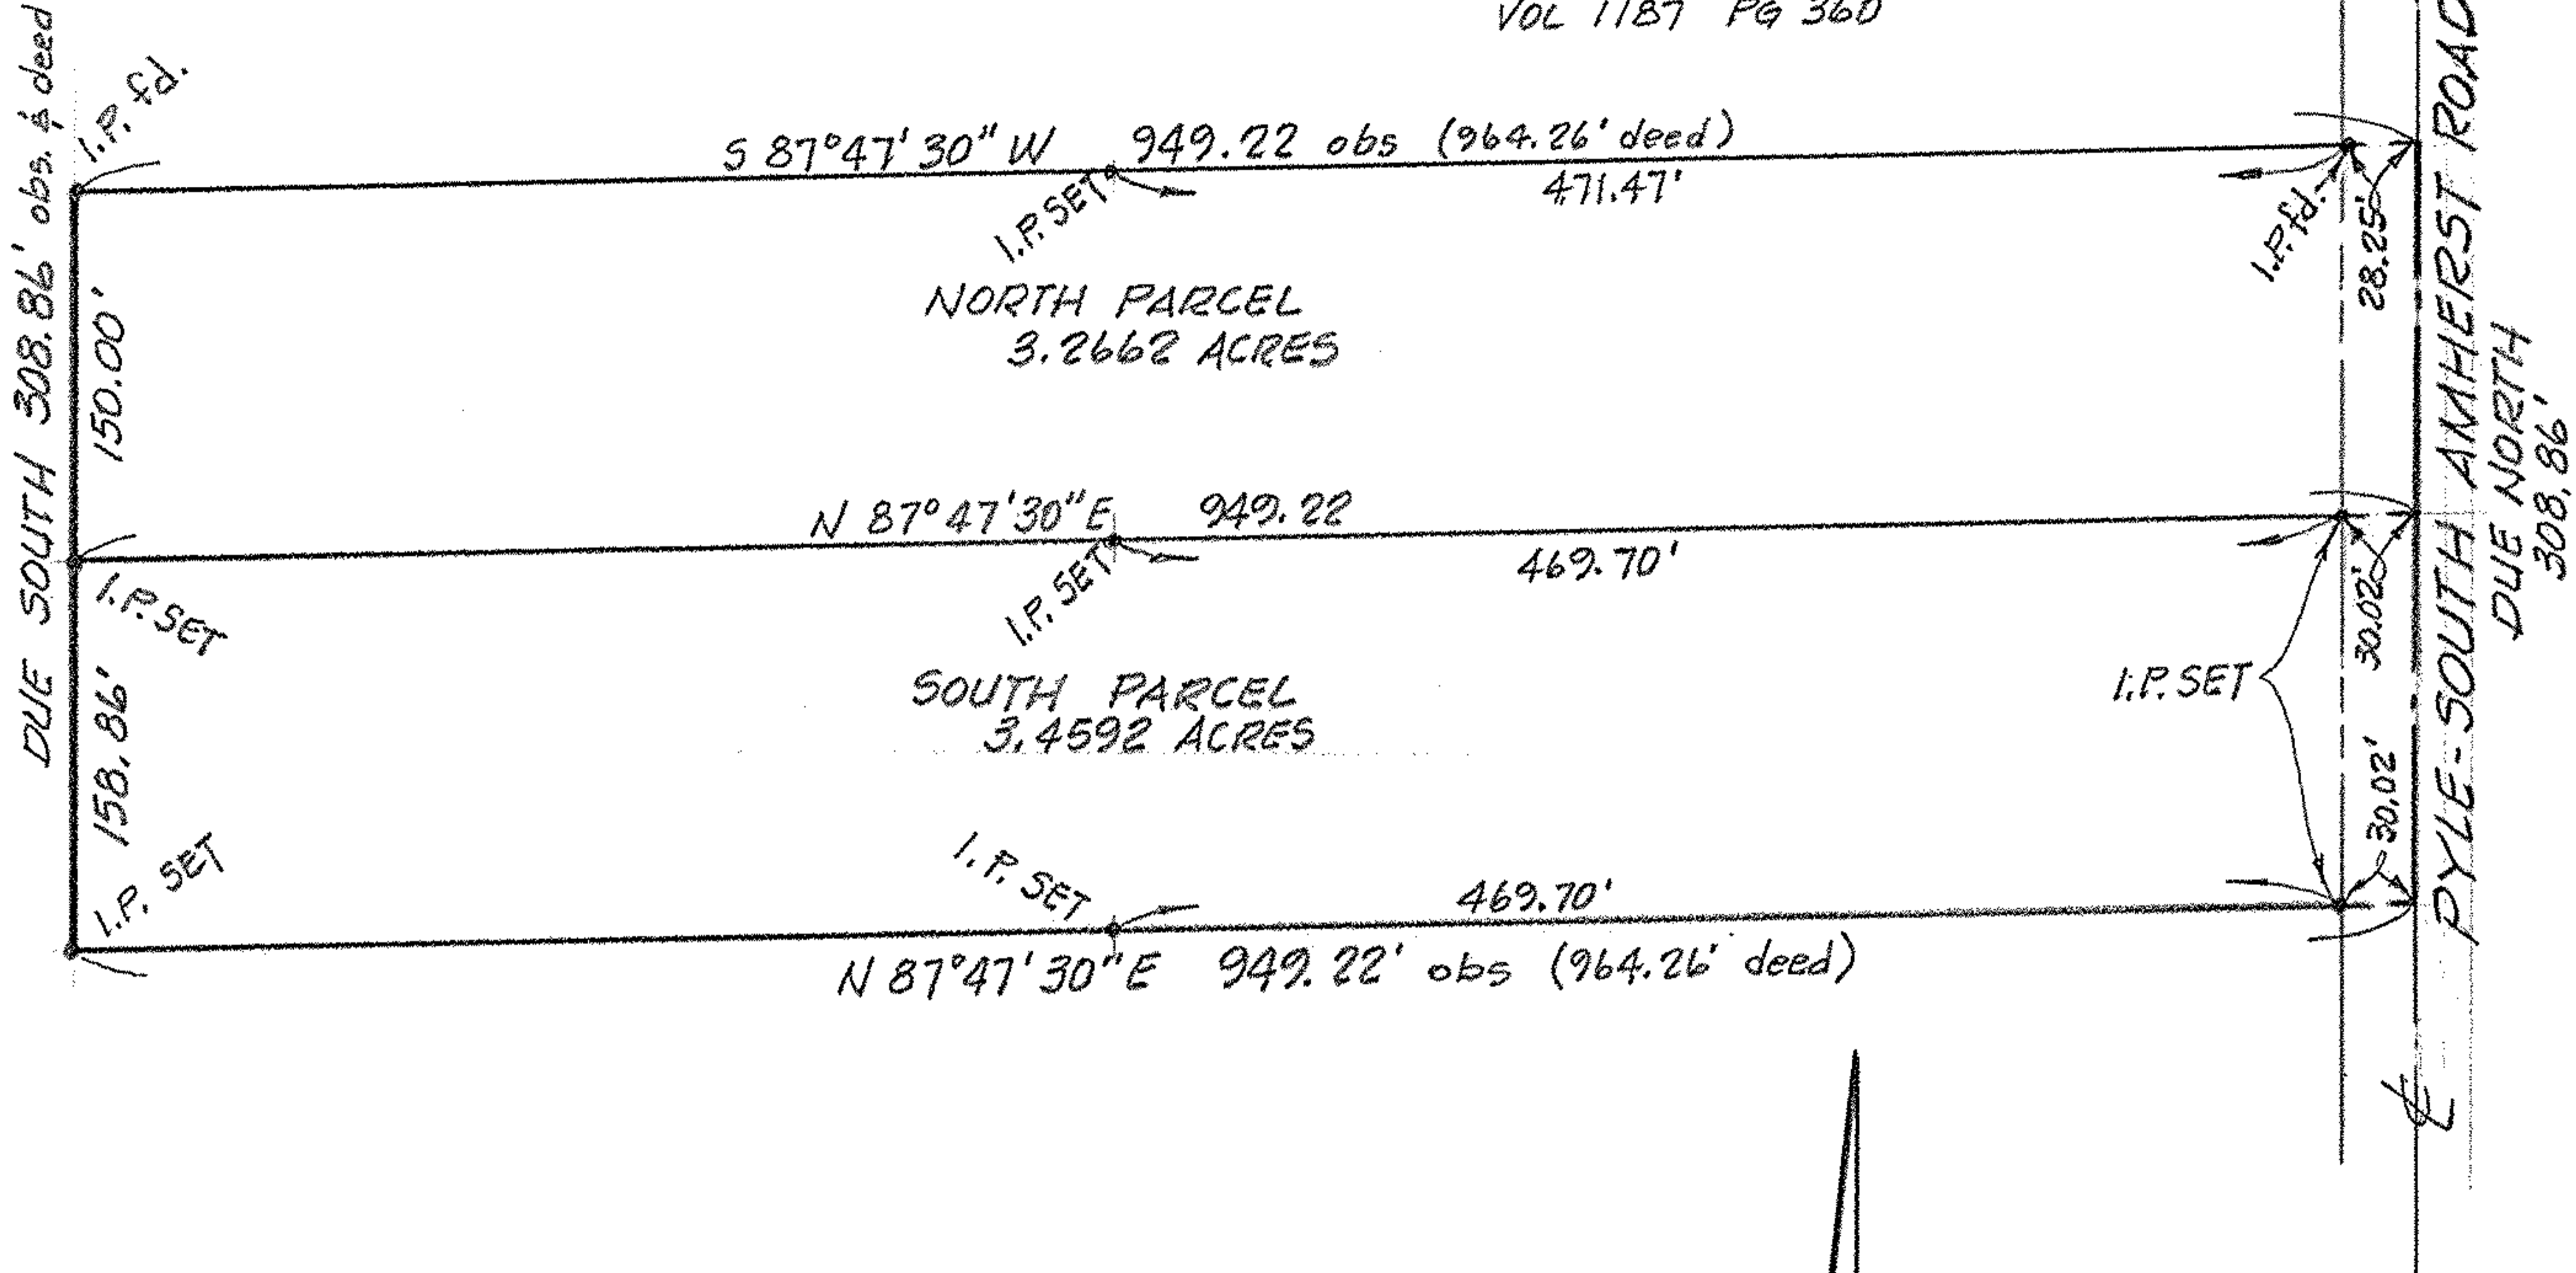

NORTH

SCALE: 1"=100'

MAP of SURVEY

FOR ALEX KAZUKA

PART of ORIG. RUSSIA TWP. LOT 13
TOWNSHIP of RUSSIA, LORAIN COUNTY, OHIO

McGLINCHY & ASSOCIATES
ELYRIA OHIO
JUNE, 1978 #783425