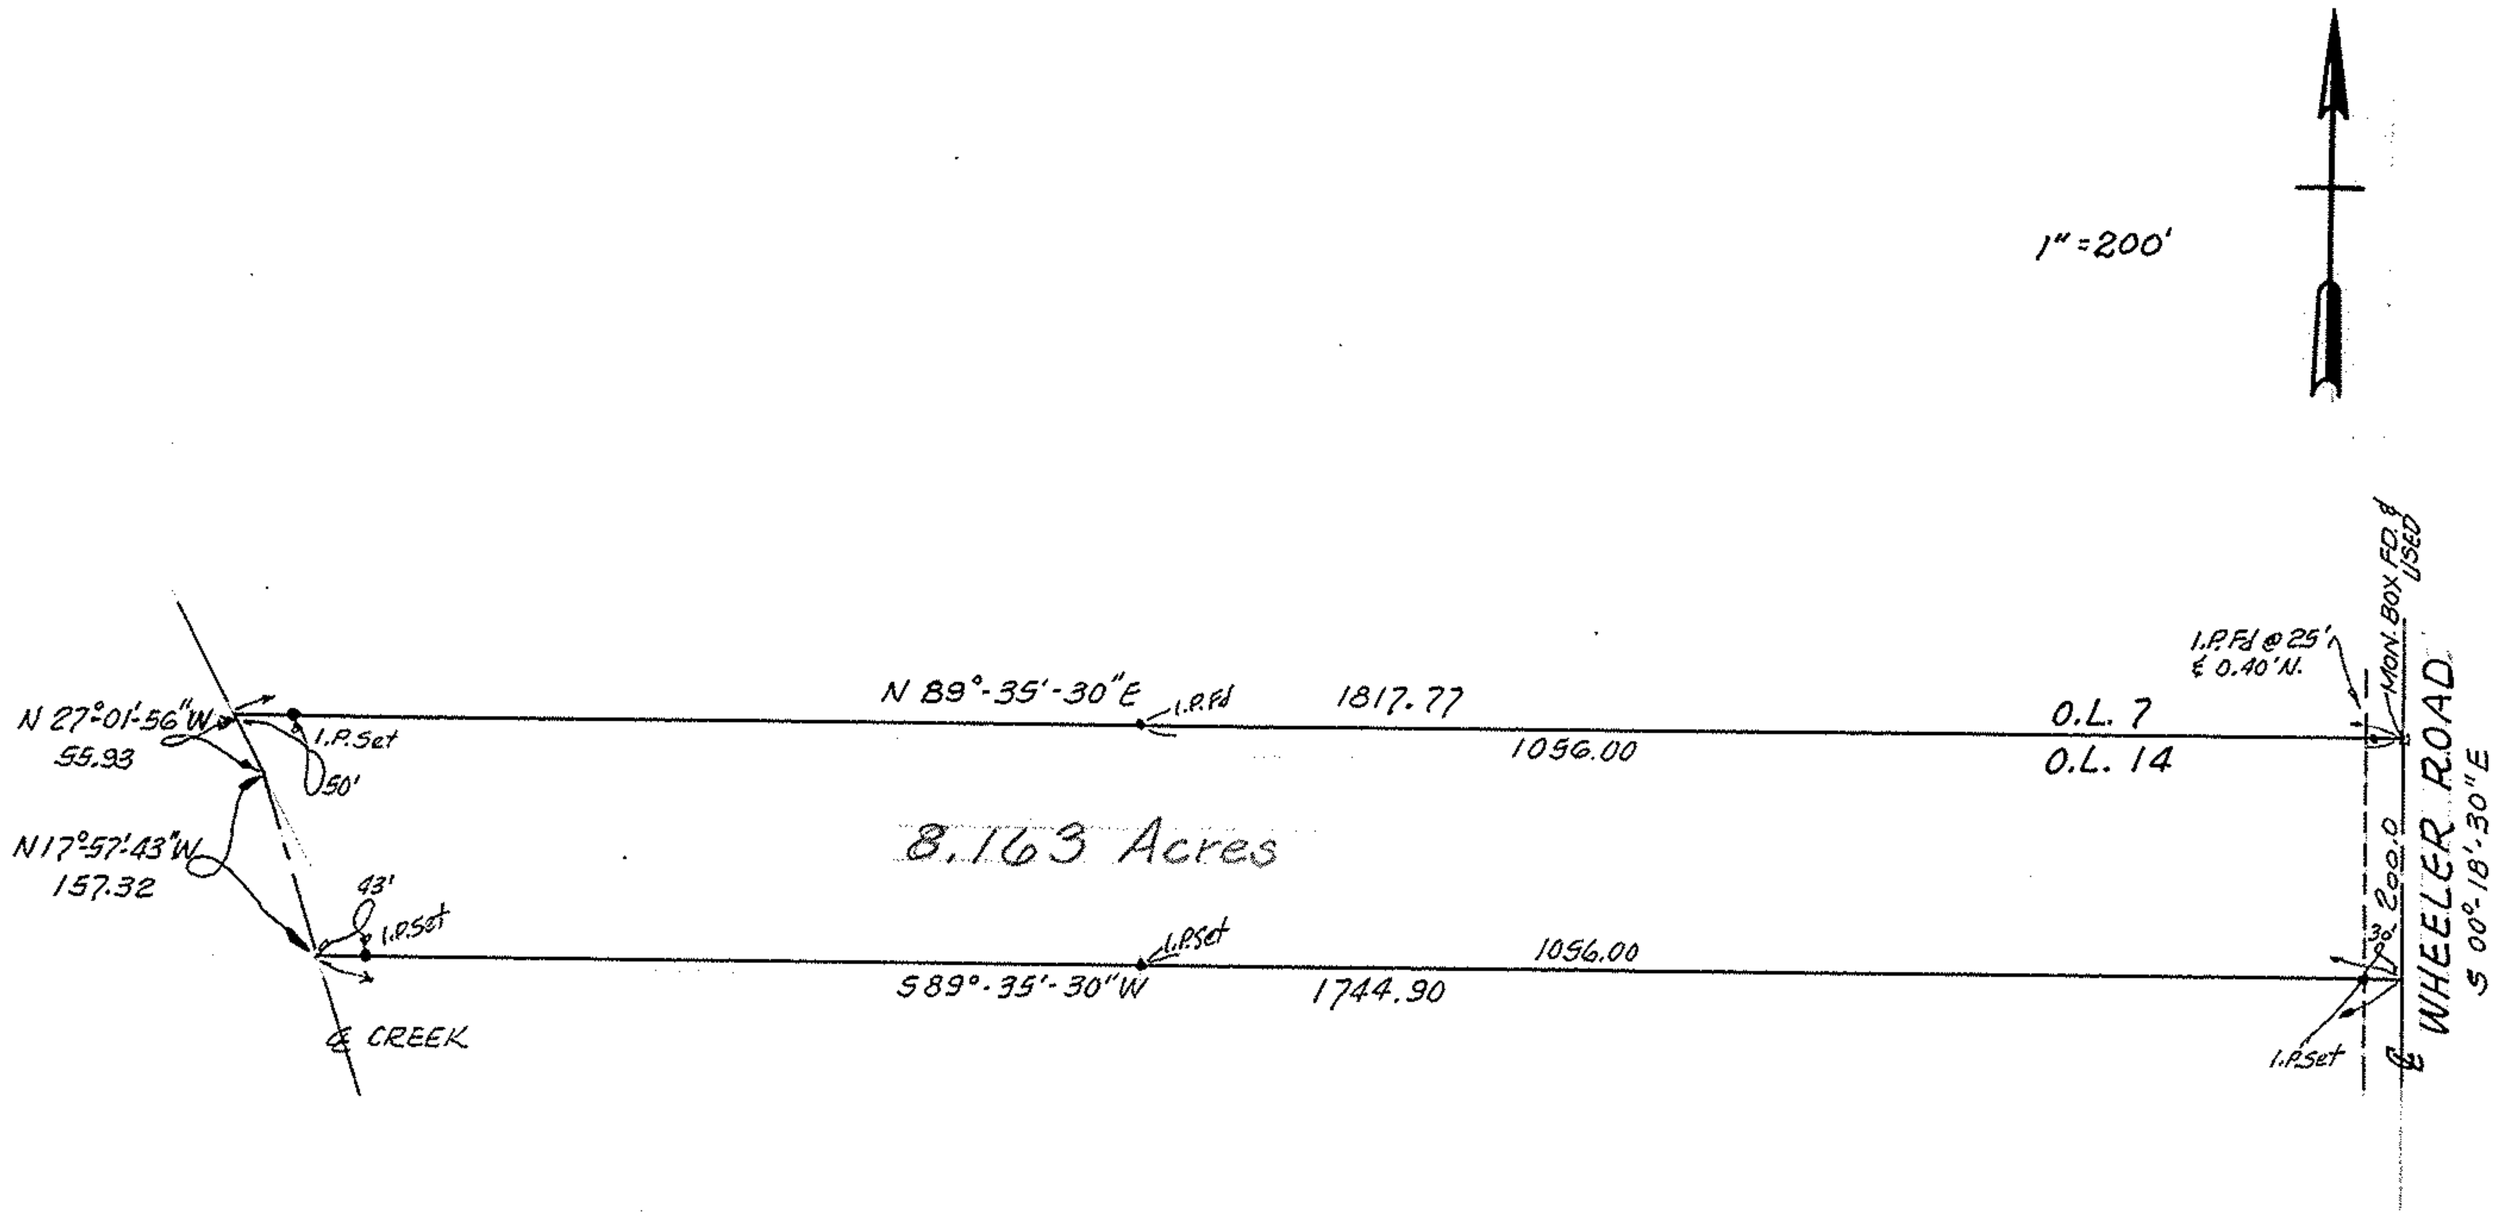

PART of P.P. #15-00-014-000-001

PART of ORIG. LAGRANGE TWP. LOT 14
LORAIN COUNTY ,OHIO

THIS IS A PLAT OF SURVEY:
FOR: EDNA WHEELER

McGLINCHY & ASSOCIATES INC.

AUG. 31, 1982 #827351