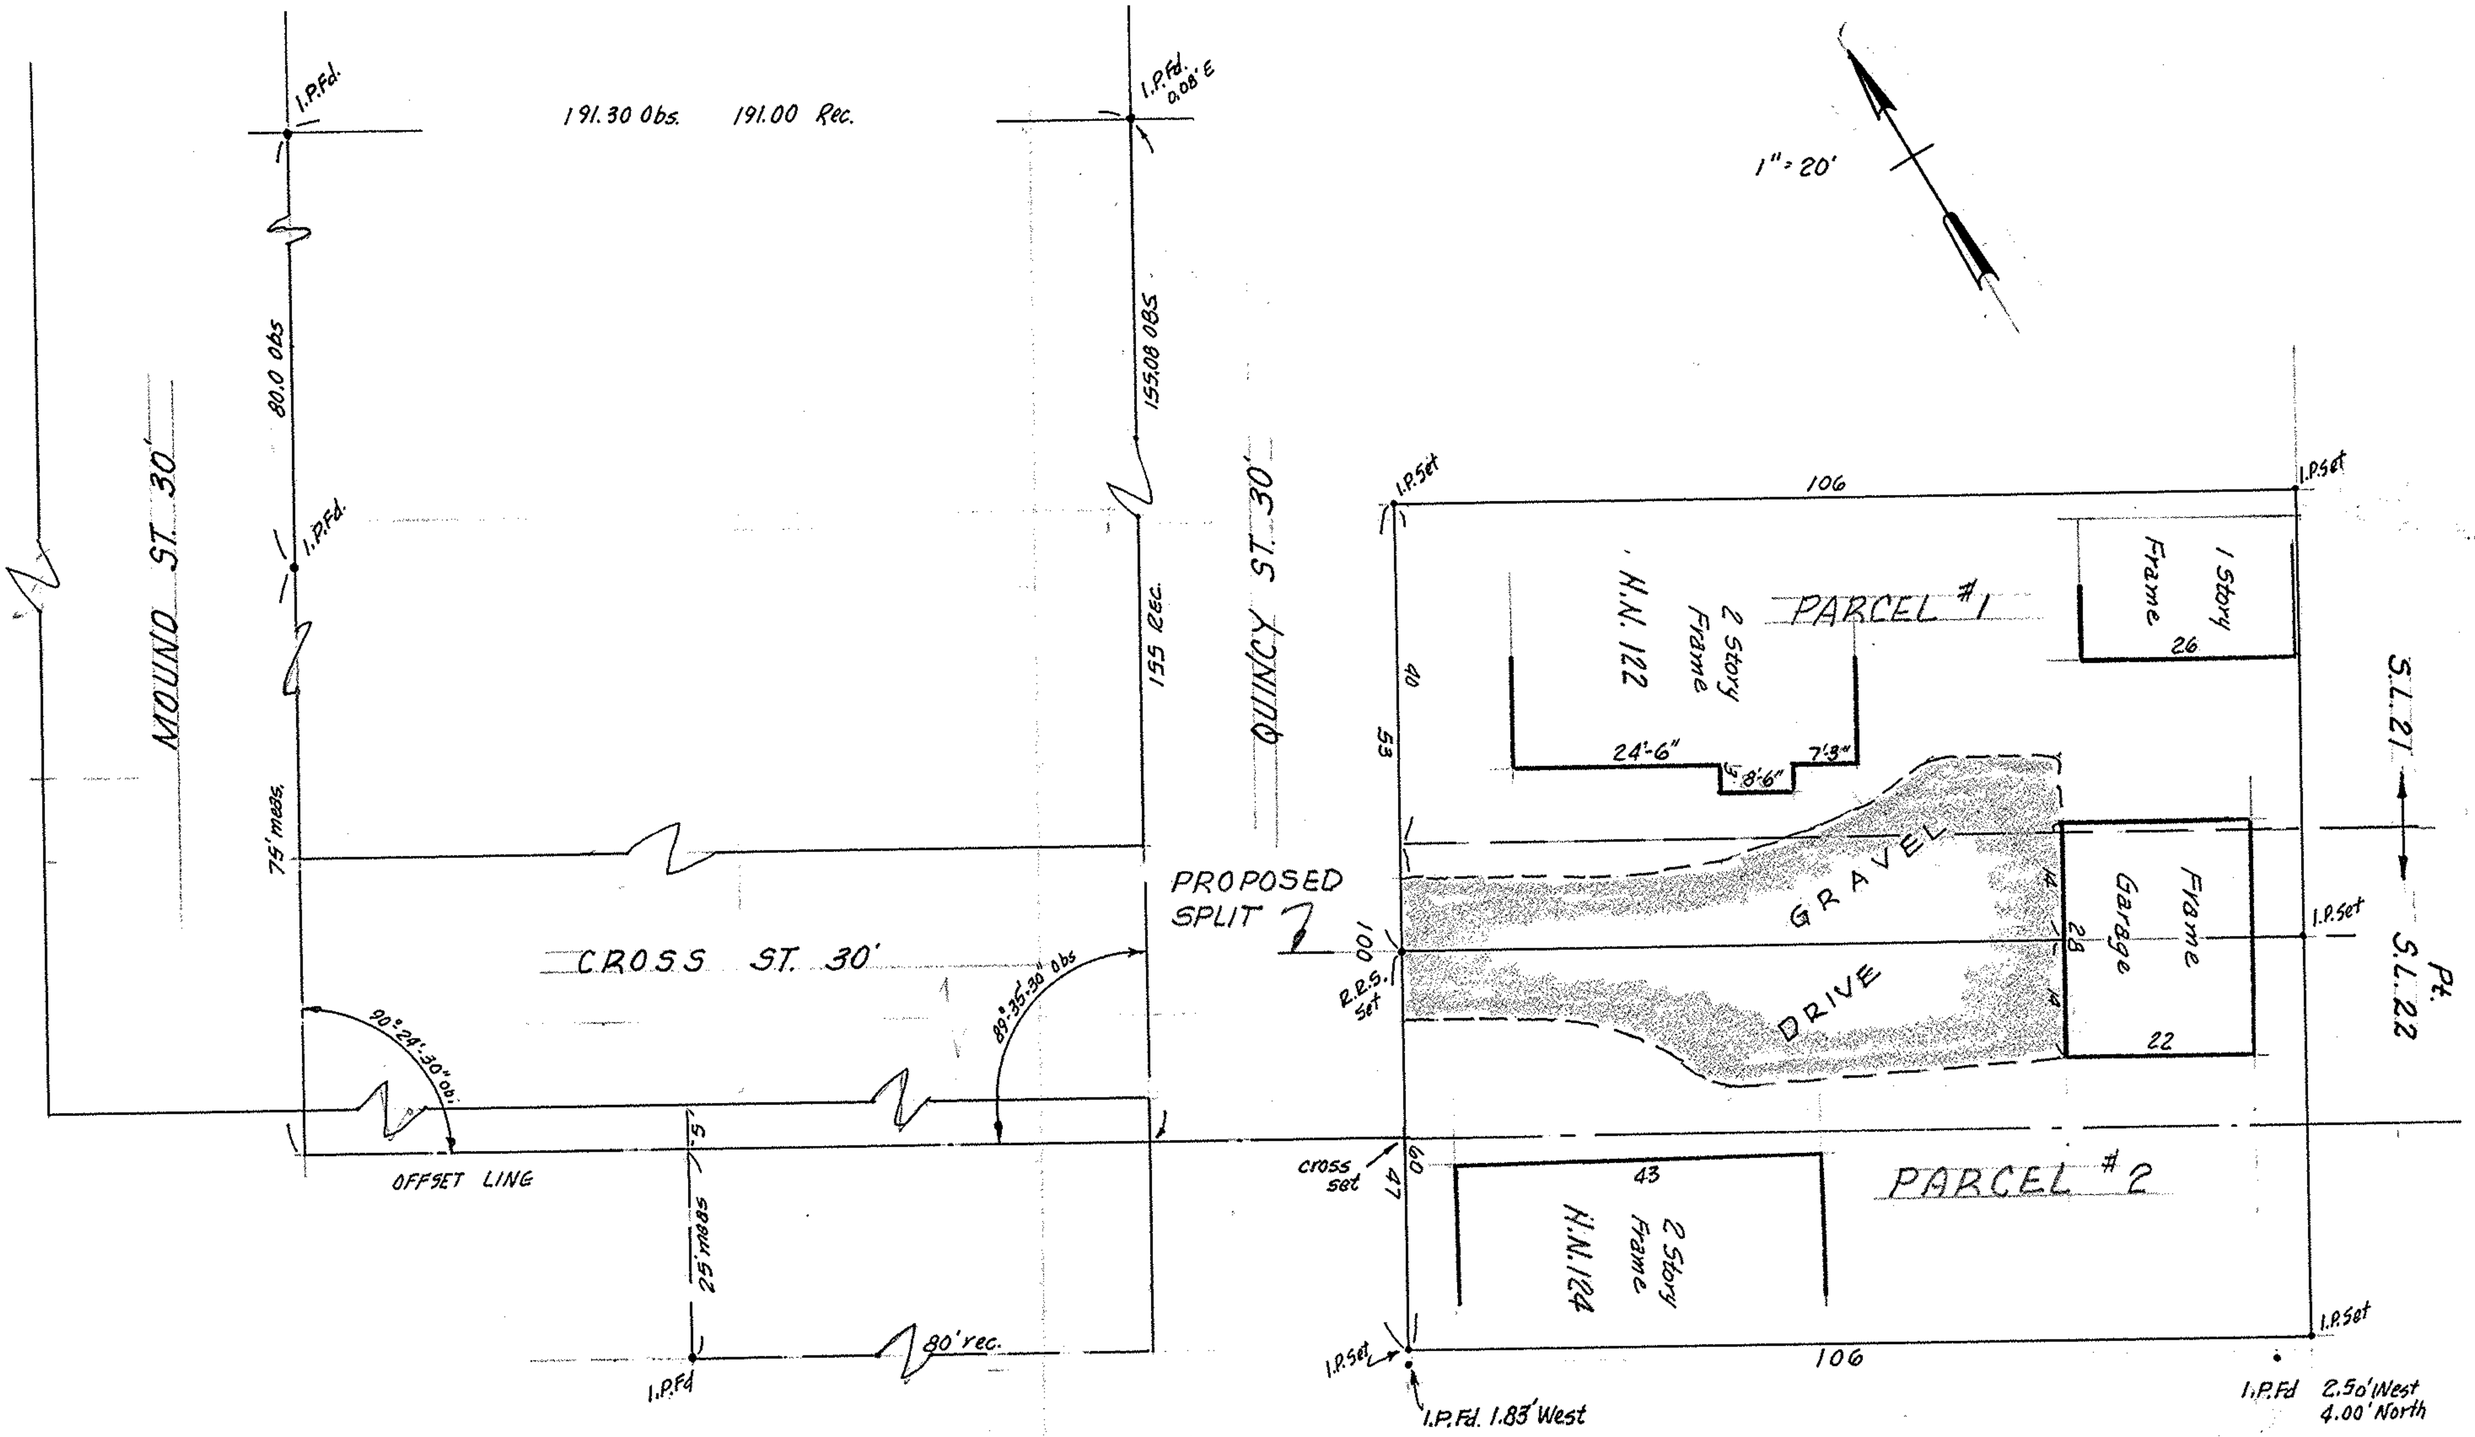

MAP of SURVEY

P.P.# 06-25-057-000-004, 005 & 006
SUBLOT #21 PLUS PART of SUBLOT #22 in W.E. BROOKS SUBD'N
VOL 4 PG 35 O.L. 57 EAST of RIVER

APPROVAL of SPLIT:

CITY of ELYRIA - BUILDING DEPT.

PROPOSED PARCEL SPLIT FOR
FRED SULLIVAN
#2 ARDOLA CT ELYRIA, OHIO

McGLINCHY & ASSOCIATES INC.
REGISTERED SURVEYORS & CIVIL ENGINEERS
538 W. BROAD ST. ELYRIA, OHIO 44035
FEB. 1979 # 794854