
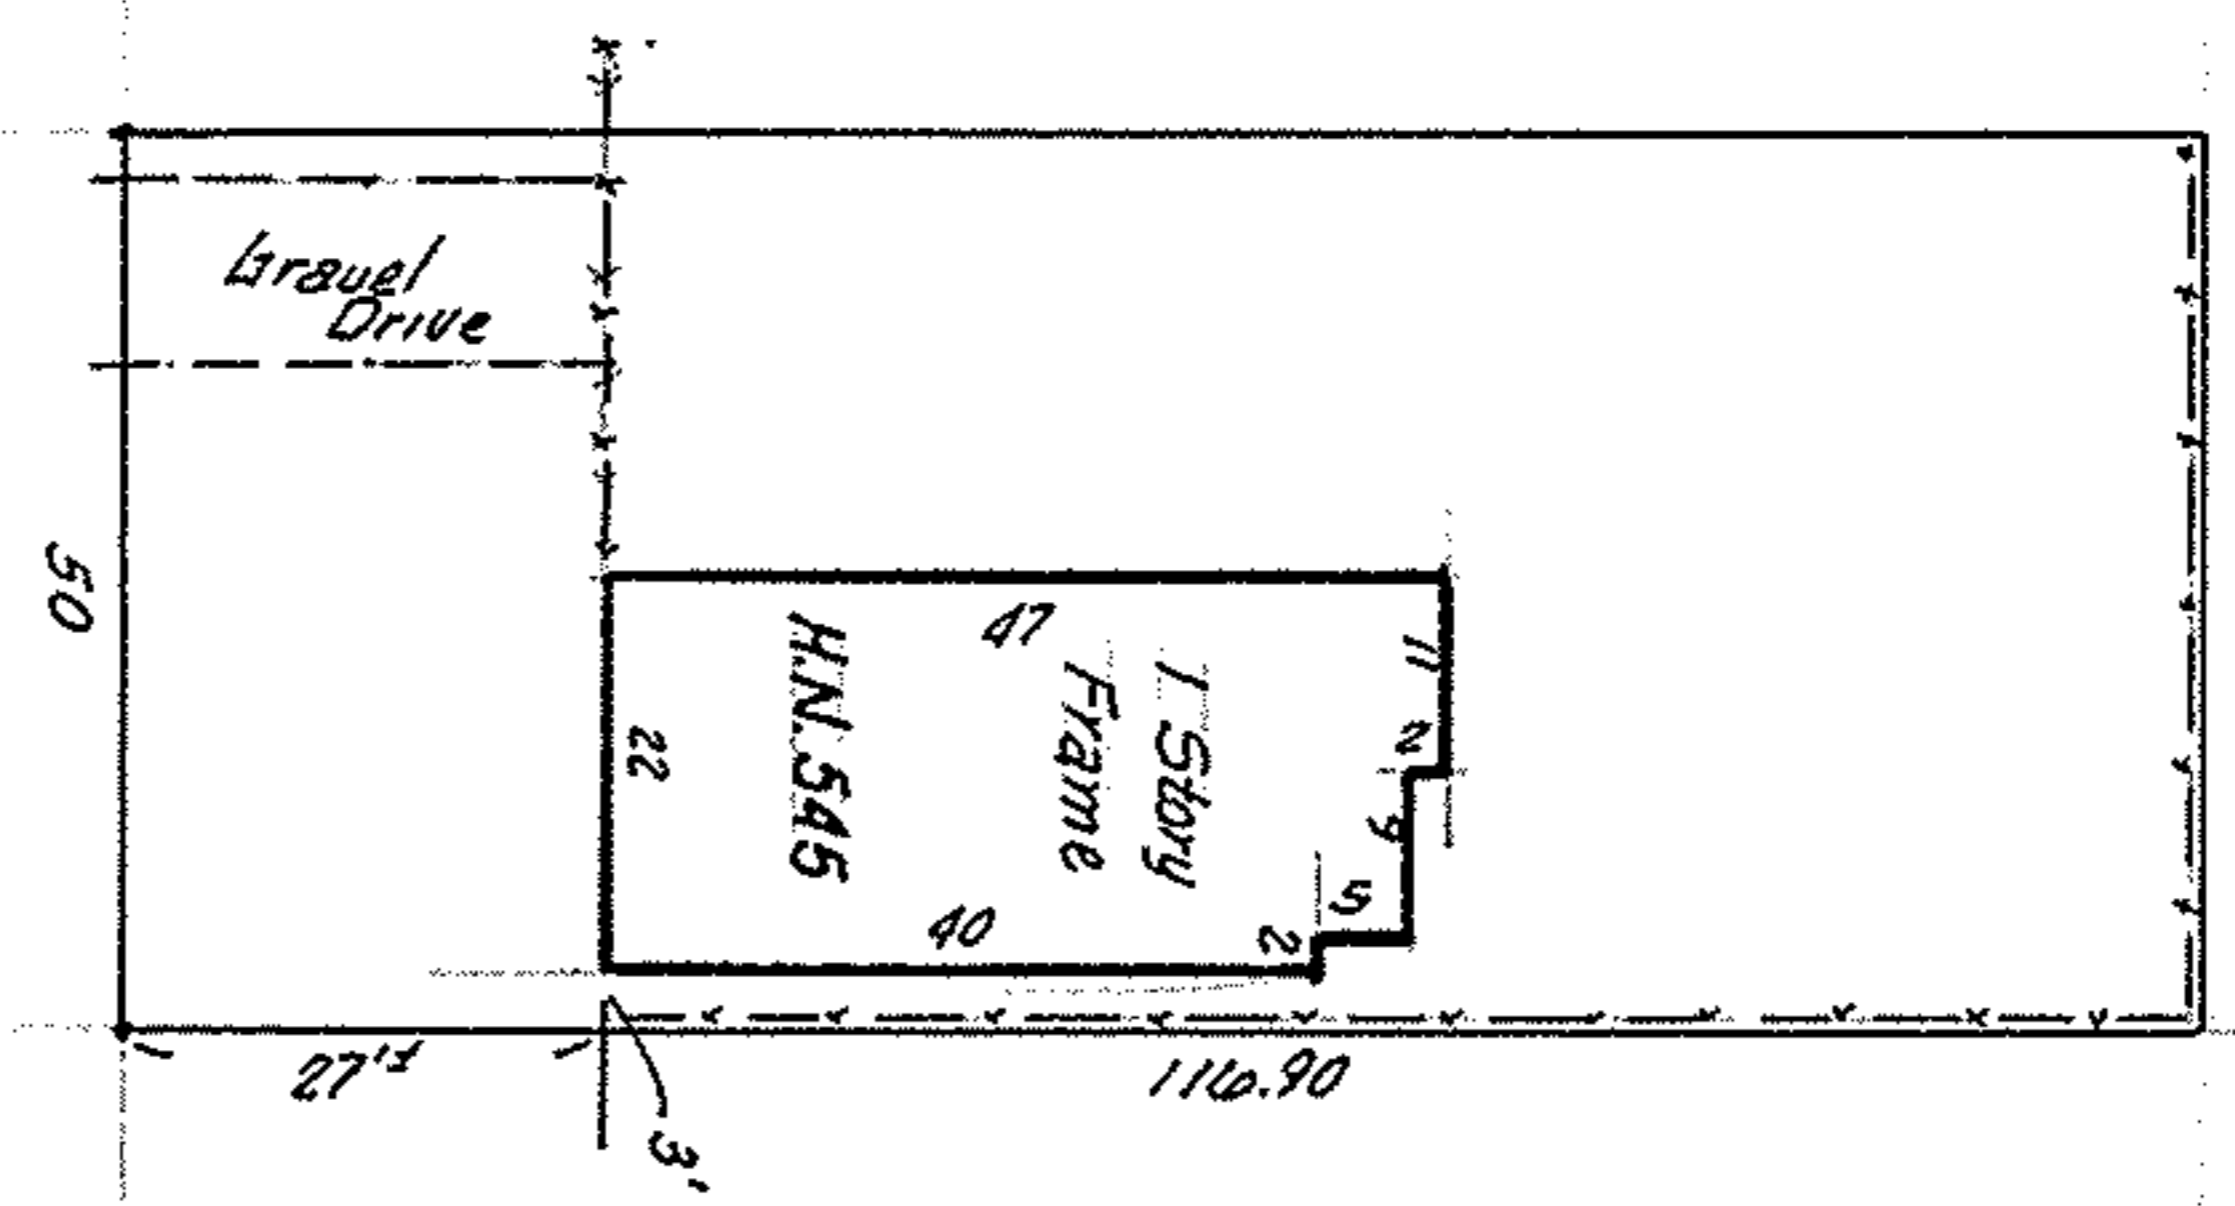


NORTH  
SCALE: 1" = 30'

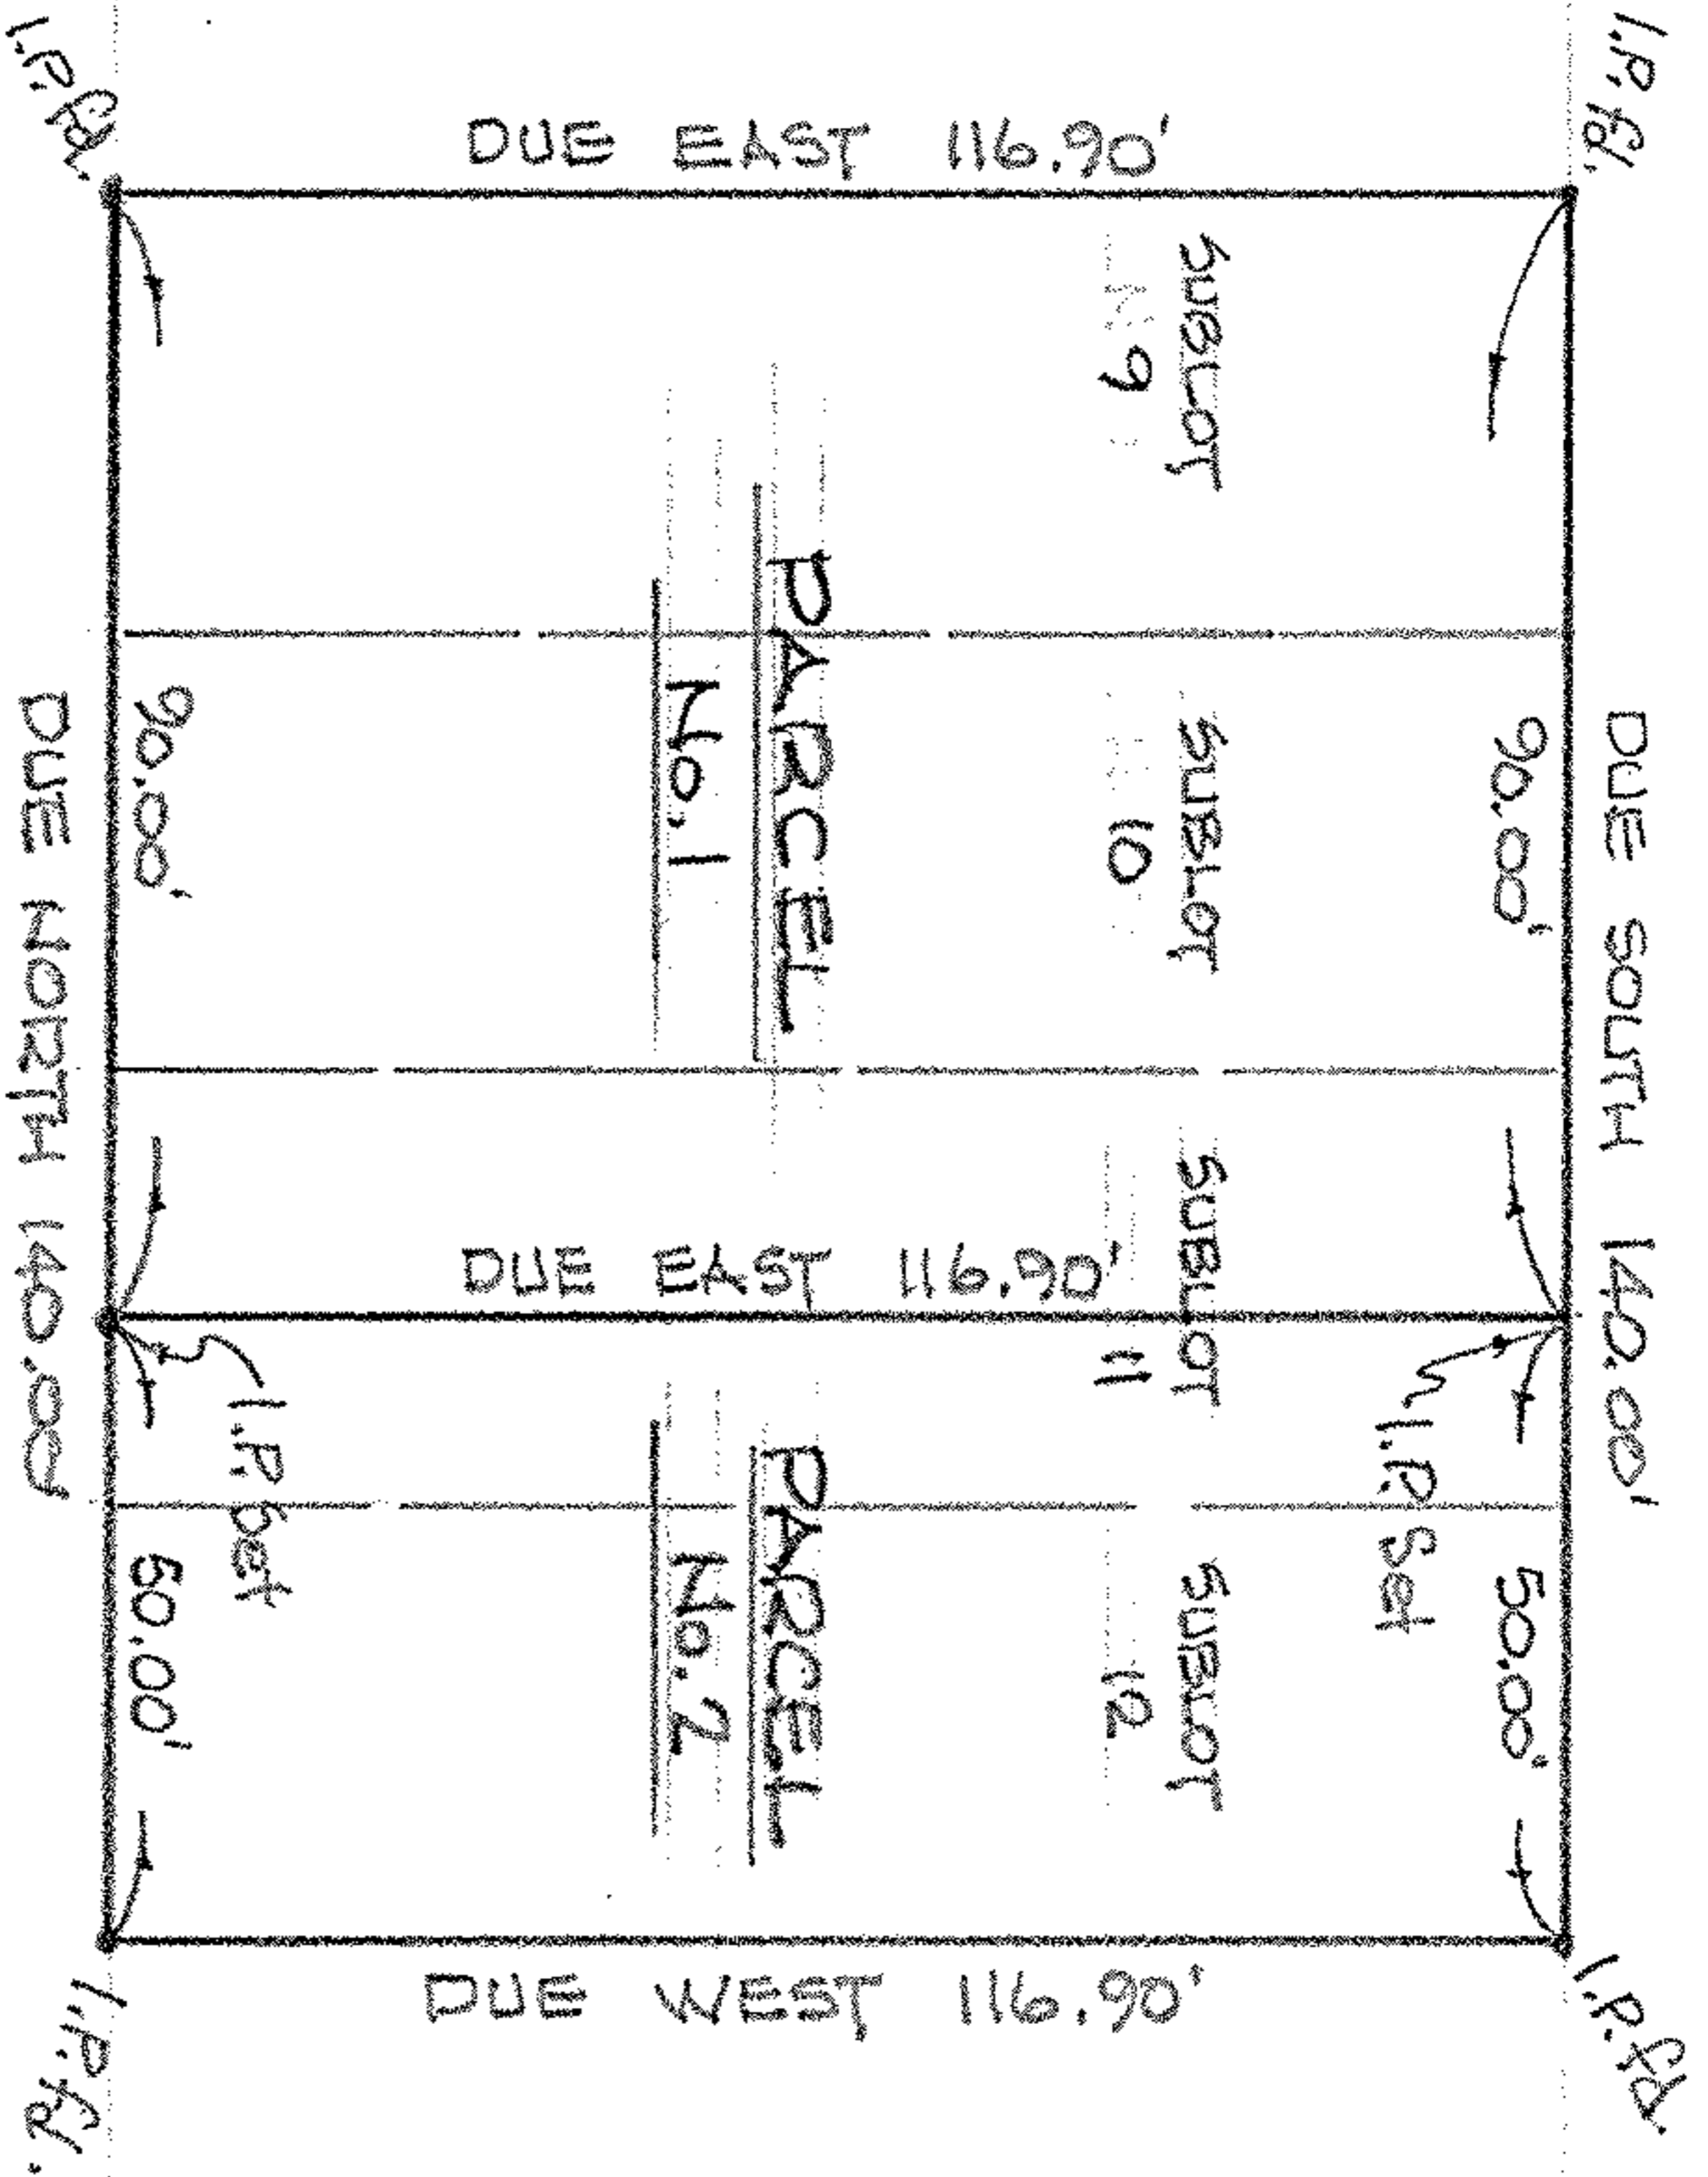

ROBINWOOD AVENUE - 50'

BUILDING LOCATION  
PARCEL No. 2  
10-15-79

MAP of PROPOSED PARCEL SPLIT

PREPARED FOR WALTER KOEHLER

SUBLOTS Nos. 9, 10, 11 & 12 in BLOCK "GC" of  
WEST SHORE SUB'D - PLOT VOL. 10, P. 6

PART of ORIG. SHEFFIELD TWP. LOT 38  
CITY of SHEFFIELD LAKE, LORAIN Co., OHIO

MEGLINCHAY & ASSOCIATES INC.,  
PROFESSIONAL ENGINEER & SURVEYORS  

AUGUST, 1979  
795743