


P.P. # 06-25-007-000-107
THE ELYRIA TELEPHONE CO
VOL 1170 PAGE 878

1"=100'

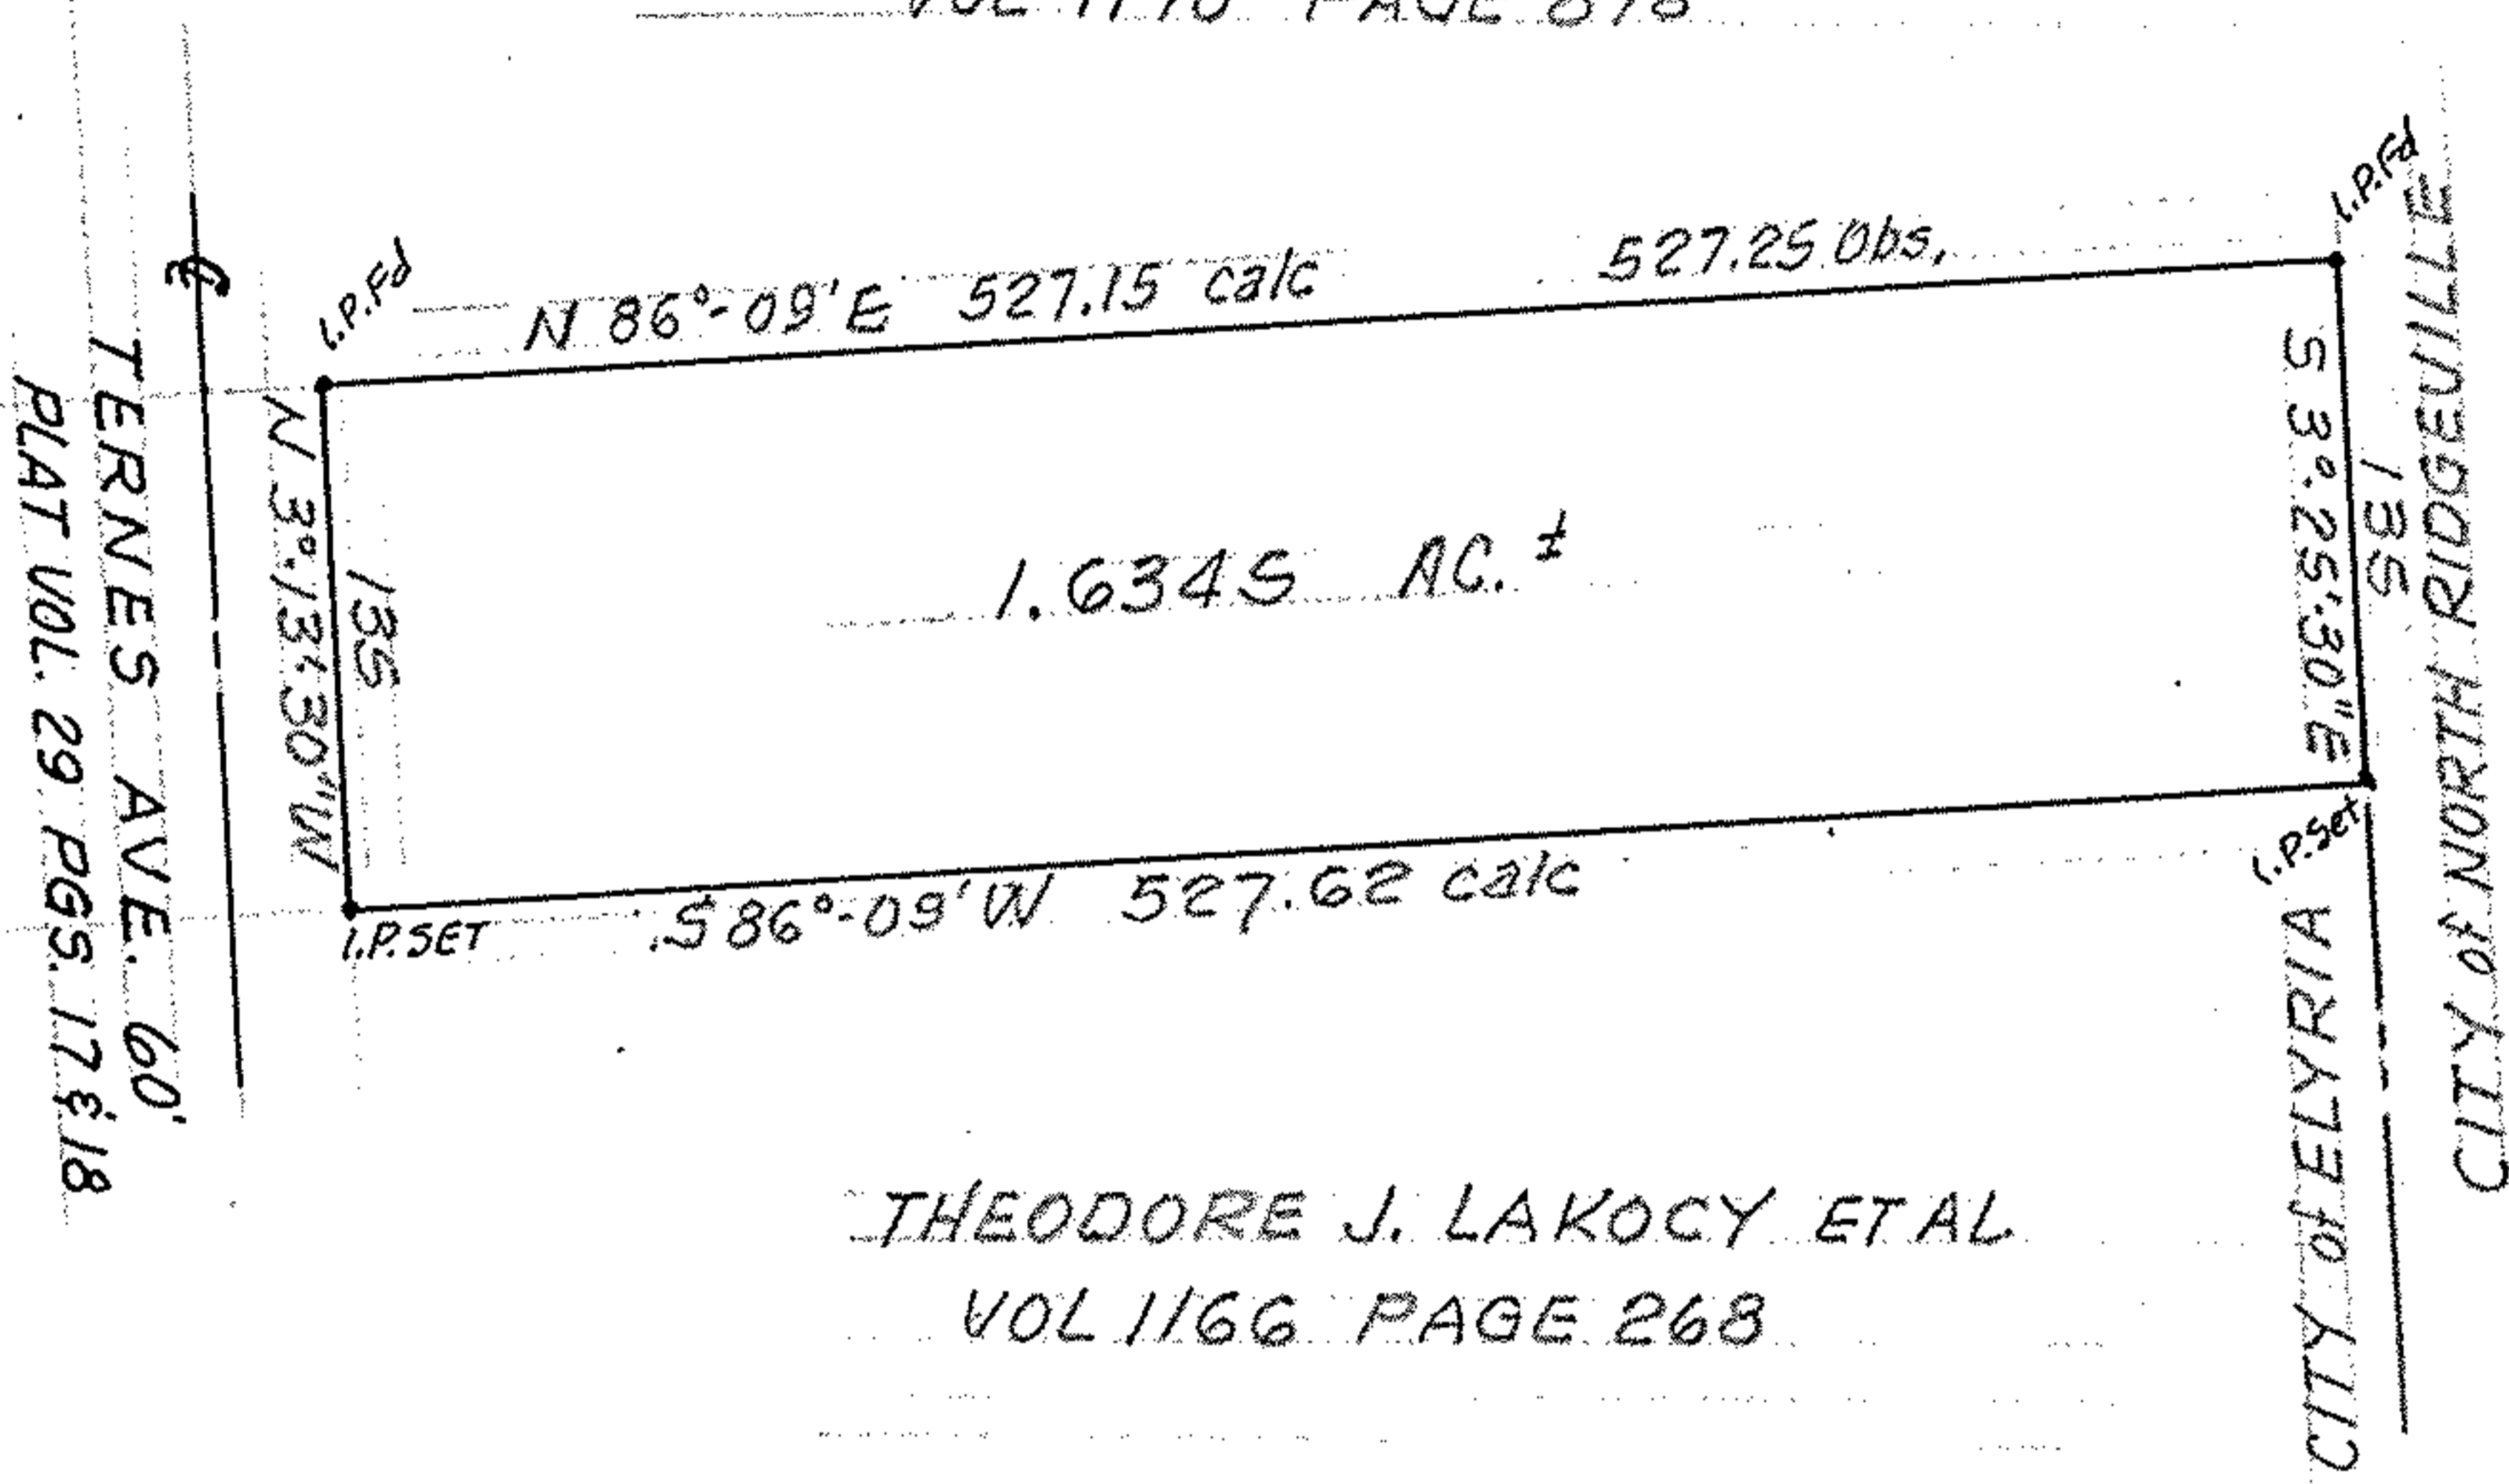

THEODORE J. LAKOCY ET AL
VOL 1166 PAGE 268

SURVEY OF PROPOSED PARCEL SPLIT
MADE AT THE INSISTENCE OF
UNION STANDARD TITLE AGENCY, INC

PART of P.P. # 06-25-007-000-108

THIS IS A PLAT OF SURVEY:

PART of ORIG. ELYRIA TWP. LOT 7-EAST of BLACK RIVER
NOW in CITY of ELYRIA, OHIO
TAX MAP PAGE 6-126

McGLINCHY & ASSOCIATES INC.

OCT. 22, 1981

#817040

UNION STD TITLE