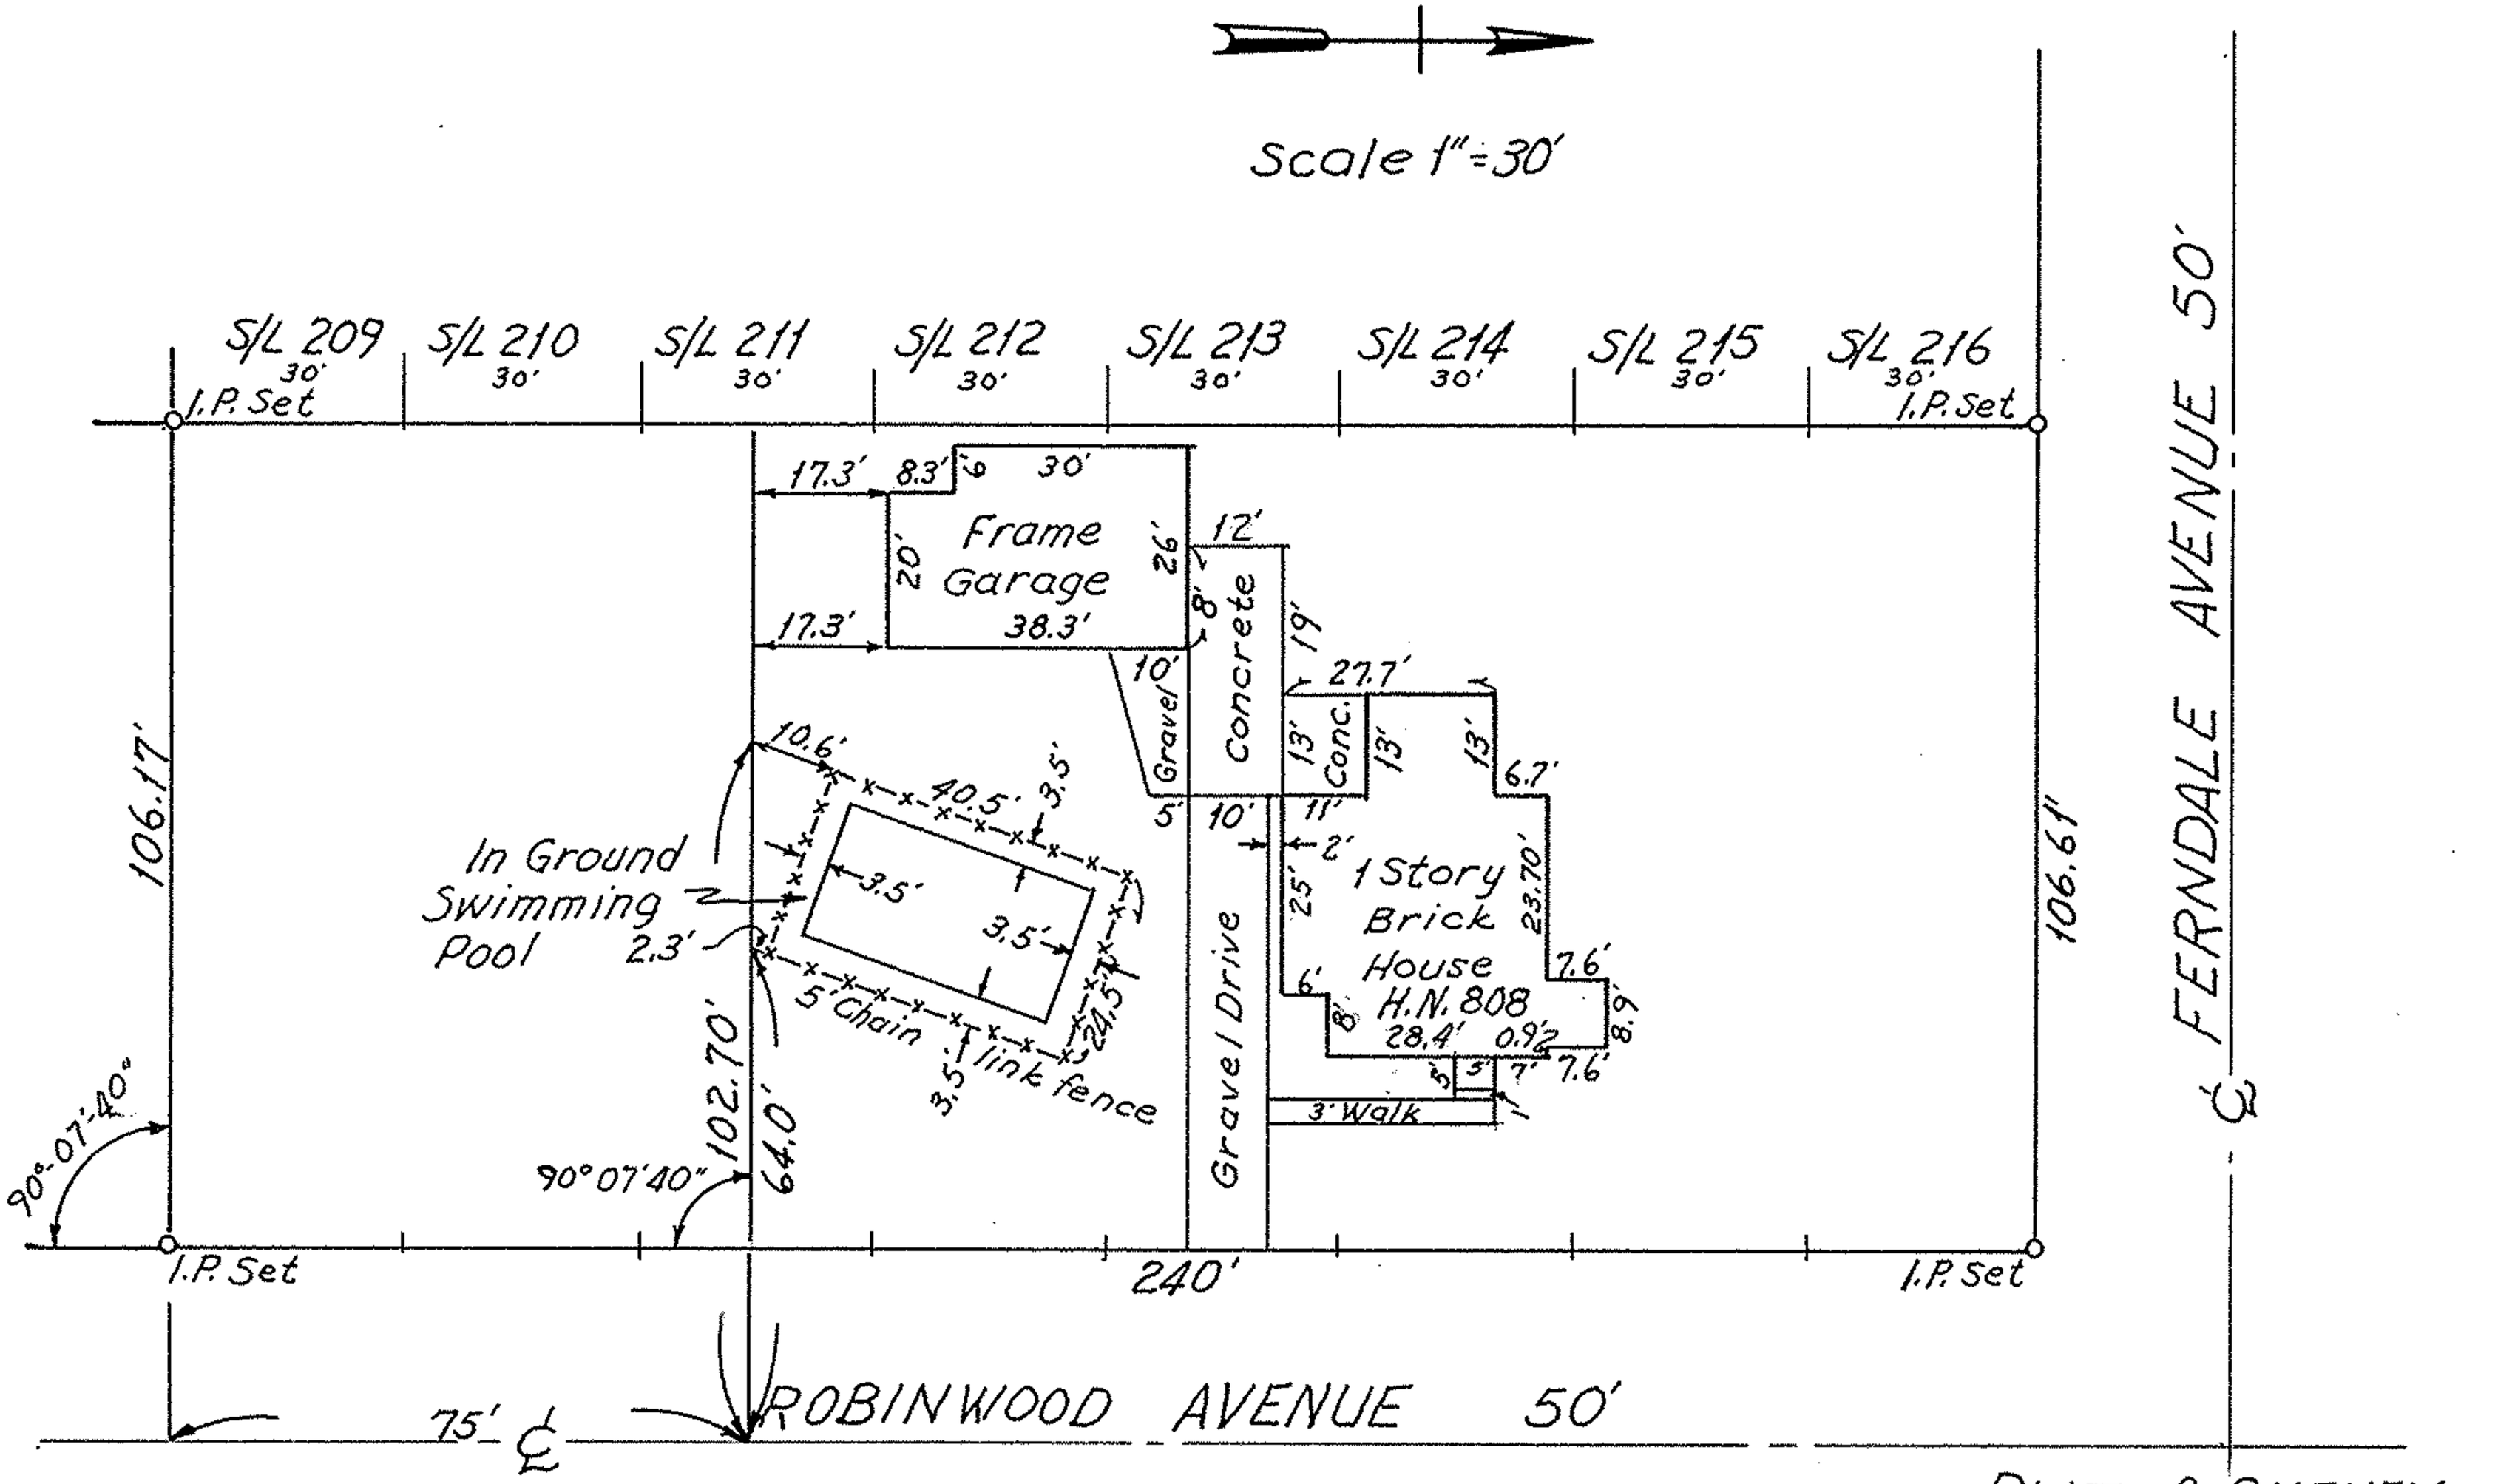

SUB LOTS 209 THRU 216 WEST SHORE SUBDIVISION
SHEFFIELD TWP. LOT 38
VOL. 10 PG. 3

PLAT of SURVEY
FOR KENT KLINGSHIRN
BY
McGLINCHY & ASSOCIATES
NOV. 21, 1979 #796072