


SCALE: 1" = 40'

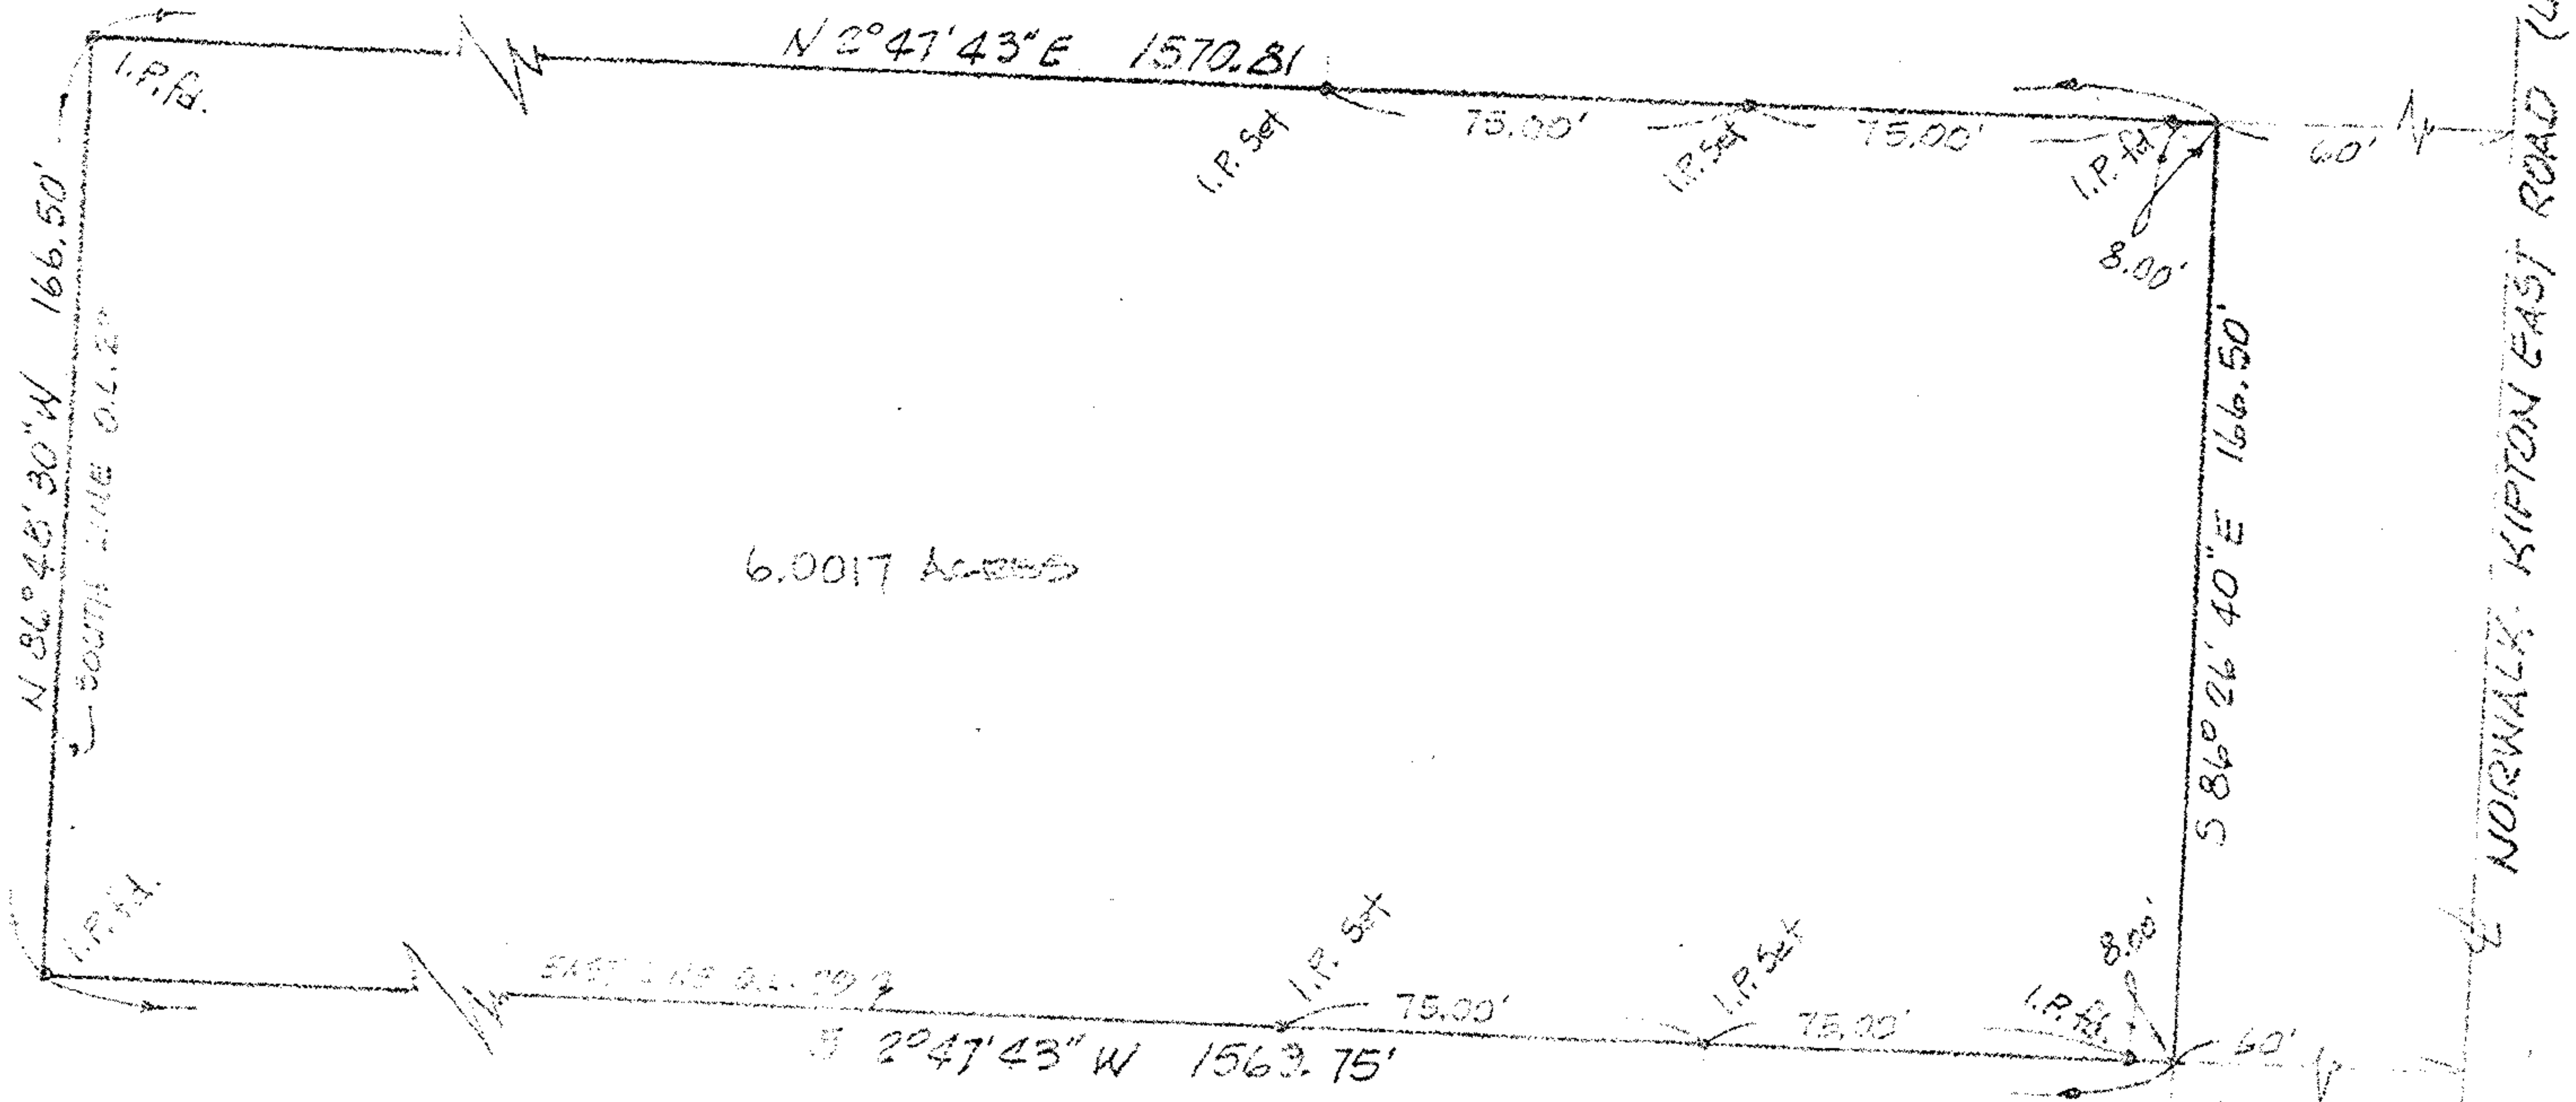

MAP of SURVEY  
 PREPARED FOR ROBERT LOPER  
 PART of ORIG. PITTSFIELD TWP. LOT 29  
 TOWNSHIP of PITTSFIELD, LORAIN CO., OHIO

McGLINCHY & ASSOCIATES INC.  
 PROFESSIONAL ENGINEER & SURVEYORS  
 ELYRIA OHIO  
 MARCH 1979 #794923