


GARGASZ INC.
VOL 1318 PG 388

GARGASZ, EDWARD & WANDA
VOL 1089 PG 932

RICHMOND, BYRD H.
& HAZEL I.
VOL 844 PG 584

MIDDLE RIDGE RD.
I.P. IN MON. BOX

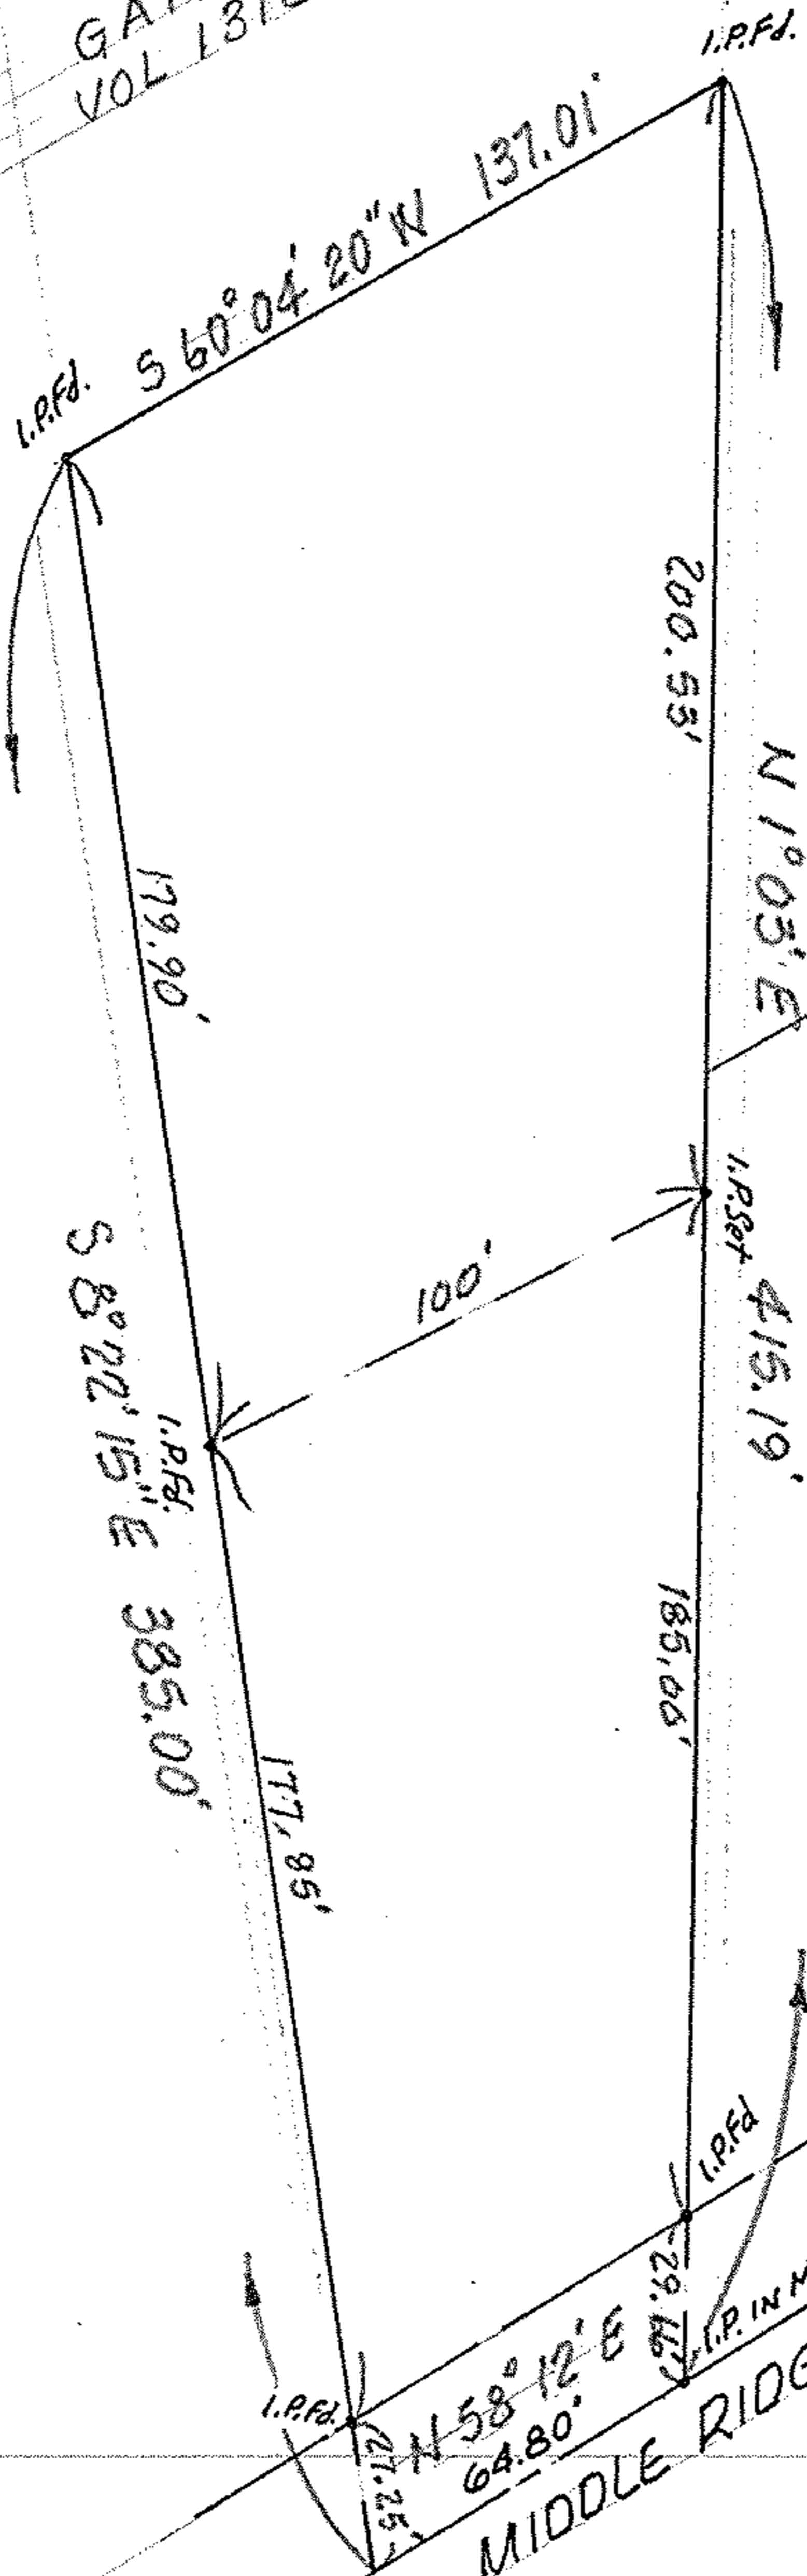

1" = 50'



PART of ORIG. AMHERST TWP. LOT 57
LORAIN COUNTY, OHIO

THIS IS A PLAT OF SURVEY:

FOR: CORINNE L. KAISER

McGLINCHY & ASSOCIATES INC.

SEPT. 1984

#848535