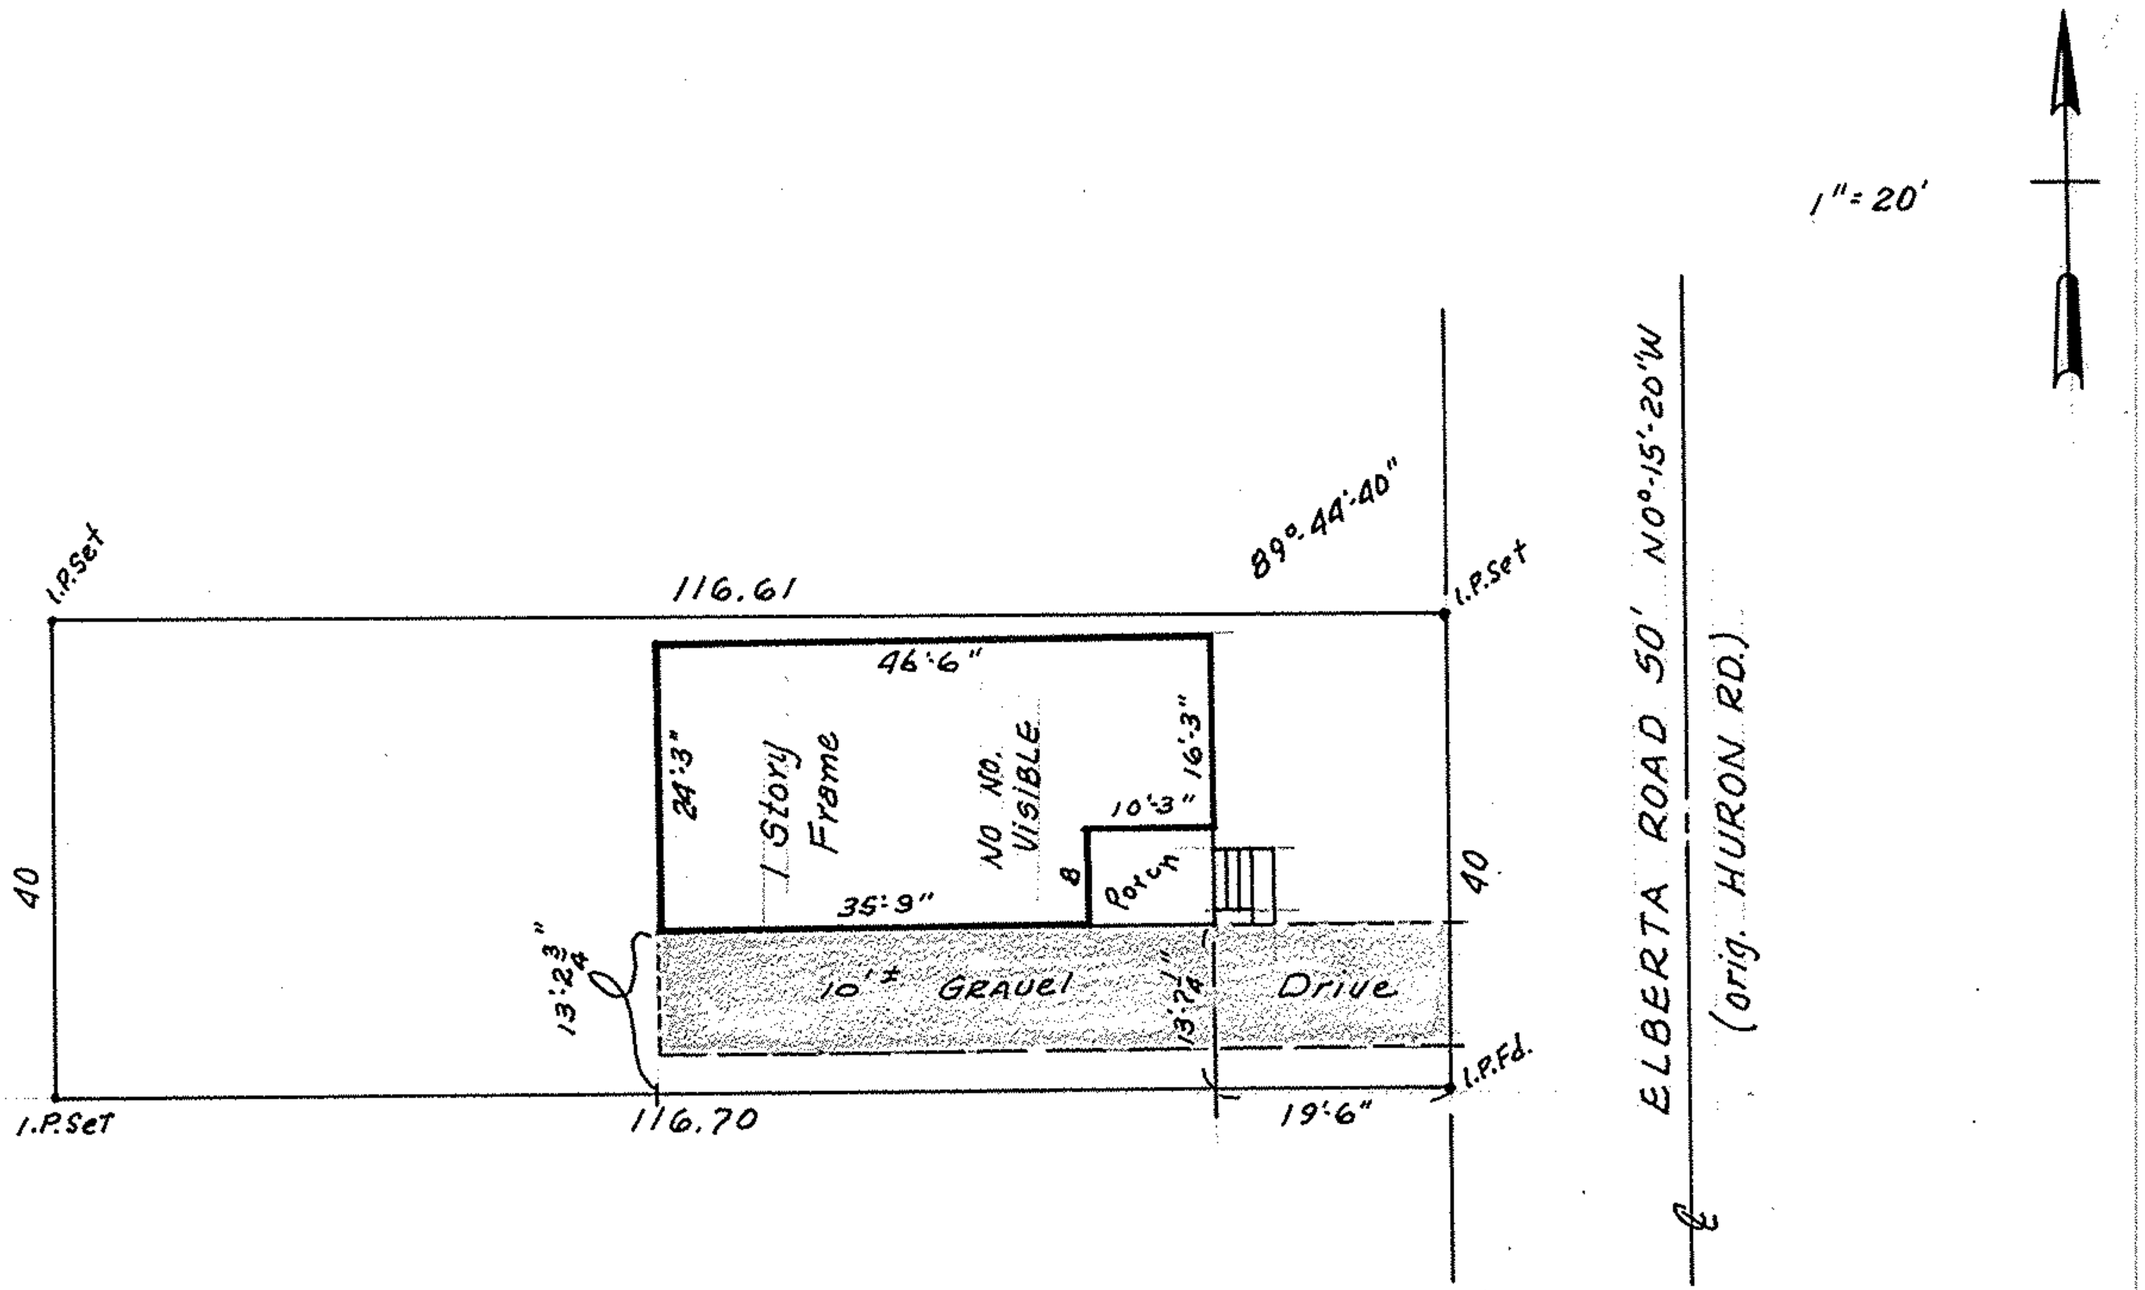

P.P. # 01-00-001-105-055
SUBLOT # 189 **of** ELBERTA BEACH SUBDIVISION

PLAT VOL. 10 **PAGES** 13 & 14
PART of ORIG. BROWNHELM **TWP. LOT** 1
NOW in CITY of VERMILION **, OHIO**

THIS IS A PLAT OF SURVEY:
FOR: MIDLAND TITLE

McGLINCHY & ASSOCIATES INC.

NOV. 6, **1984** **#**848576
MIDLAND TITLE 10-18252-E