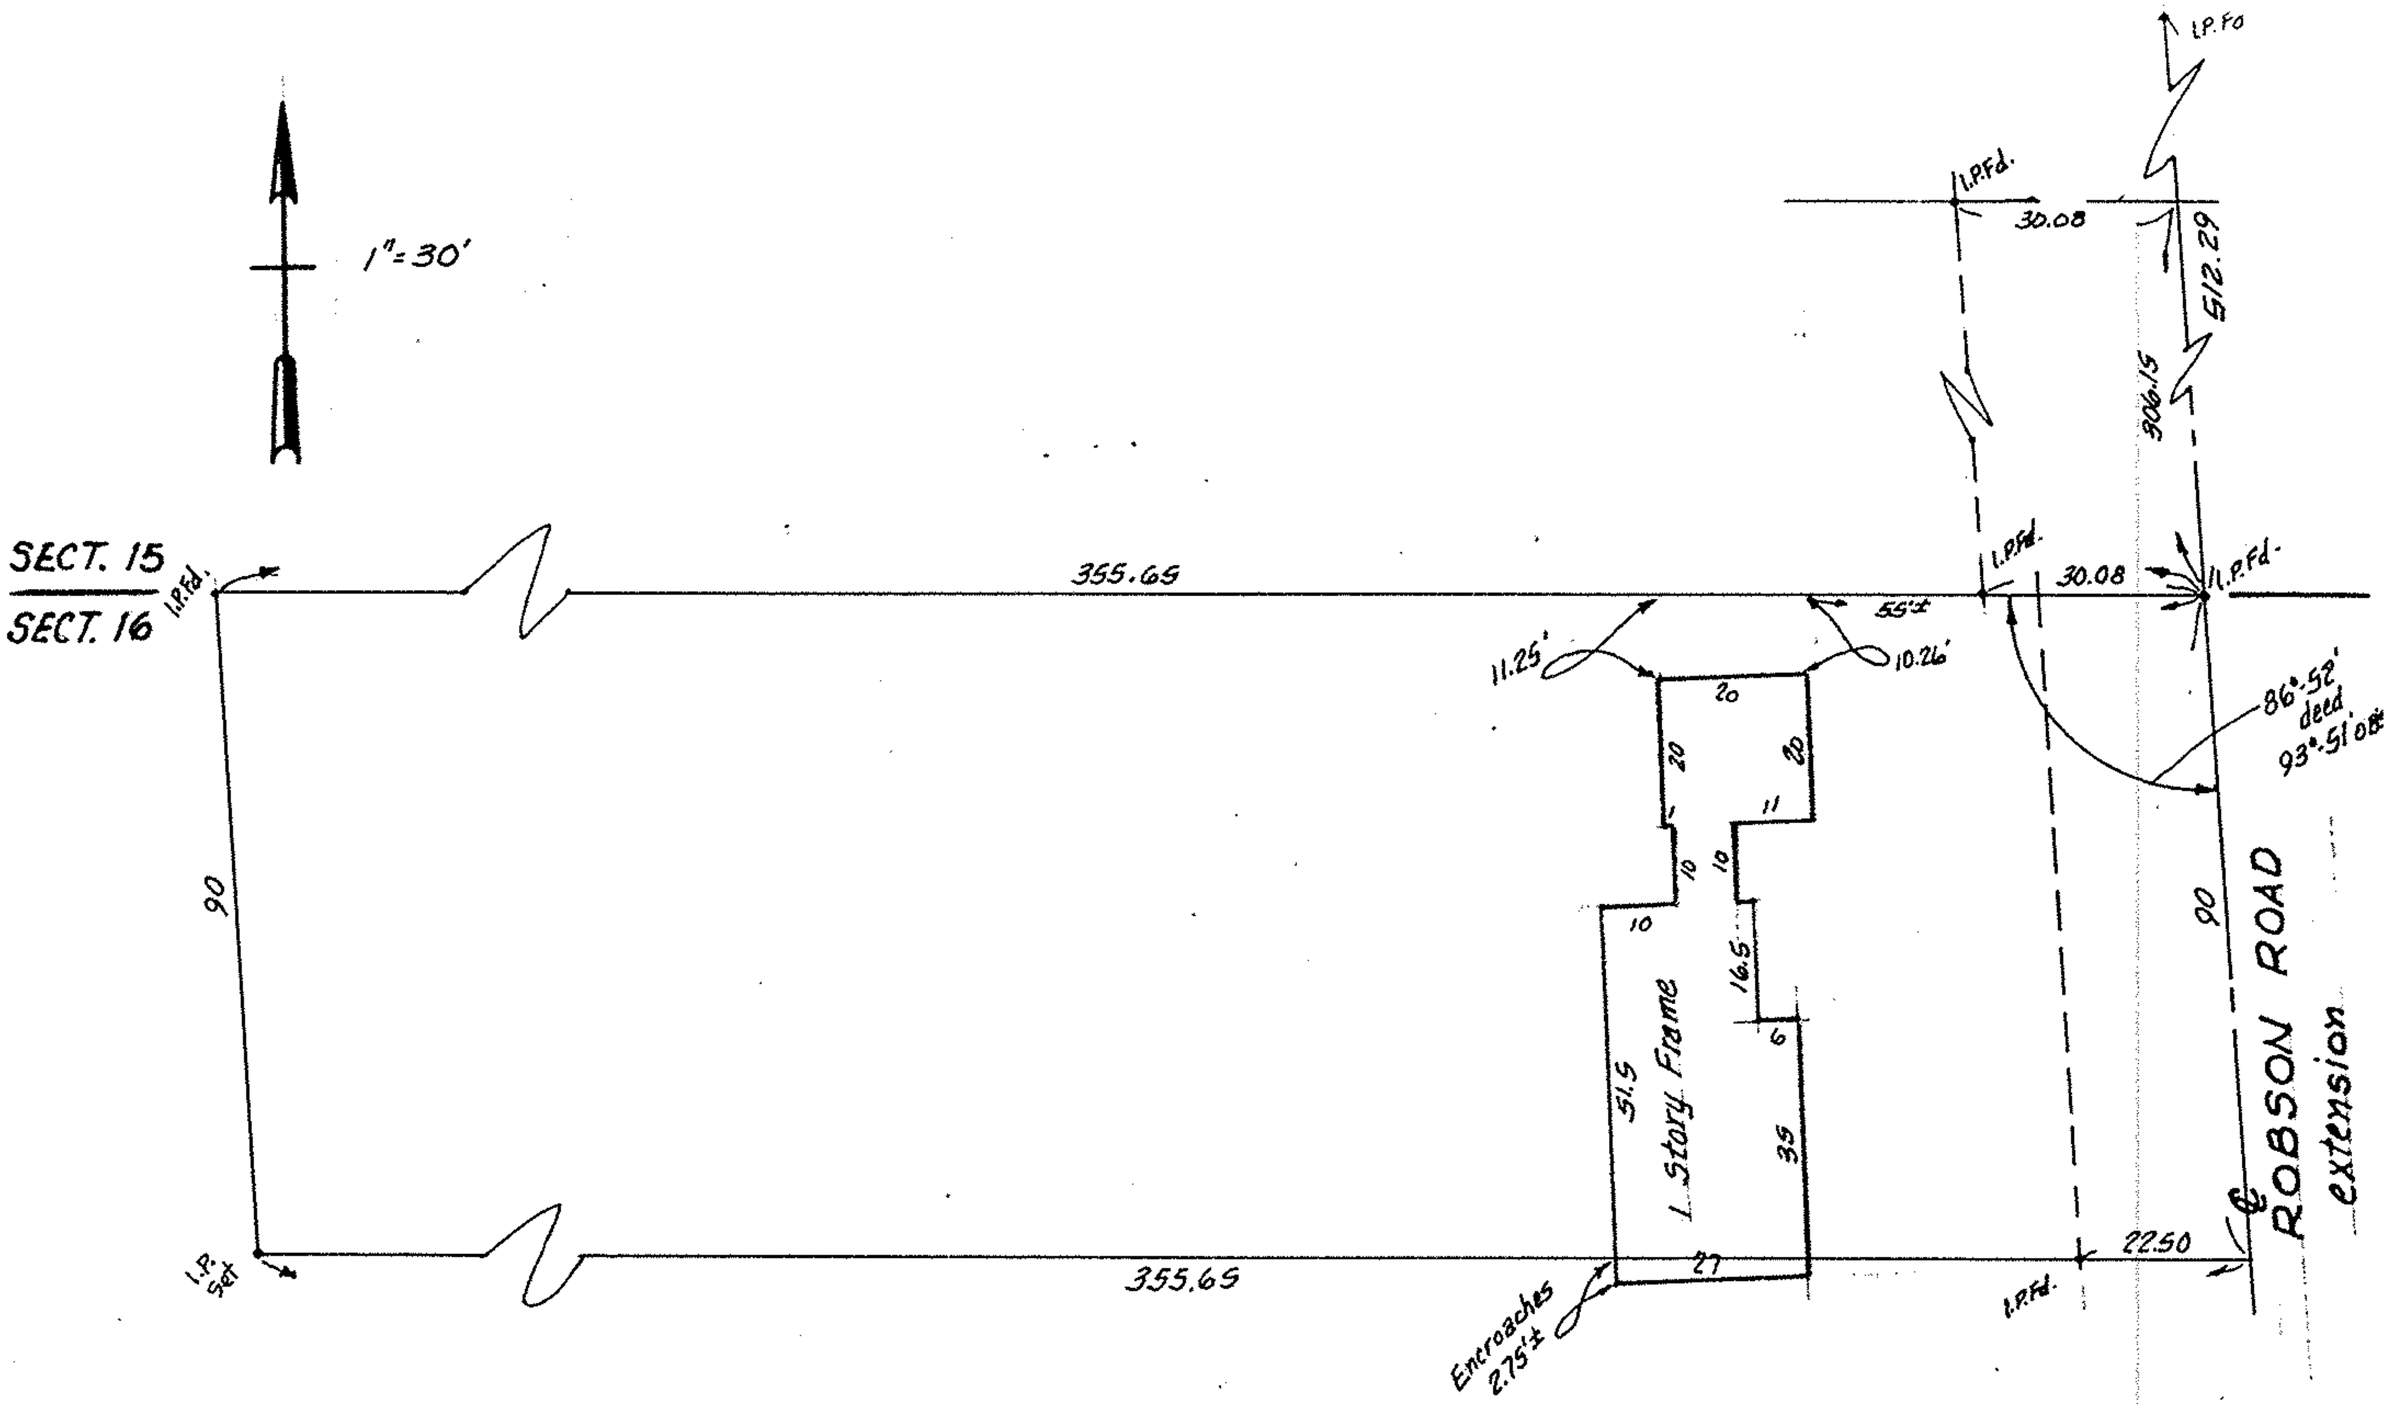

PLAT of SURVEY
P.P. #10-00-016-000-027
PART of ORIGINAL CARLISLE TWP. SECT. 16
LORAIN COUNTY, OHIO

McGLINCHY & ASSOCIATES INC.
JULY 29, 1980 #806388