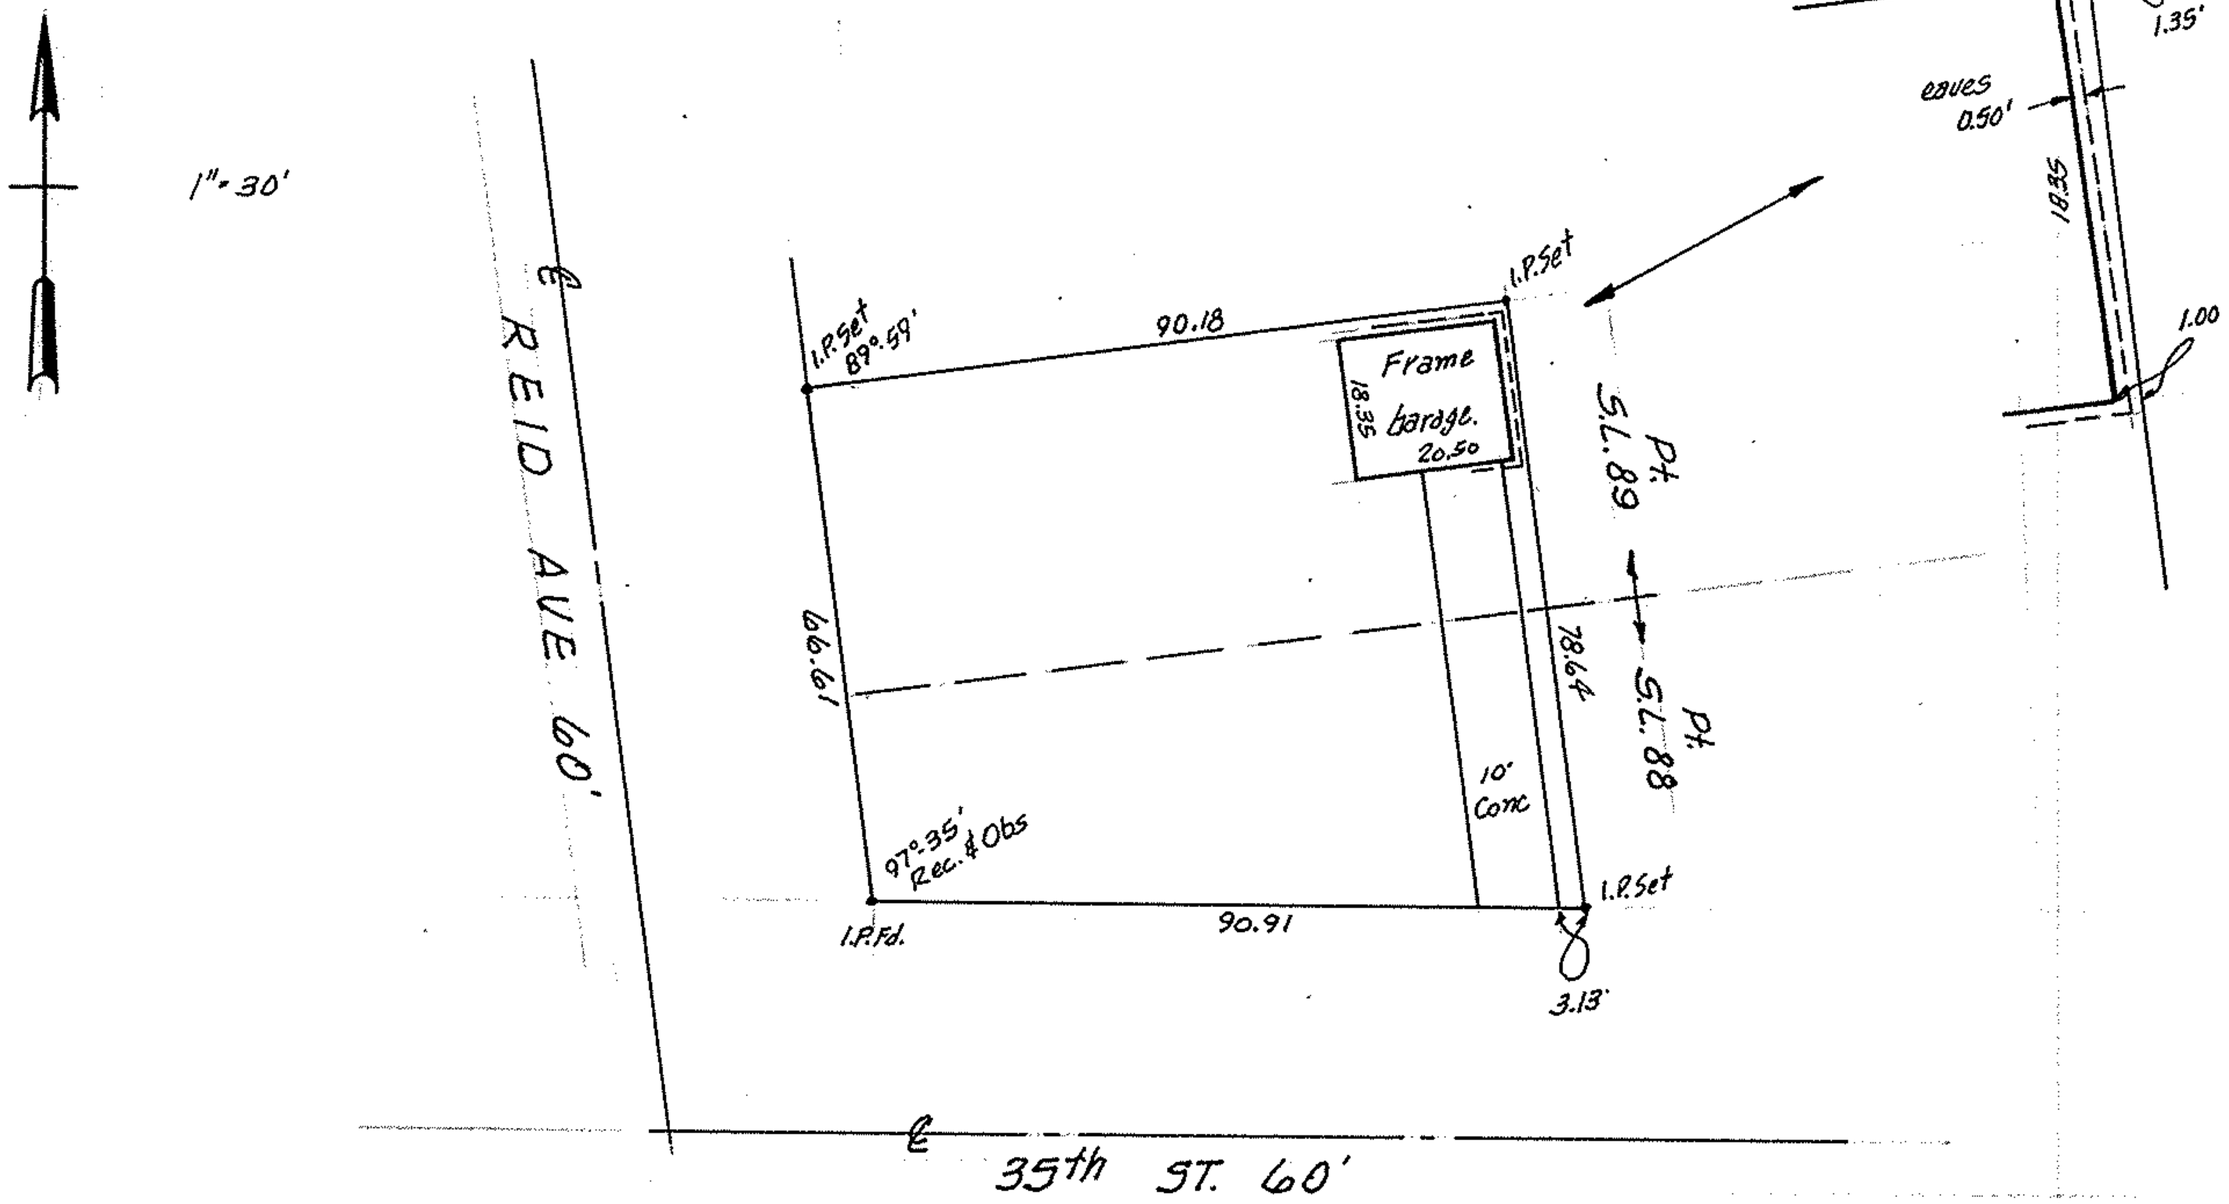

PART of P.P.# 02-01-003-234-007
SUBLOTS # 88 & 89 of the LORAIN STONE CO'S SECOND SUBD'N

PLAT VOL. 6 PAGE 38
PART of ORIG. BLACK RIVER TWP. LOT 3, TRACT 1
NOW in CITY of LORAIN , OHIO

THIS IS A PLAT OF SURVEY:
FOR THOMAS DAUGHERTY - 3455 REID AVE.
McGLINCHY & ASSOCIATES INC.
MAY 13, 1980 #806308