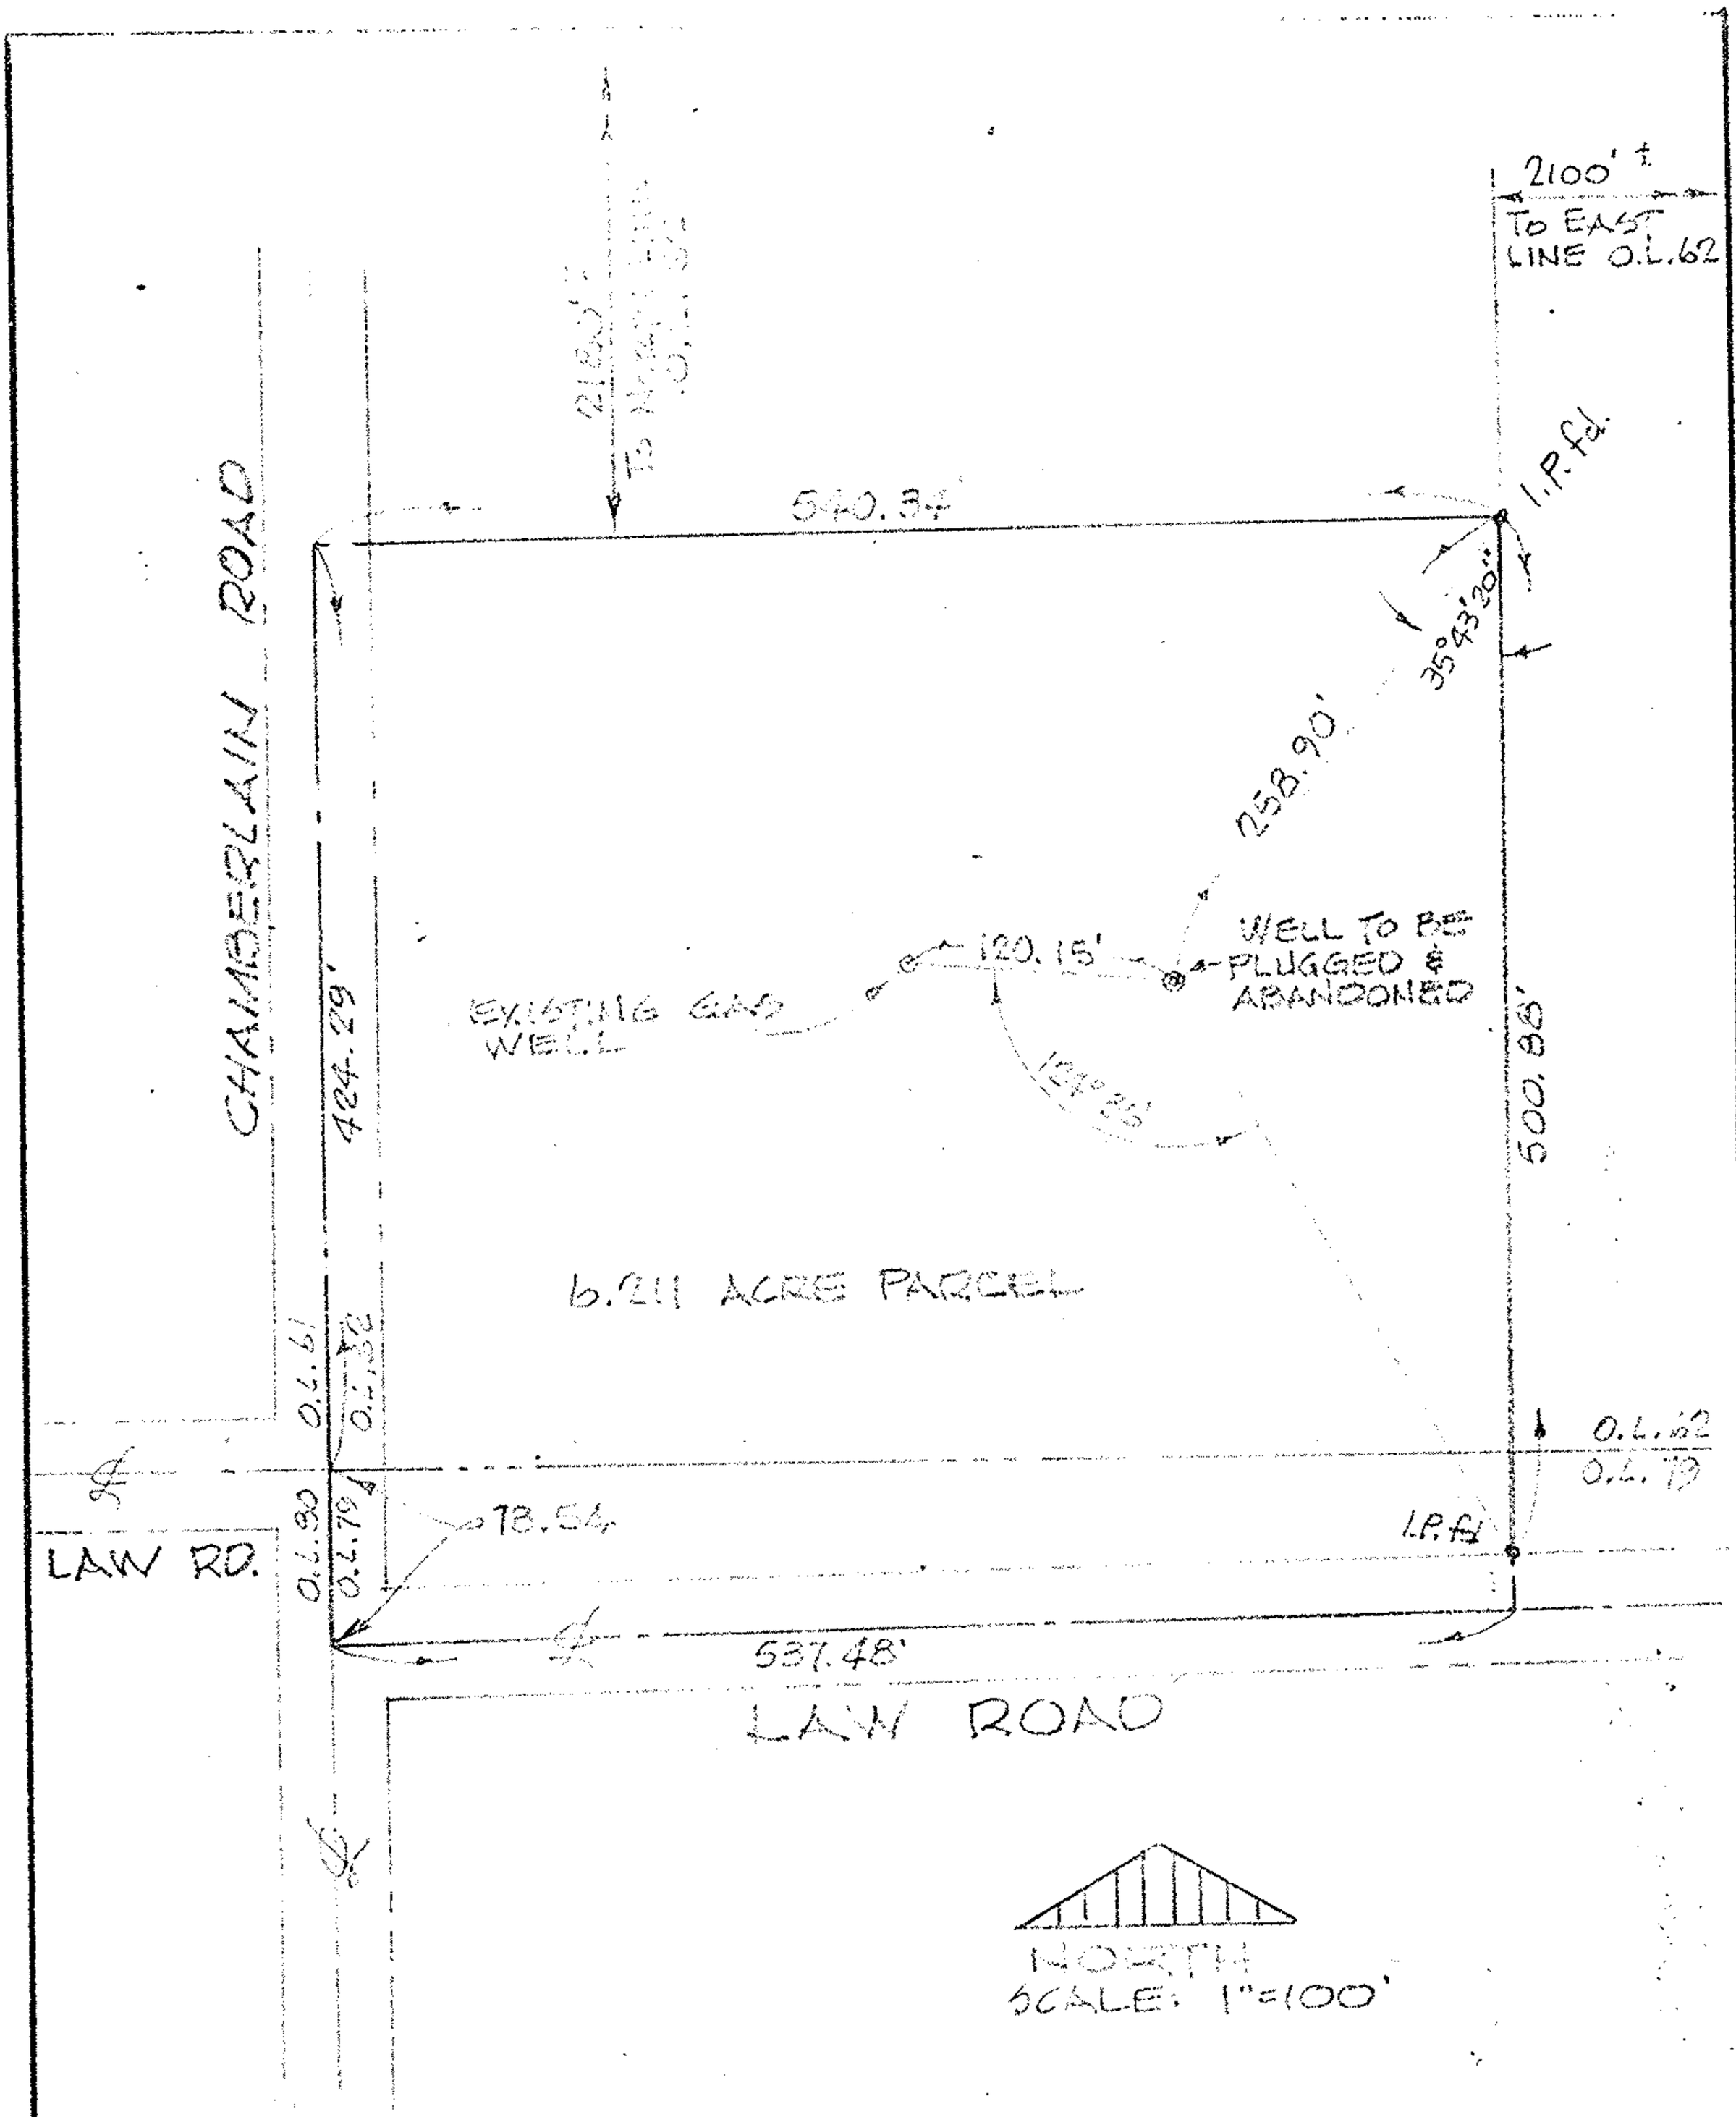

OHIO PLANE CO-ORDINATES:
N 567,500
E 2,120,700

QUADRANGLE:
LAGRANGE

Contractor BOREMAN DRILLING Co.
Address LAGRANGE, OHIO
_____ Acres _____
Well No. _____ Elevation _____
LOTS 62 & 79 Twp. GRAFTON
County LORAIN Date NOV. 26, 1979

PLAT SHOWING LOCATION OF WELL ABANDONMENT

State of Ohio
Department of Industrial Relations
Division of Mines
Columbus

CERTIFICATE OF SURVEYOR

I, the undersigned, hereby certify that this map is true and correct as required by the General Code of Ohio.

Lawrence V. MacKnight
Registered Surveyor #4900

ACKNOWLEDGED
Before me a Notary Public in and for LORAIN County, Ohio this 27th day of NOVEMBER, 1979. My commission expires APRIL 29, 1980

Notary Public

Job No. 795940 rev.