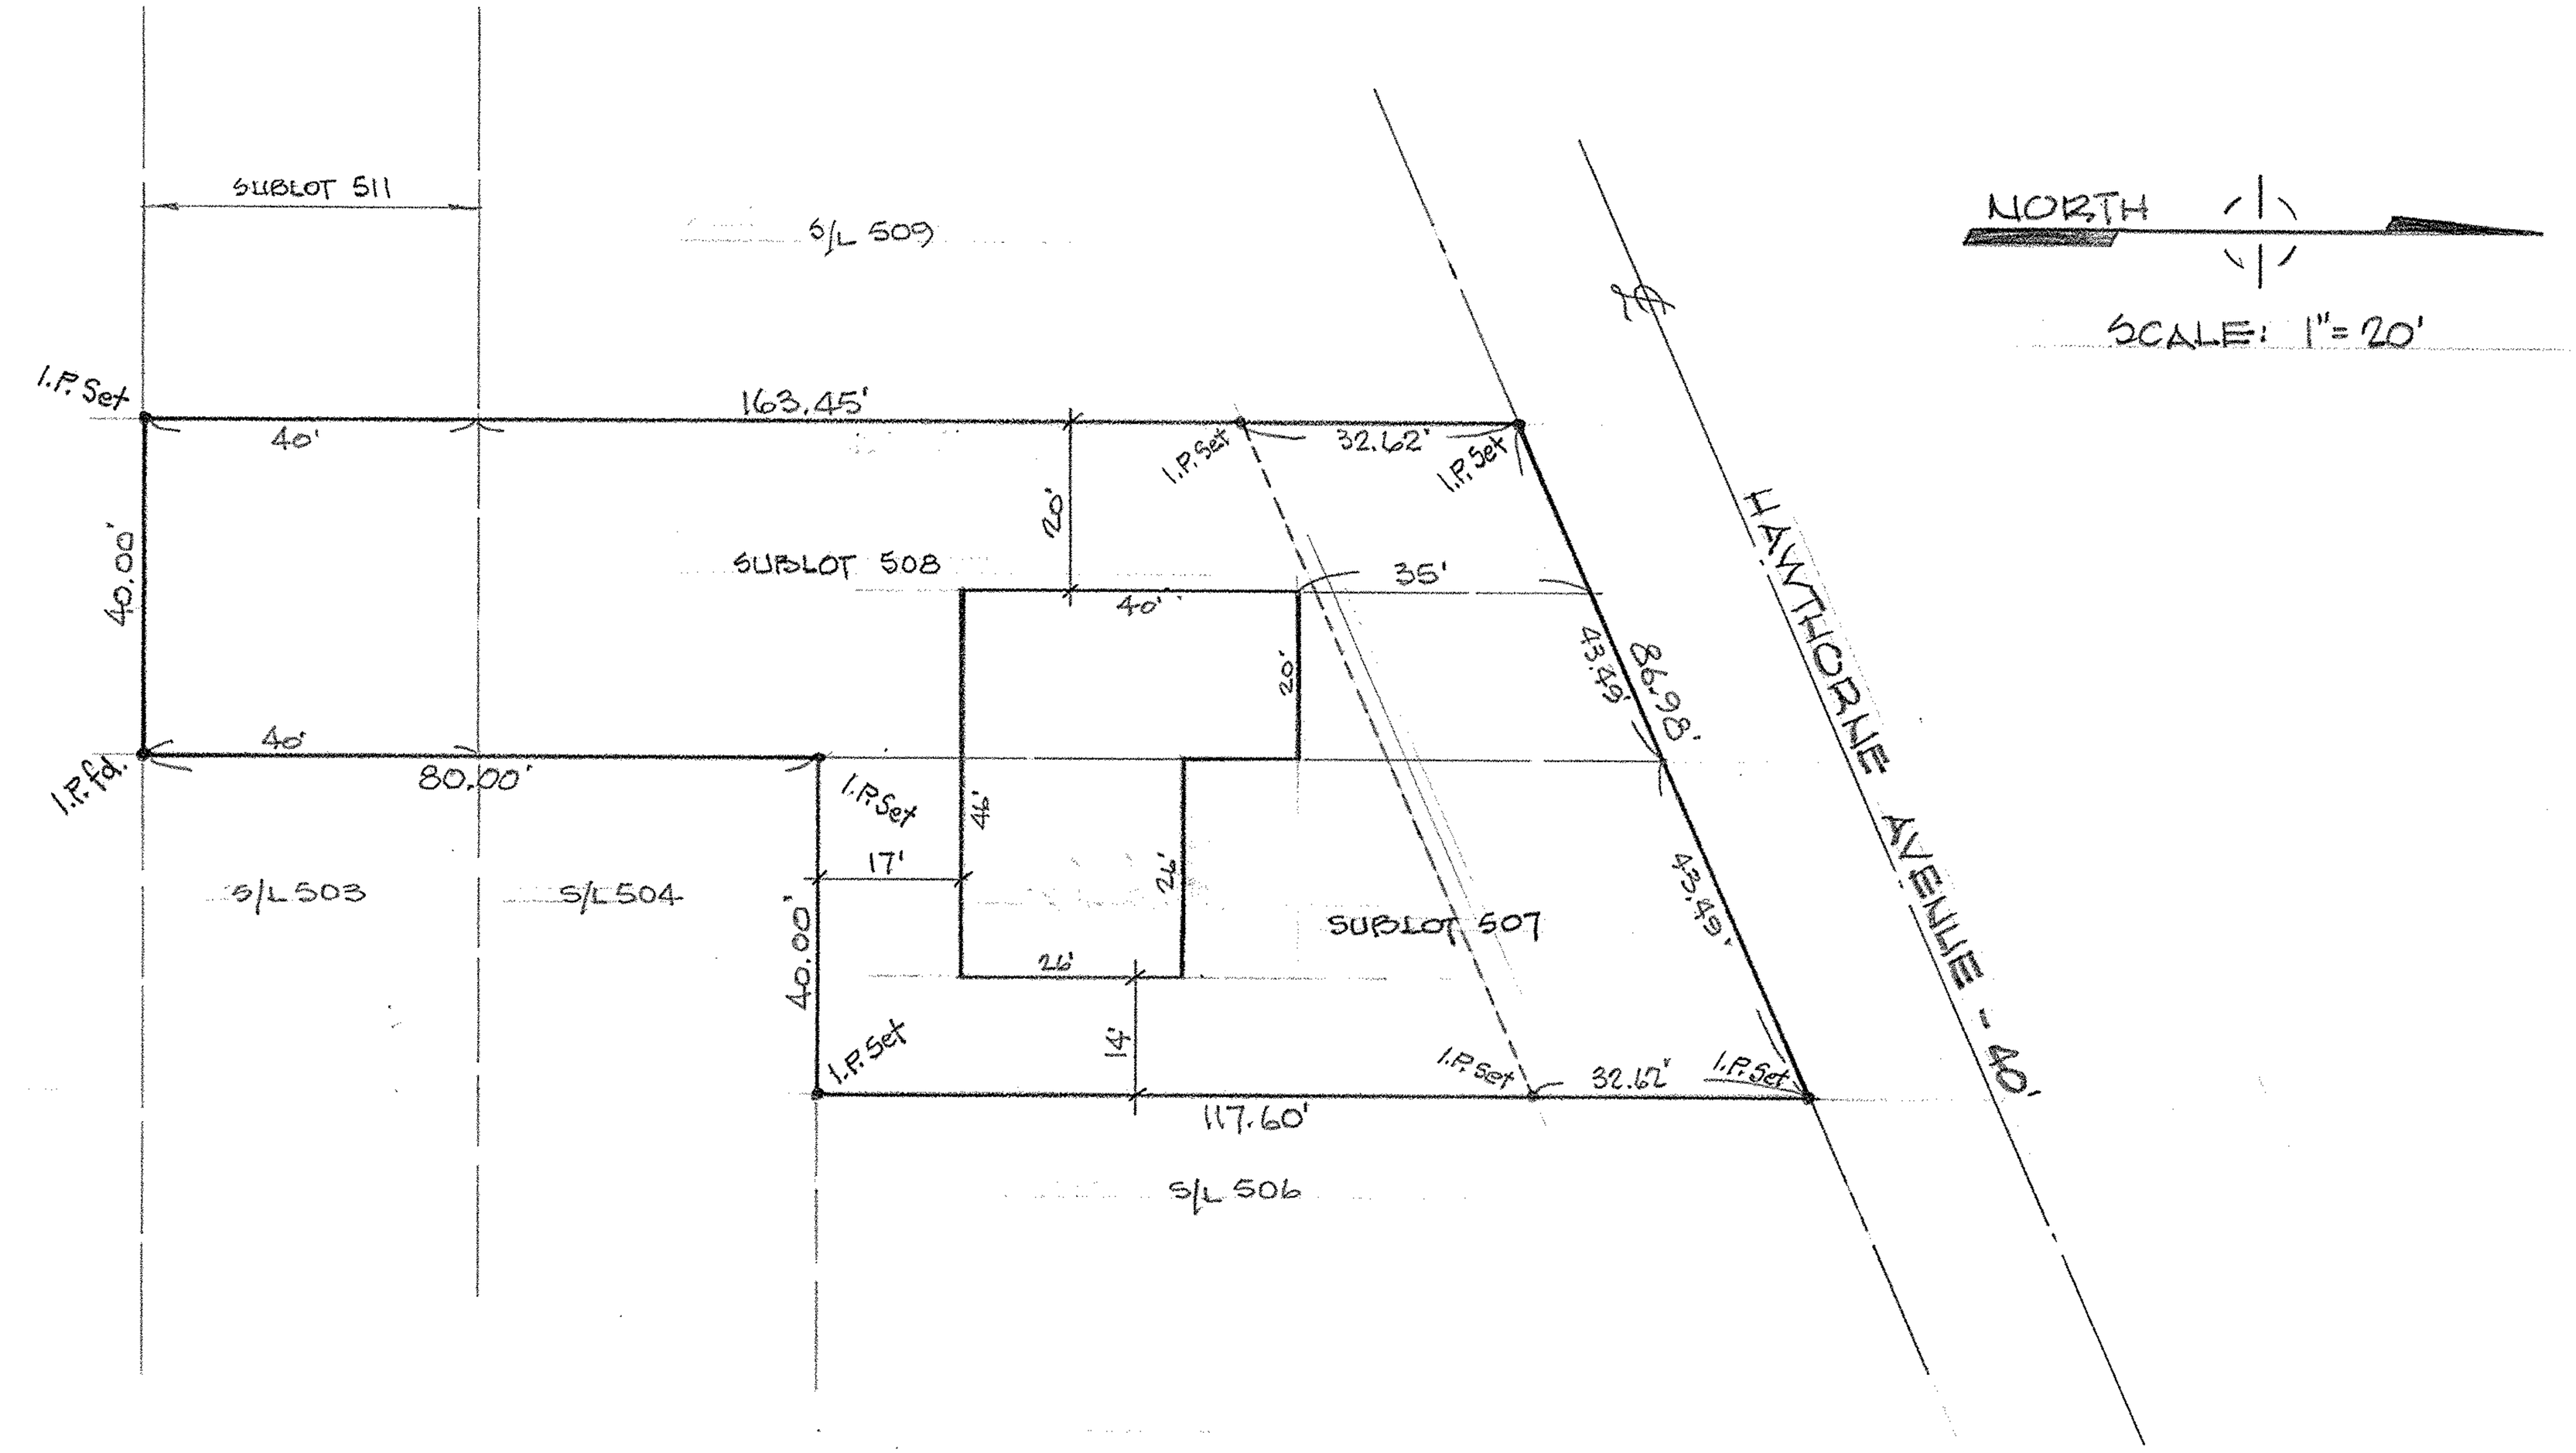

PLOT PLAN

ALL of SUBLOTS 507 & 508 and PART of
SUBLOT 511 in LAKE BREEZE ALLT.-PLAT Vol. 10, Pg. 21
PART of ORIGINAL SHEFFIELD TWP. LOT No. 42
CITY of SHEFFIELD LAKE, LORAIN CO., OHIO

McGLINCHY & ASSOCIATES
PROFESSIONAL ENGINEER & SURVEYORS
ELYRIA OHIO
MAY, 1977 #795305