


FIELD LAYOUT of RICHELIEU AVENUE & BUCKEYE DRIVE INTERSECTION

REQUESTED BY and PREPARED FOR
 CITY of SHEFFIELD LAKE ZONING BOARD of APPEALS

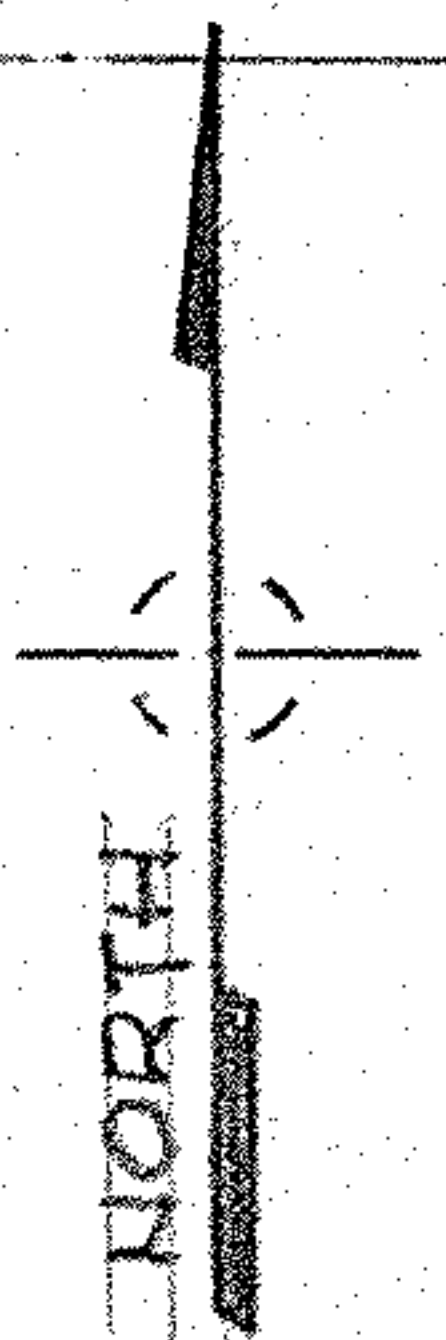

SCALE: 1" = 20'

McGLINCHY and ASSOCIATES INC.
 PROFESSIONAL ENGINEER and SURVEYORS
 538 W. BROAD ST. ELYRIA OHIO
 JULY, 1979 #795617