





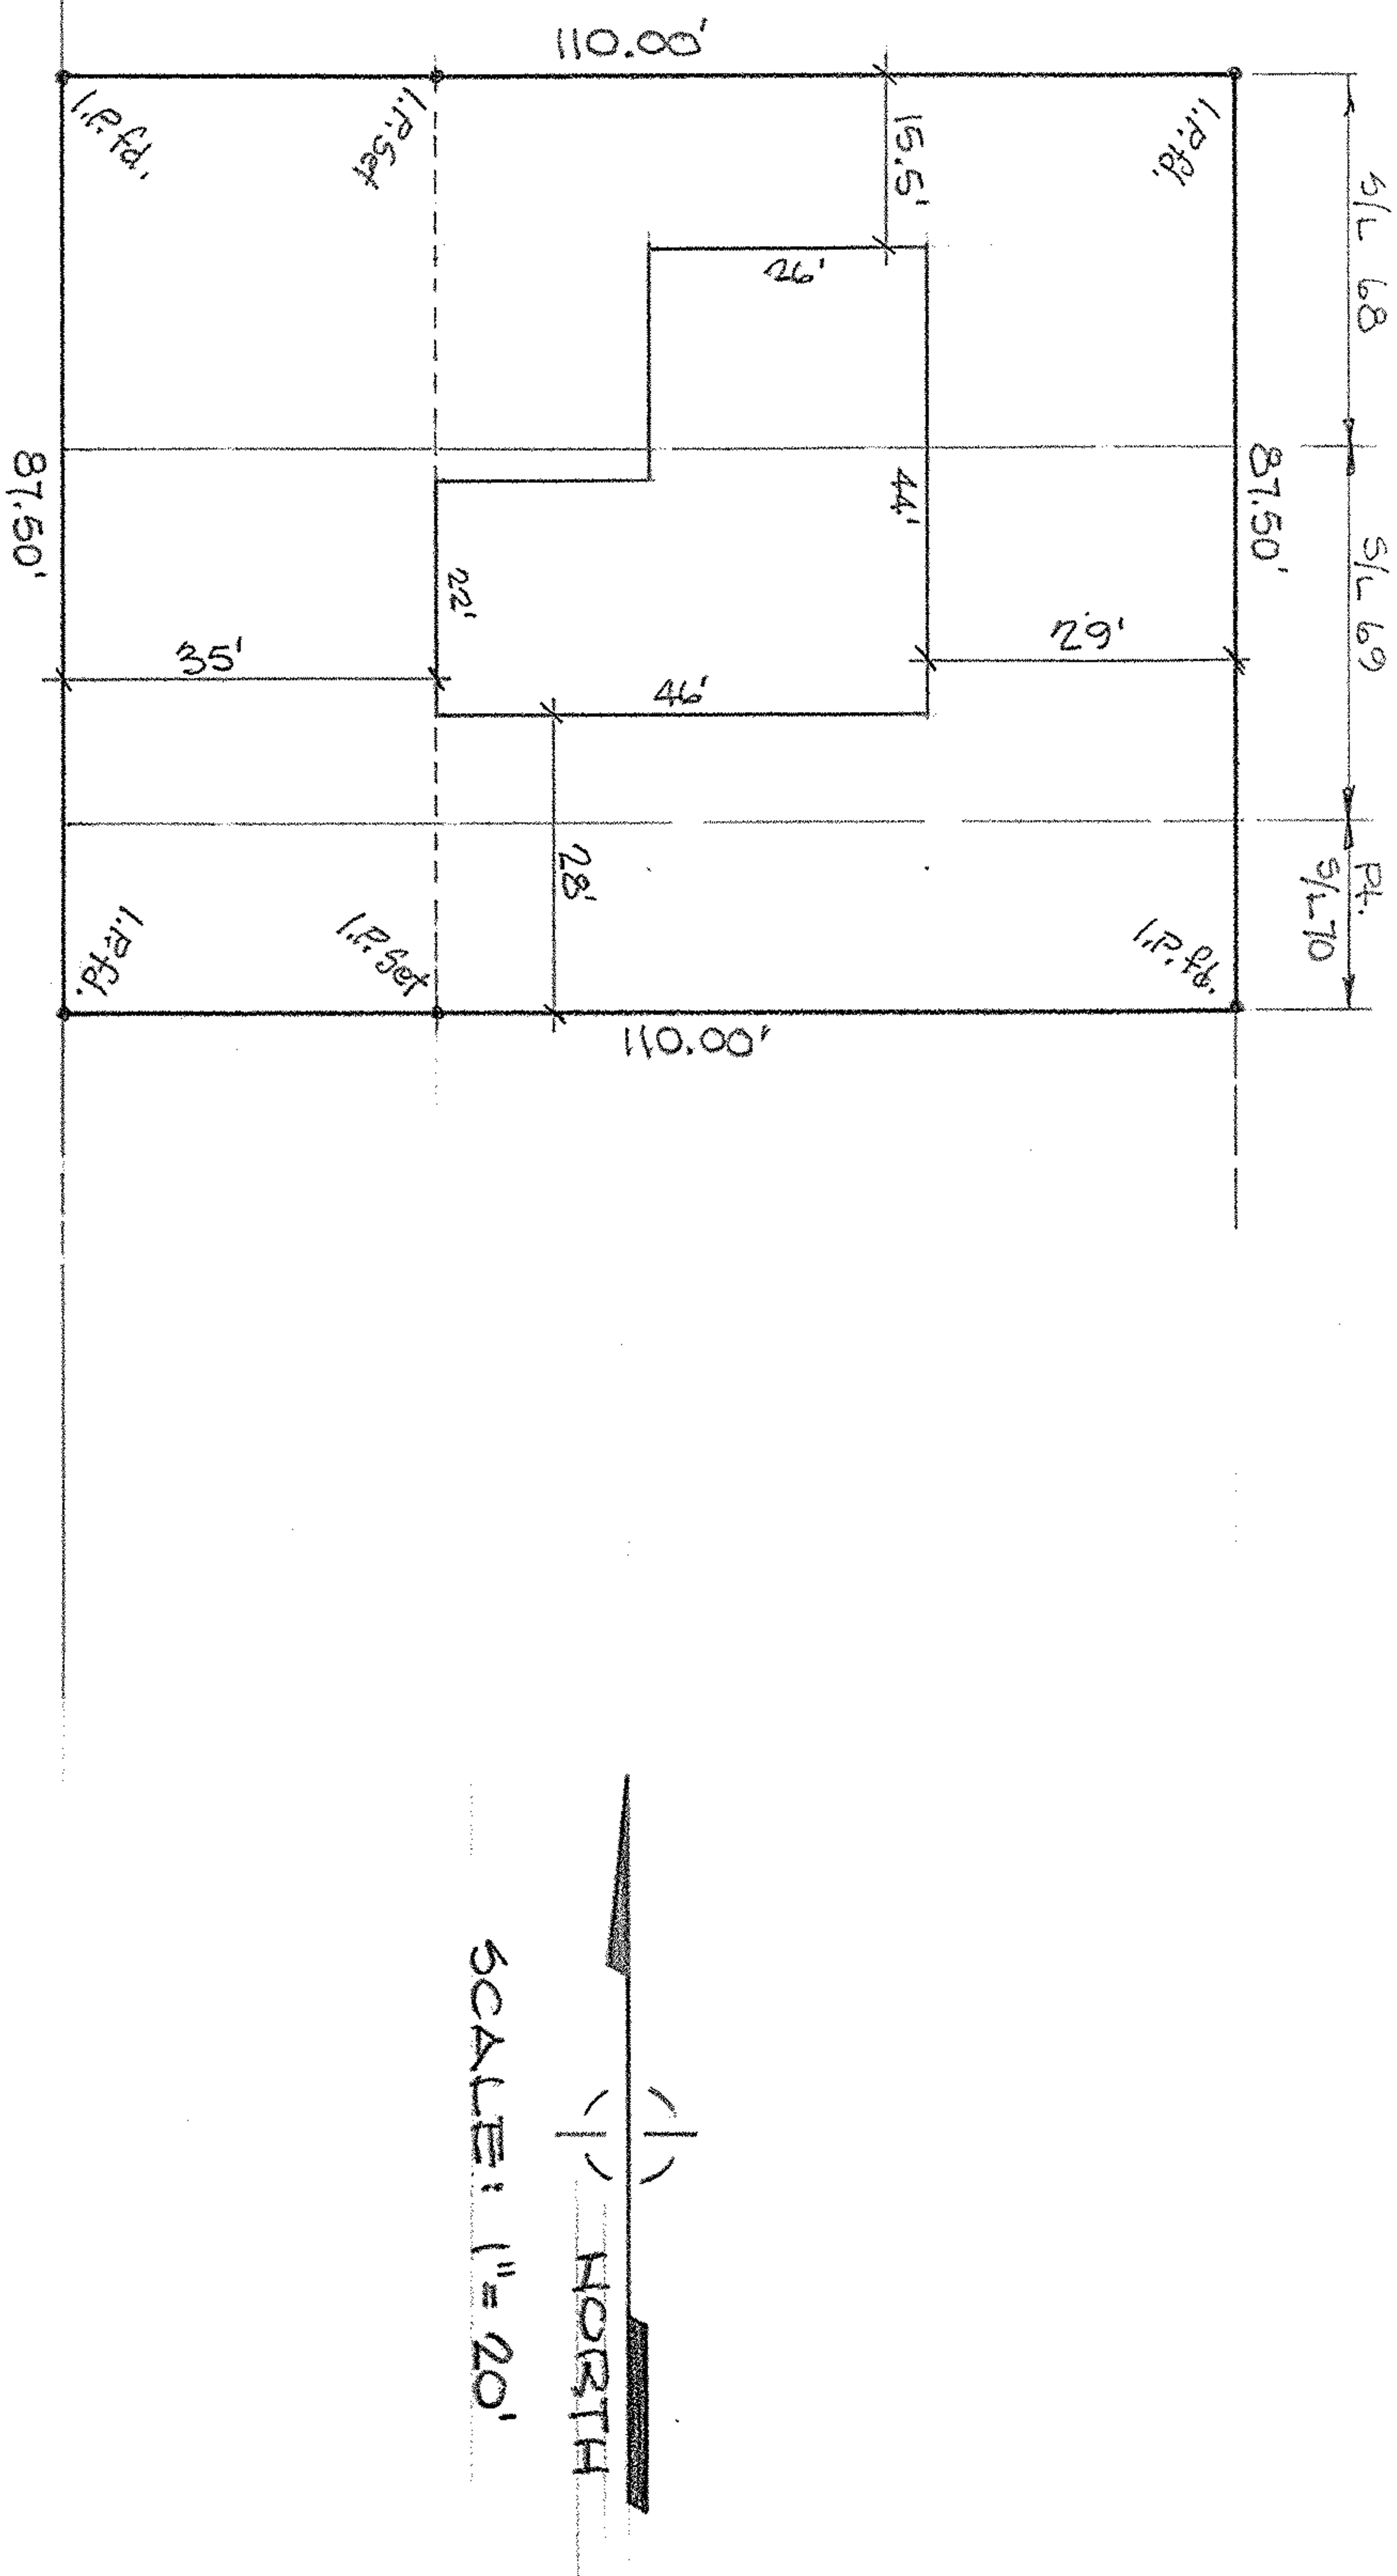


**McGEEHAN ASSOCIATES**  
**PROFESSIONAL ENGINEERS SURVEYORS**