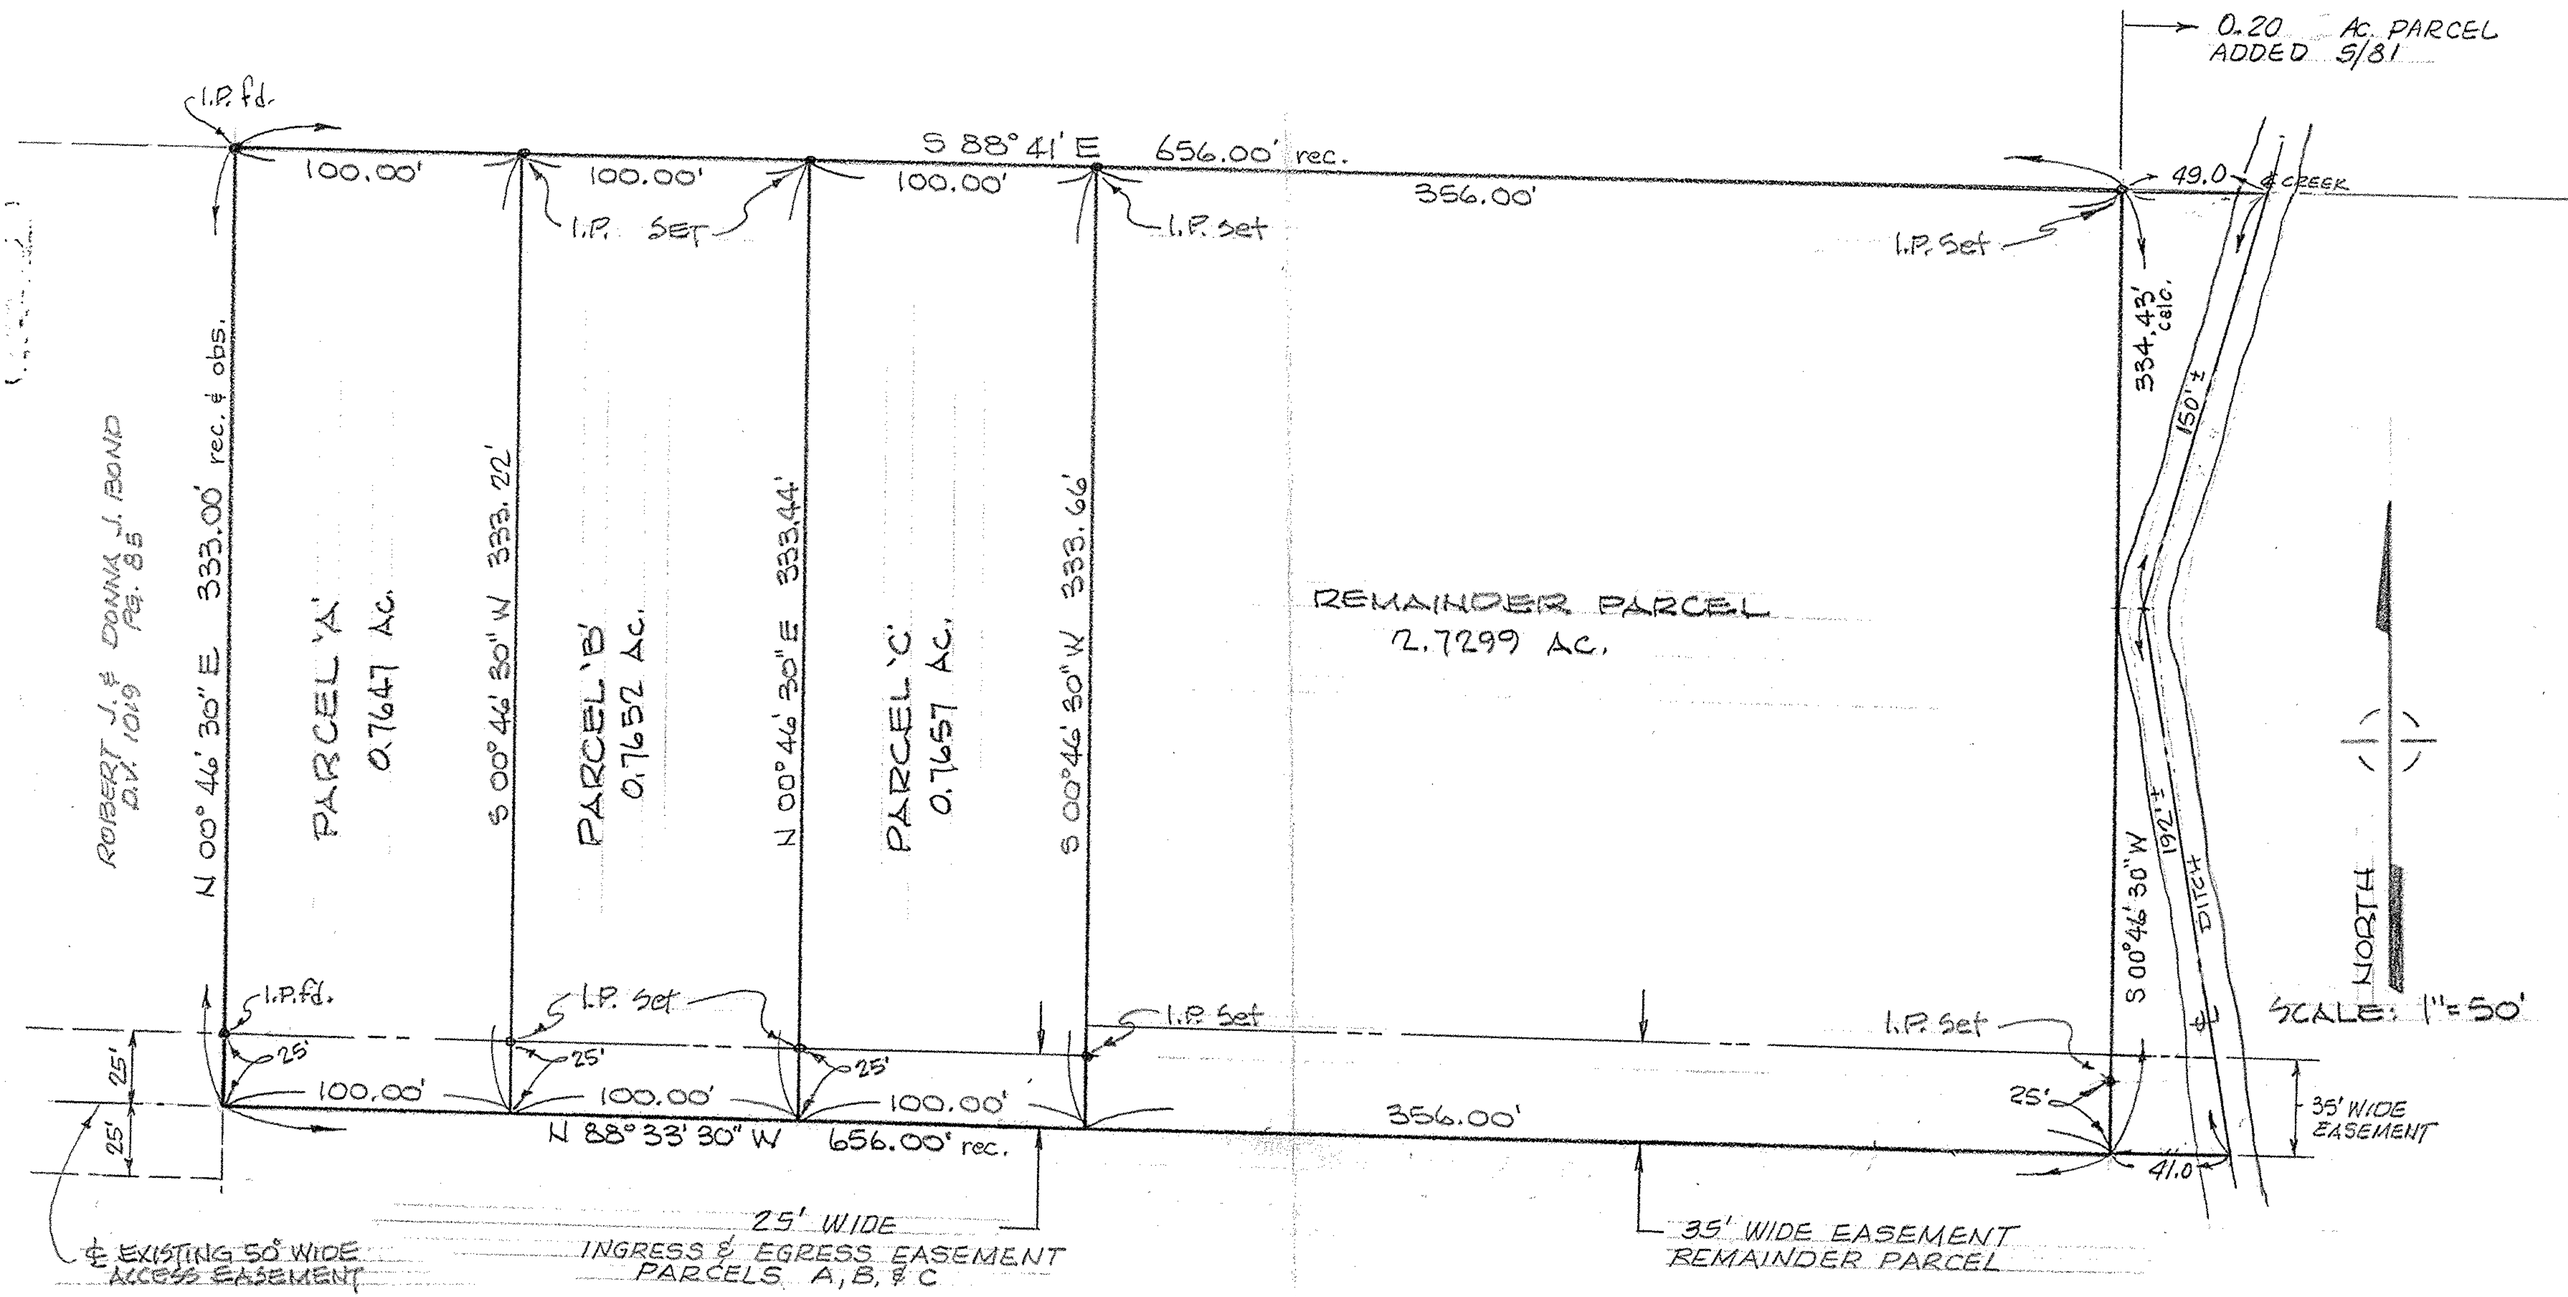

MAP of SURVEY and PROPOSED PARCEL SPLIT

PREPARED FOR FRANK RYBARCYK

PART of ORIGINAL ELYRIA TOWNSHIP LOT 42, WEST of BLACK RIVER
TOWNSHIP of ELYRIA LORAIN COUNTY OHIO

NOTE: Pt. of P.P. # 06-24-042-000-016

McGLINCHY and ASSOCIATES INC.
PROFESSIONAL ENGINEER & SURVEYORS
ELYRIA OHIO

DECEMBER, 1979 #796125
REVISED 1/17/80 REV 5/81 REV 5-18-81