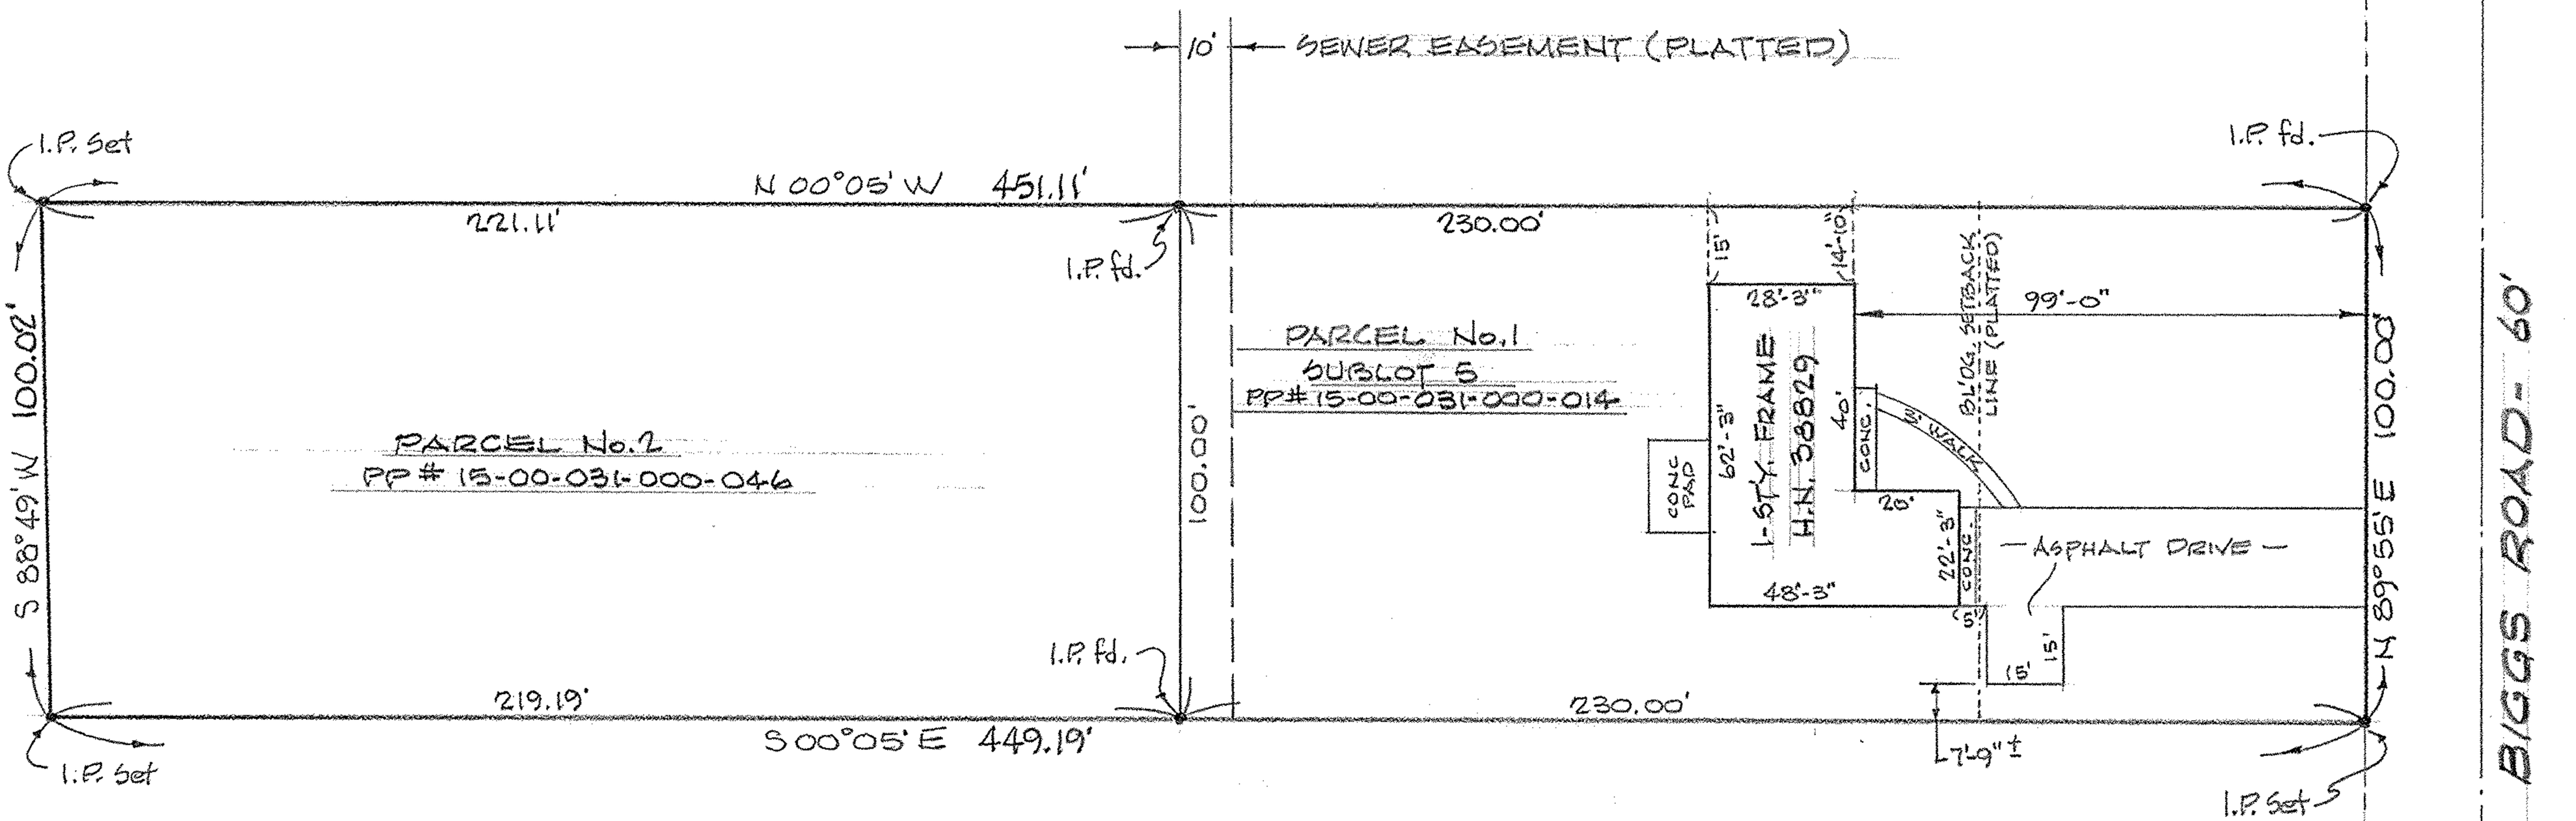

MAP of SURVEY

PREPARED FOR BERKS TITLE INSURANCE Co.

SUBLOT No. 5 in VISTA DEL RIO SUBDIVISION No.1,
PLAT VOL. 26, PG. 28 and PART of ORIGINAL
LAGRANGE TWP. LOT No. 31
TOWNSHIP of LAGRANGE, LORAIN COUNTY, OHIO

McGLINCHY and ASSOCIATES INC.
PROFESSIONAL ENGINEER and SURVEYORS
ELYRIA OHIO
DECEMBER, 1979 #796110