


1" = 100'

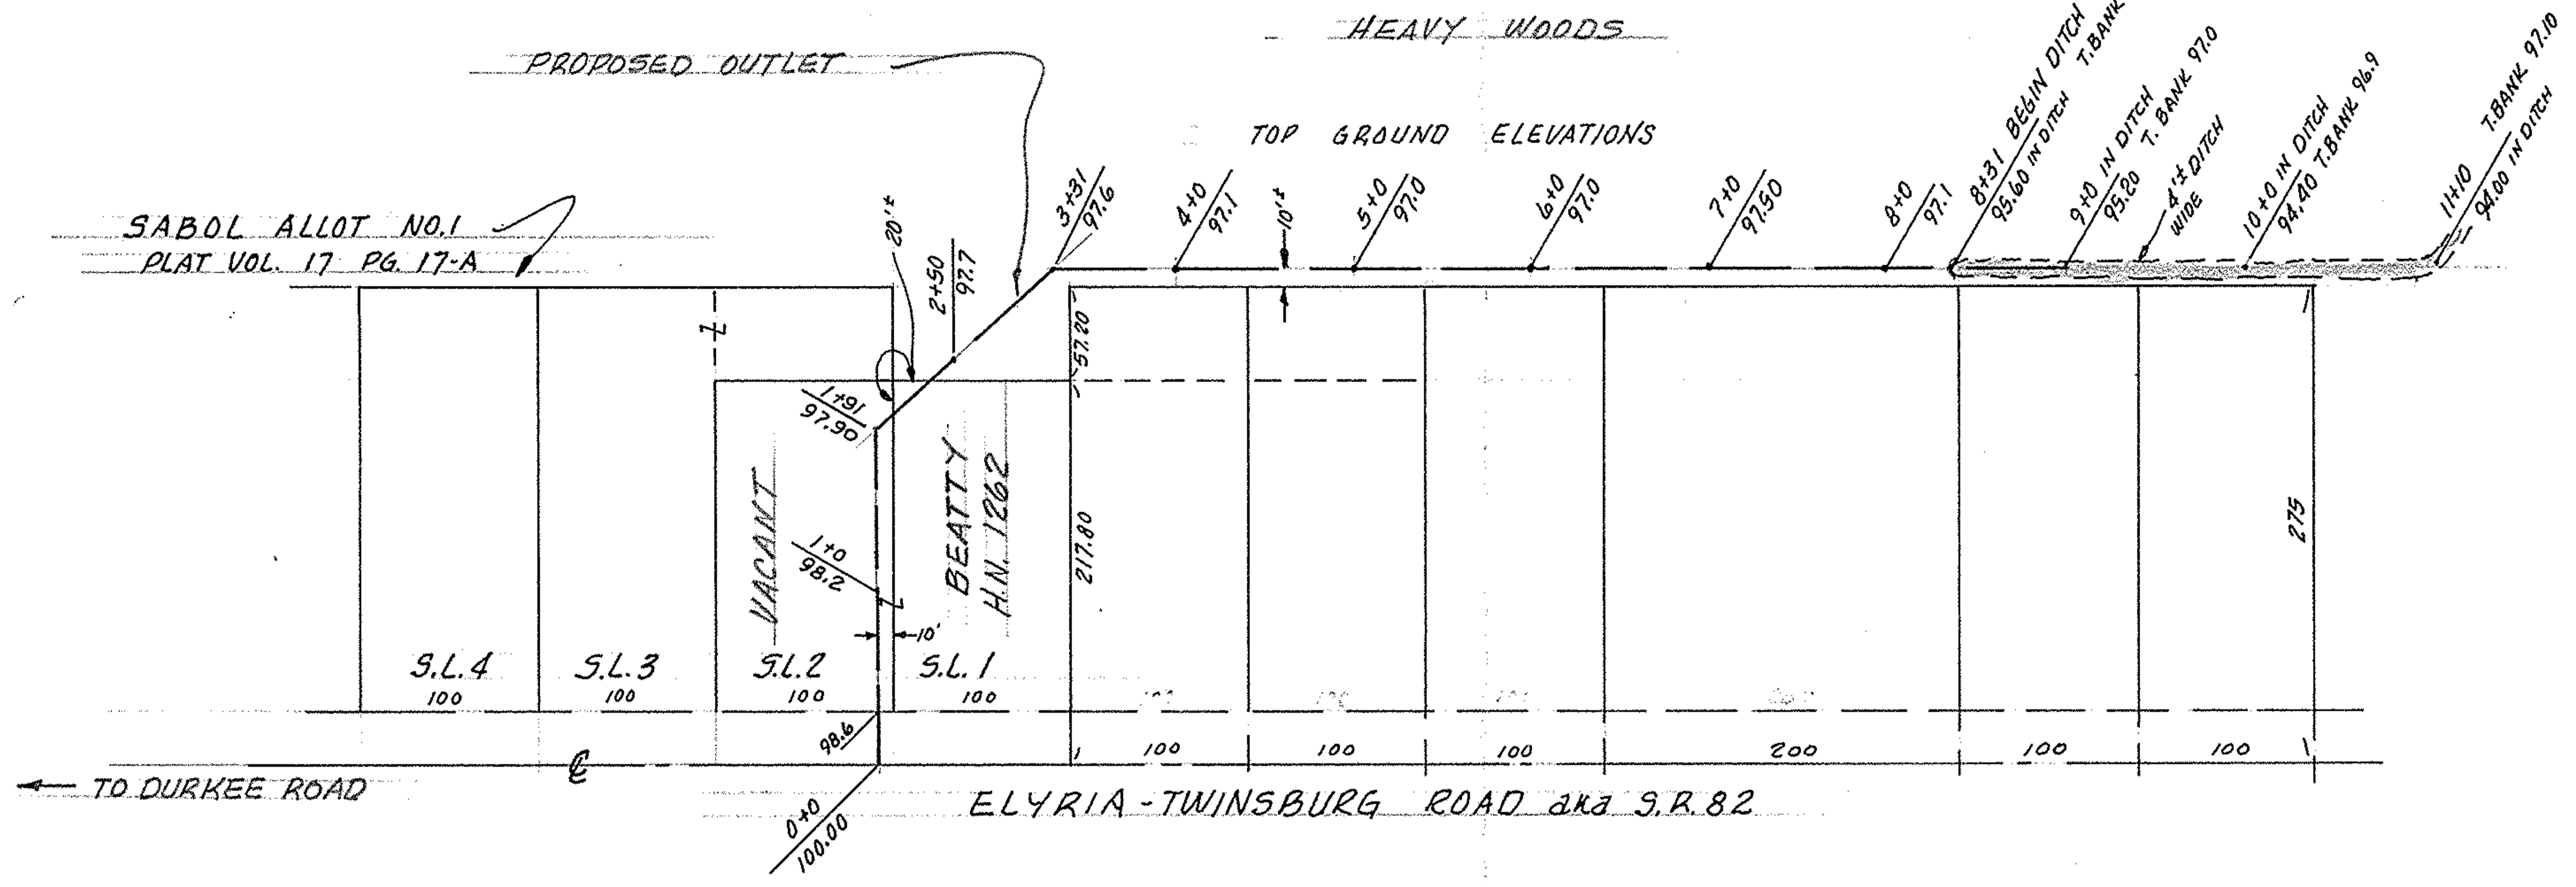

SABOL ALLOT NO.1
PLAT VOL. 17 PG. 17-A

HEAVY WOODS

TOP GROUND ELEVATIONS

S.L. 4
100

S.L. 3
100

S.L. 2
100

S.L. 1
100

BEATTY
H.N. 1262

ELYRIA-TWINSBURG ROAD aka S.R. 82

← TO DURKEE ROAD

EATON TWP O.L. 75
TAX MAP PAGE 11-00-075-B

PLAN of EXISTING GRADE ELEVATIONS FOR
MR. LESLIE BEATTY
1262 W. ROYALTON ROAD
GRAFTON, OHIO 44050

McGLINCHY & ASSOCIATES INC
REGISTERED ENGINEERS & SURVEYORS
MAR. 14, 1980 #806236