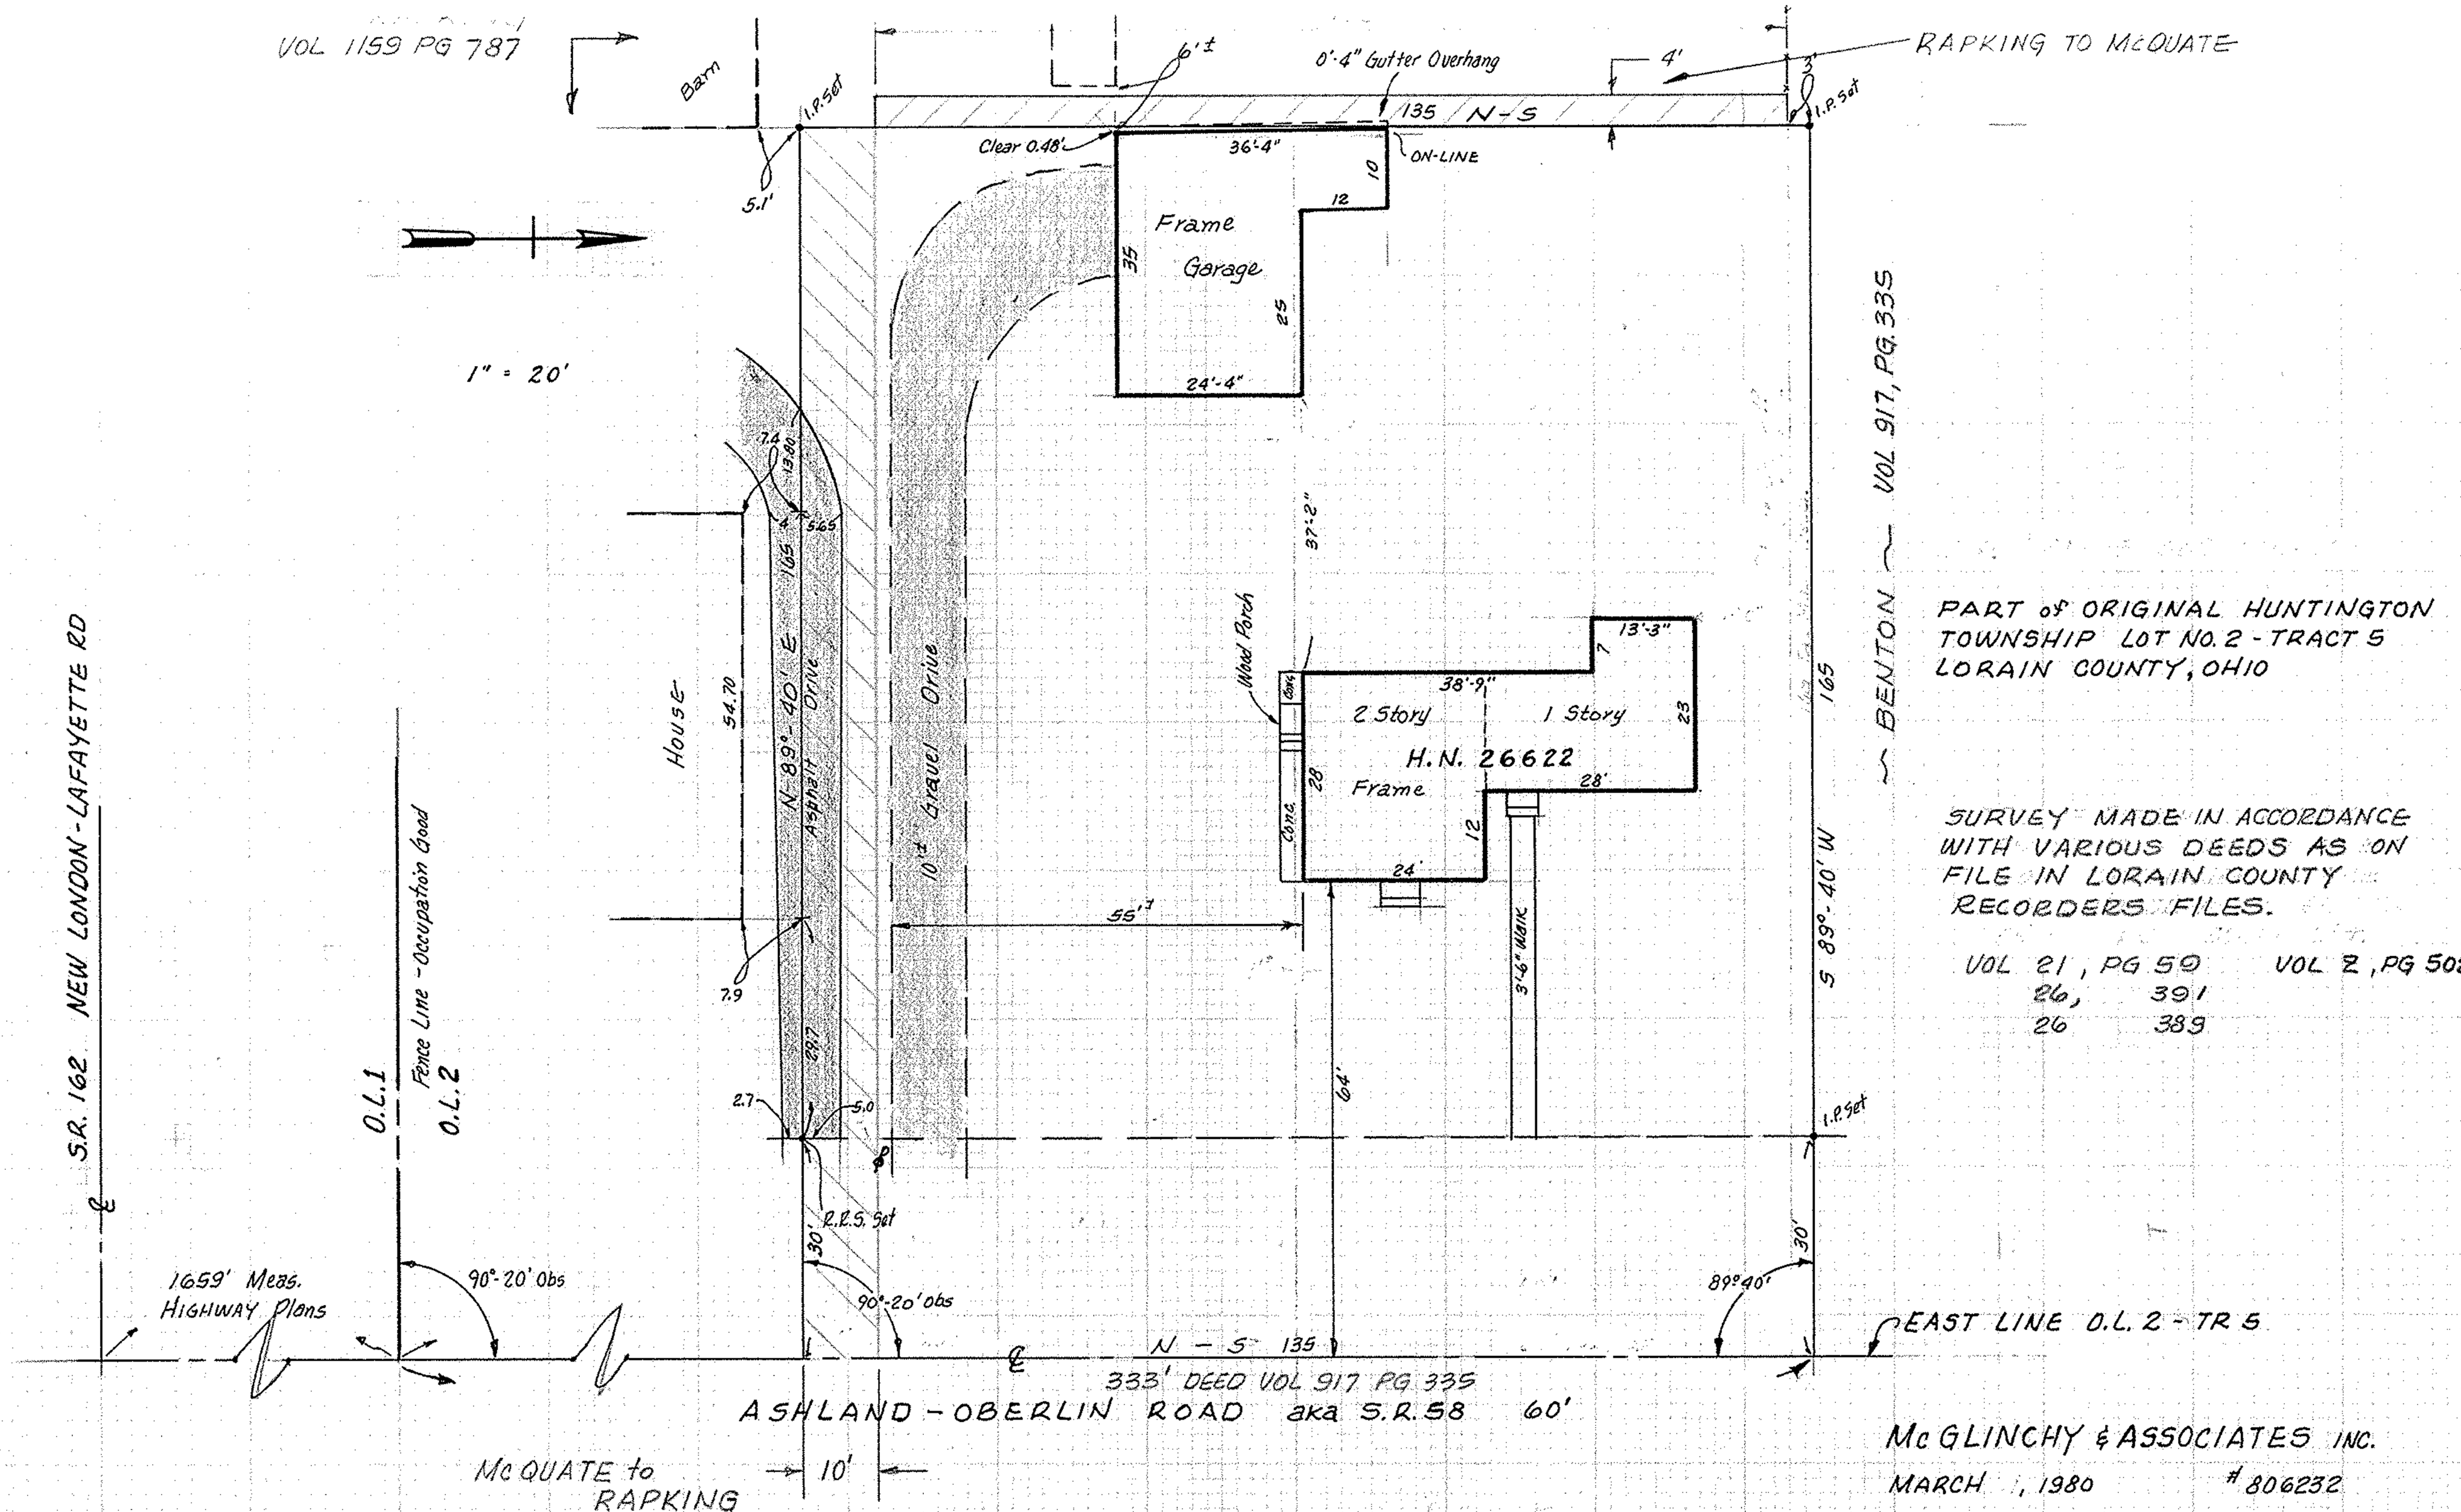

PART of ORIGINAL HUNTINGTON TOWNSHIP LOT NO. 2 - TRACT 5 LORAIN COUNTY, OHIO

SURVEY MADE IN ACCORDANCE WITH VARIOUS DEEDS AS ON FILE IN LORAIN COUNTY RECORDERS FILES.

VOL 21, PG 59 VOL Z, PG 502
26, 391
26 389

McGLINCHY & ASSOCIATES INC.
MARCH , 1980 #806232

CHICAGO TITLE #E-179,769