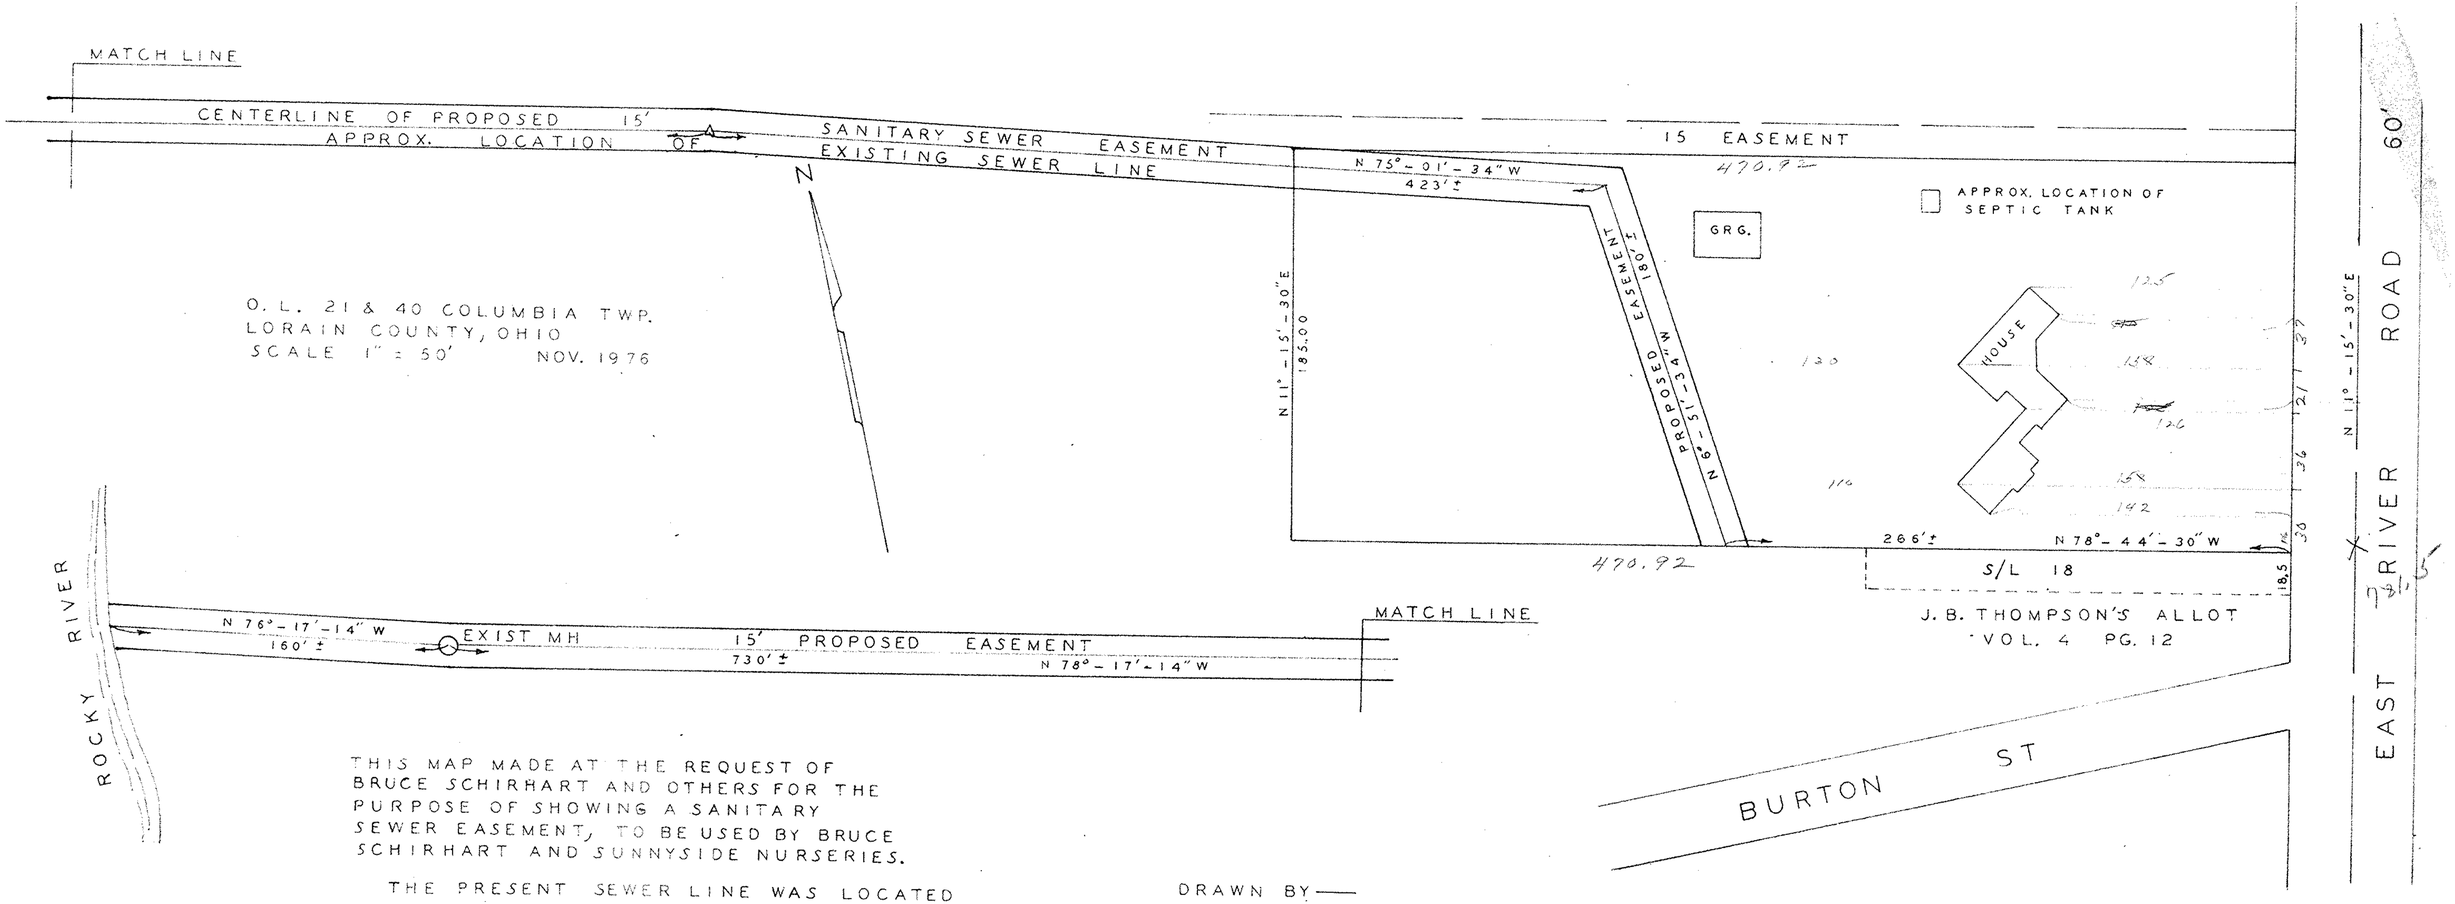

THIS MAP MADE AT THE REQUEST OF BRUCE SCHIRHART AND OTHERS FOR THE PURPOSE OF SHOWING A SANITARY SEWER EASEMENT, TO BE USED BY BRUCE SCHIRHART AND SUNNYSIDE NURSERIES.

THE PRESENT SEWER LINE WAS LOCATED FROM INFORMATION GIVEN US BY PRESENT PROPERTY OWNERS.

DRAWN BY—
NEFF AND ASSOCIATES INC.
CONSULTING ENGINEERS & SURVEYORS
532 W. BROAD ST. ELYRIA, OHIO

JOB NO. 76026