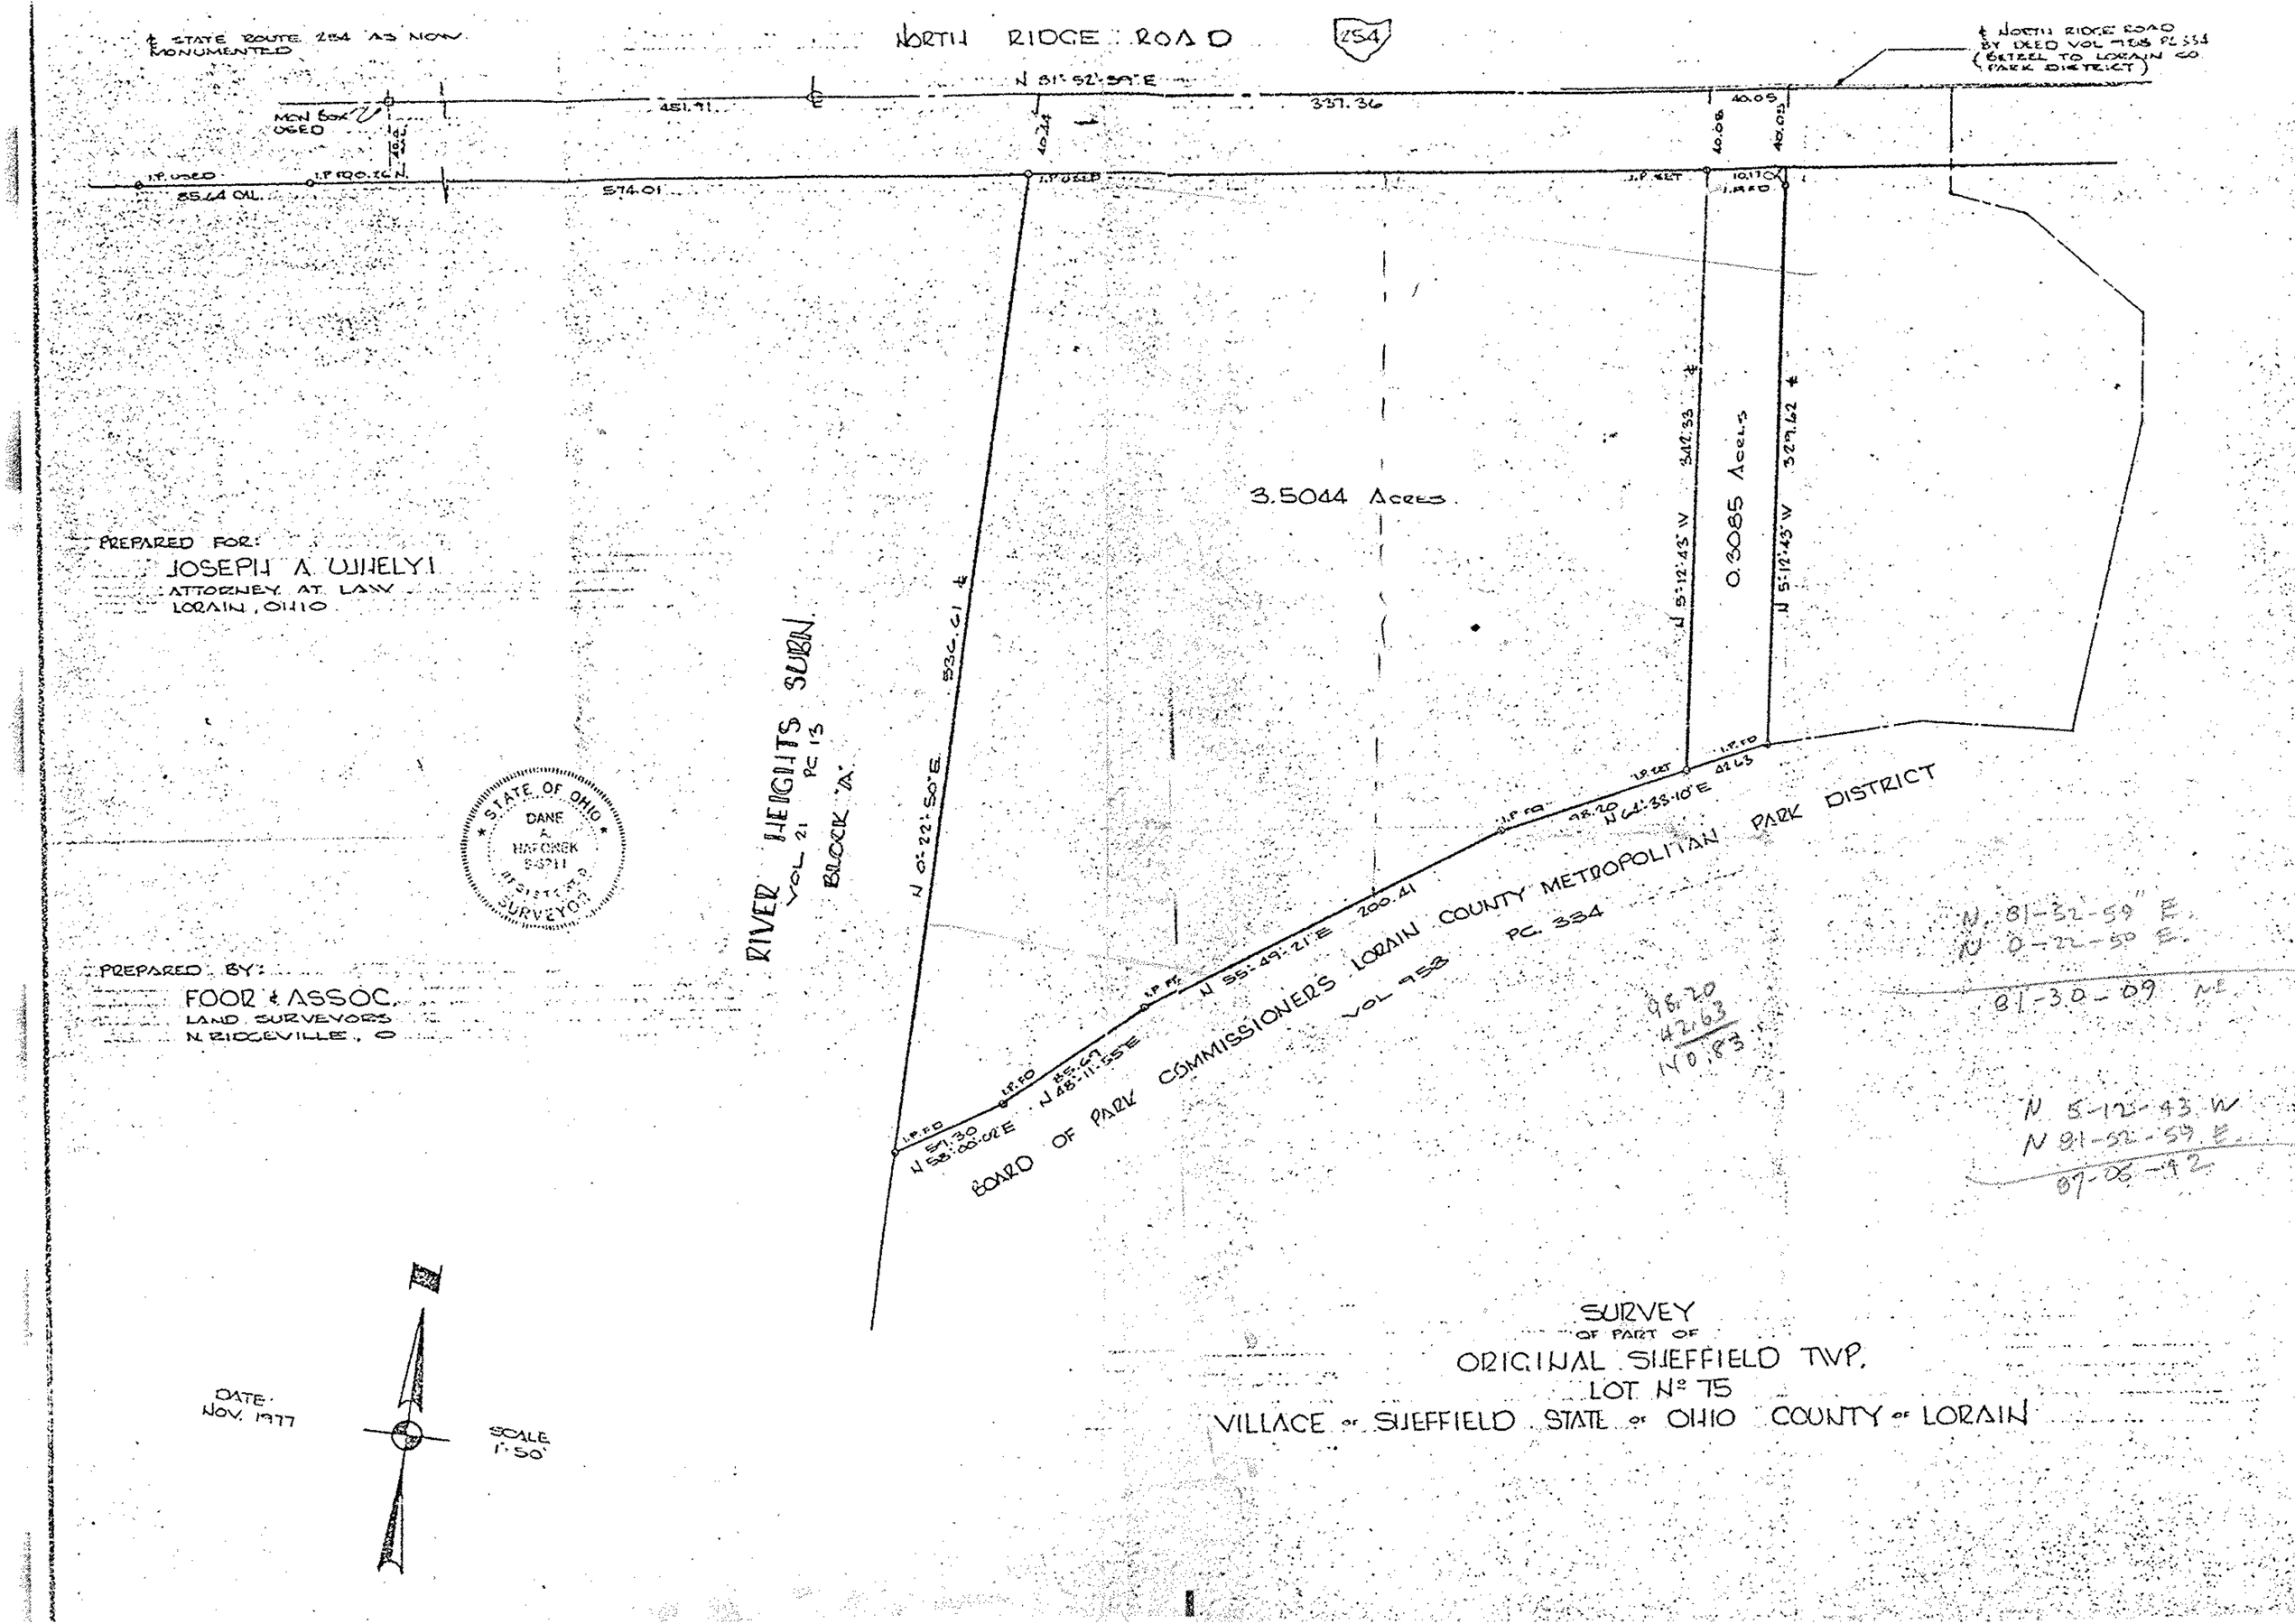

SURVEY
OF PART OF
ORIGINAL SHEFFIELD TWP.
LOT Nº 75
VILLAGE OF SHEFFIELD STATE OF OHIO COUNTY OF LORAIN