
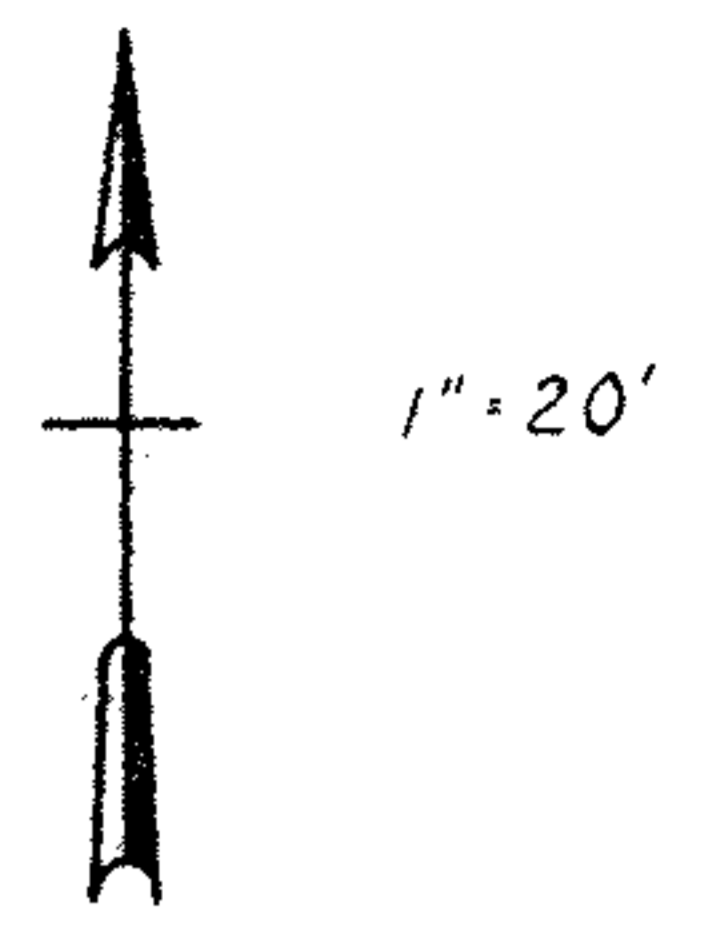


BUCKEYE DRIVE 70'

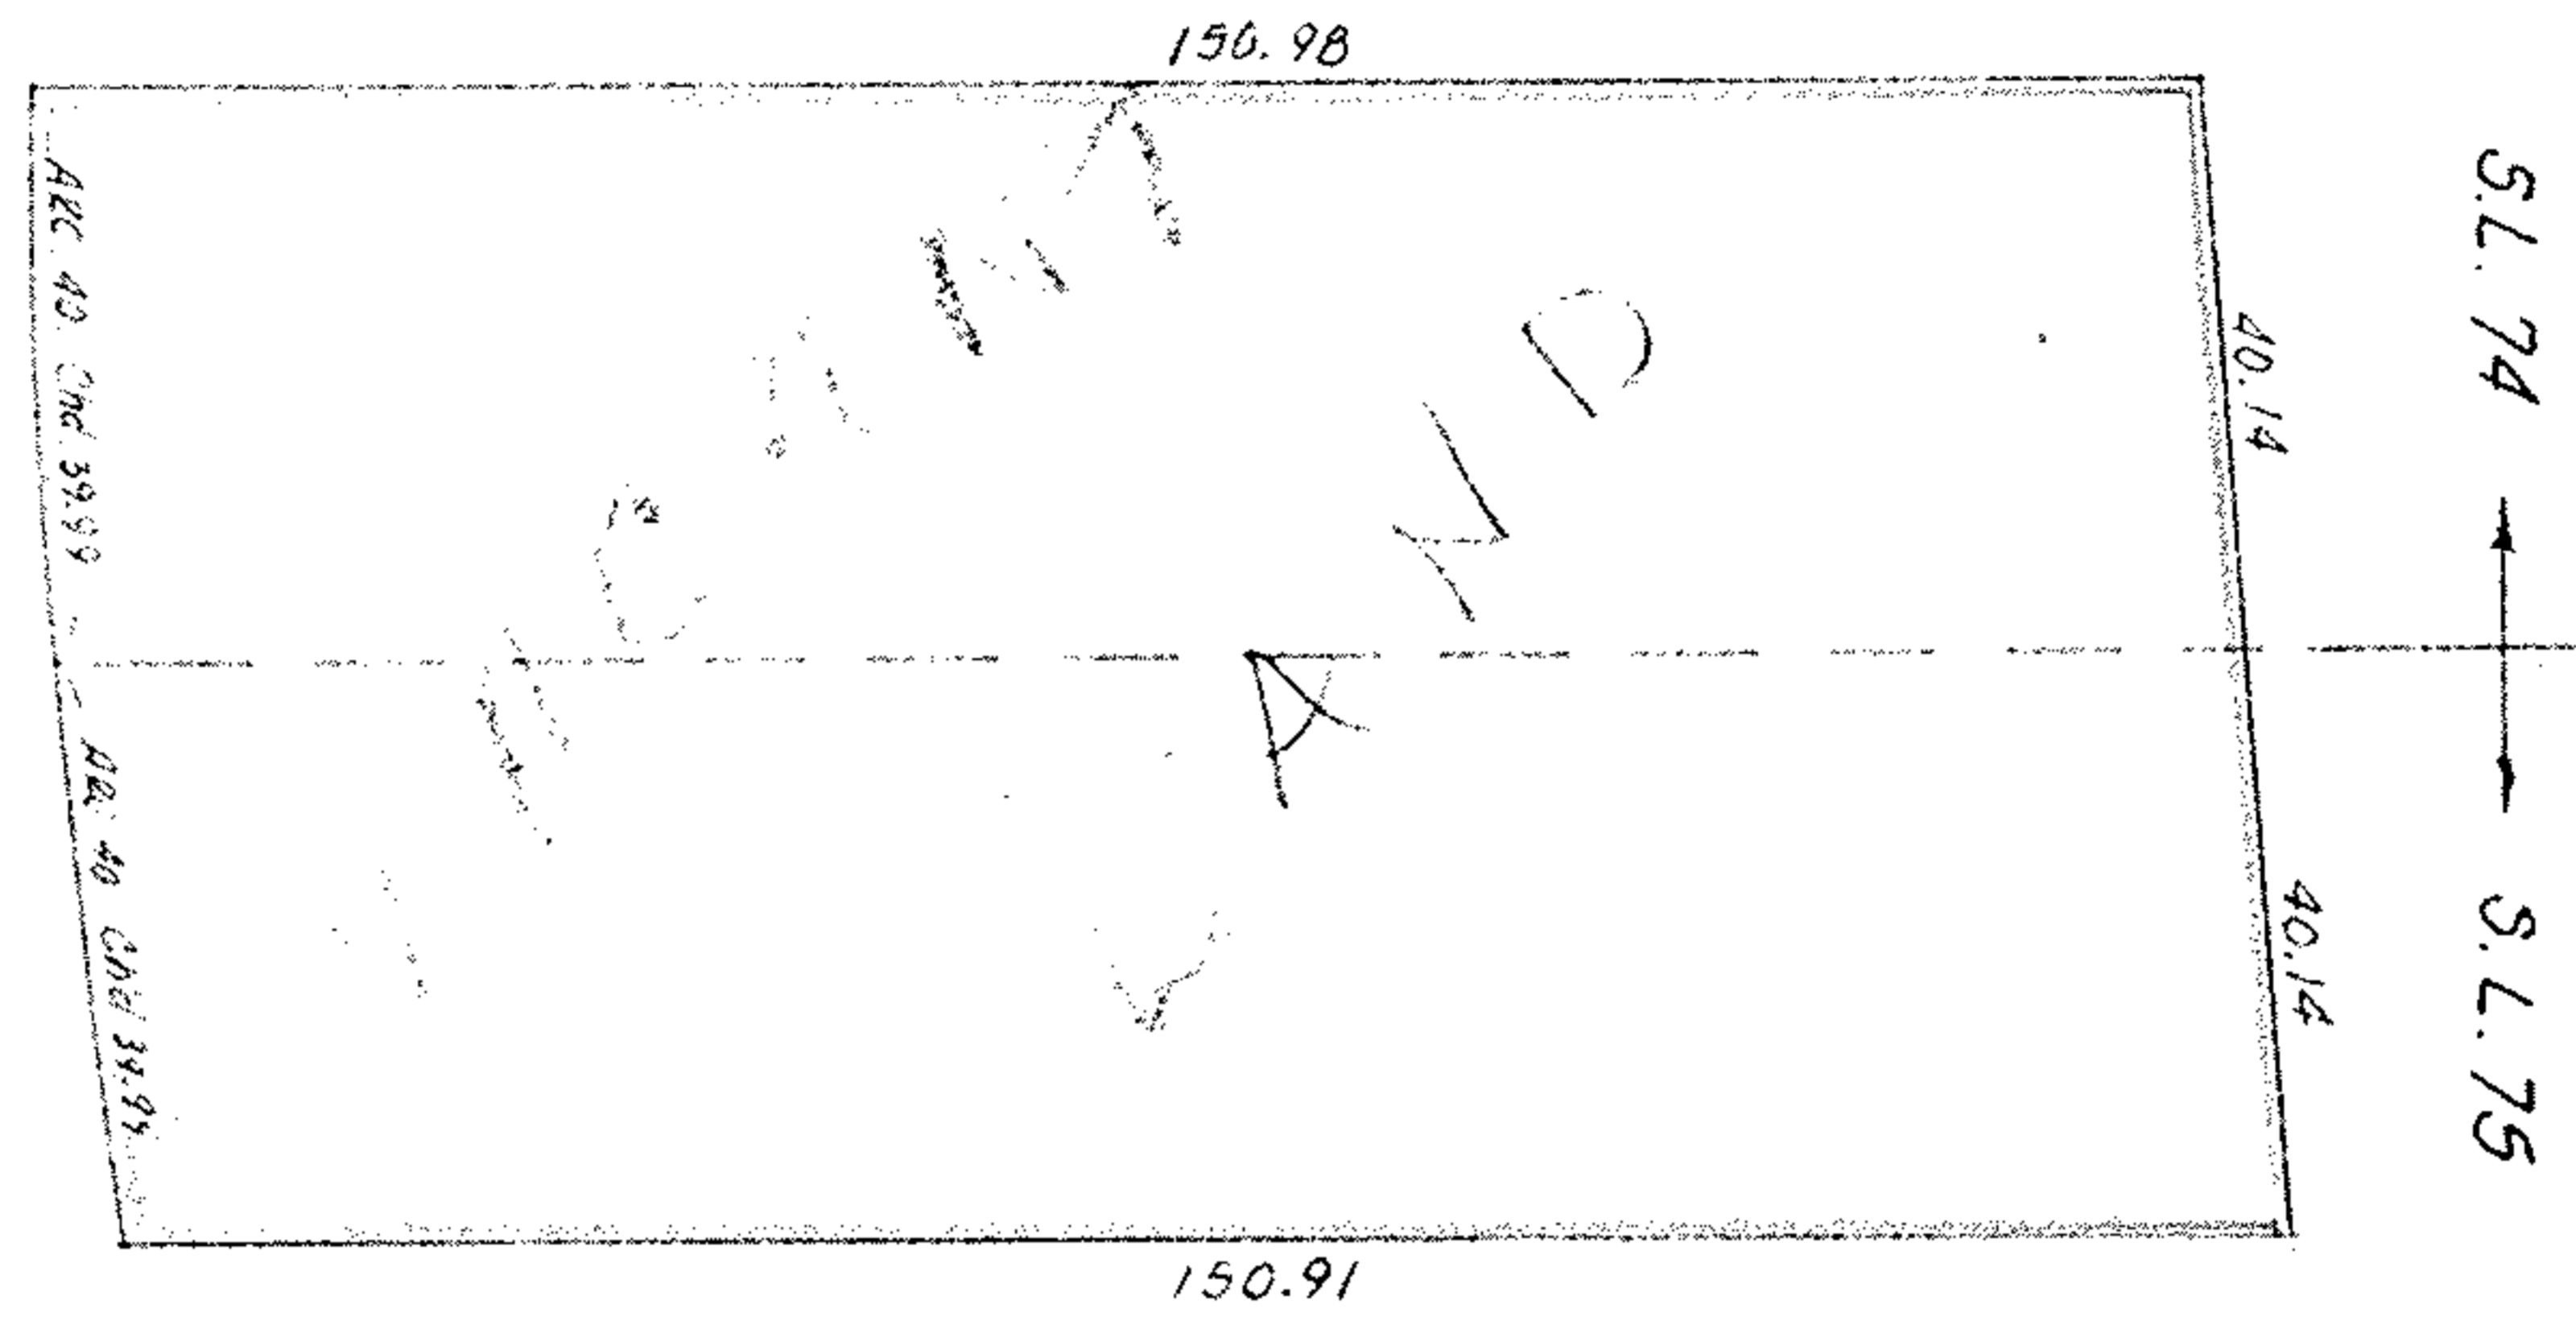

SUBLOTS # 74 & 75 of BLOCK 'C' of BORDER CITIES CO'S  
SHORE SUBDIVISION & BUCKEYE COUNTRY CLUB  
PLAT VOL. 10 PAGES 30 & 31  
PART of ORIG. SHEFFIELD TWP. LOT 35  
NOW in CITY of SHEFFIELD LAKE, OHIO

McGLINCHY & ASSOCIATES  
JUNE 1977 #772006  
MidT E-8999