


BUCKEYE DRIVE 70'

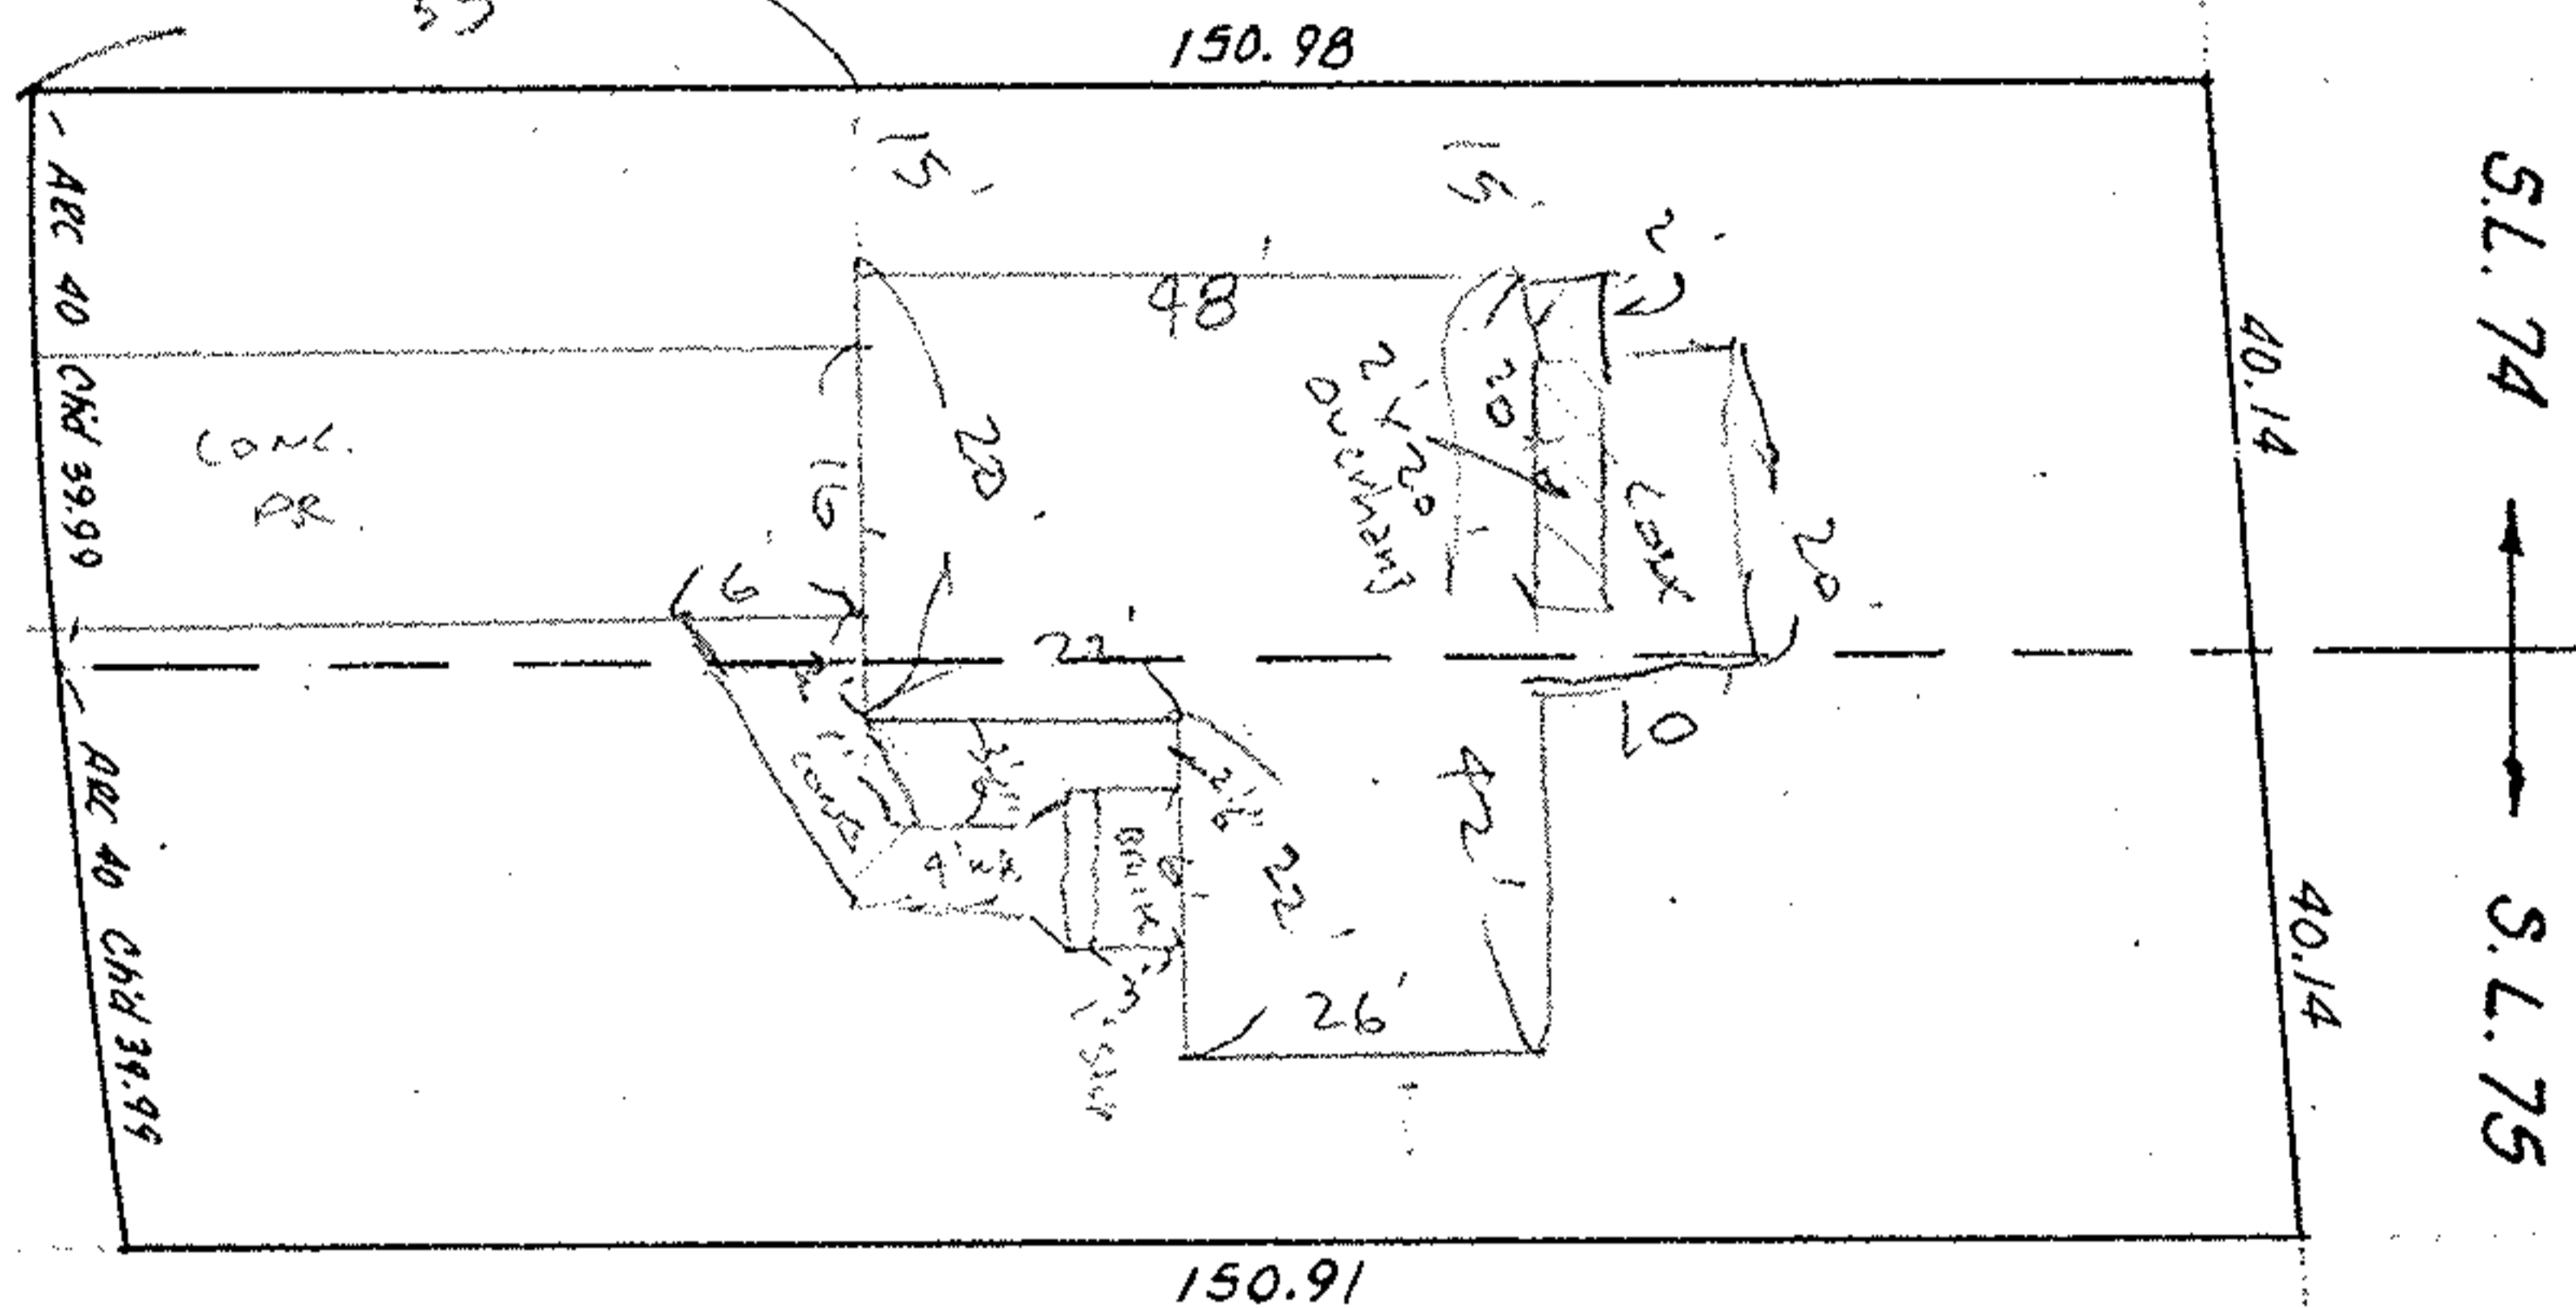

1" = 20'

SUBLOTS # 74 & 75 of BLOCK 'C' of BORDER CITIES CO'S
SHORE SUBDIVISION & BUCKEYE COUNTRY CLUB
PLAT VOL. 10 PAGES 30 & 31
PART of ORIG. SHEFFIELD TWP. LOT 35
NOW in CITY of SHEFFIELD LAKE, OHIO

McGLINCHY & ASSOCIATES
JUNE 1977 #772000
Midt E:8999