


FRANKFORD ST. 50'

BOND AVE. 60'

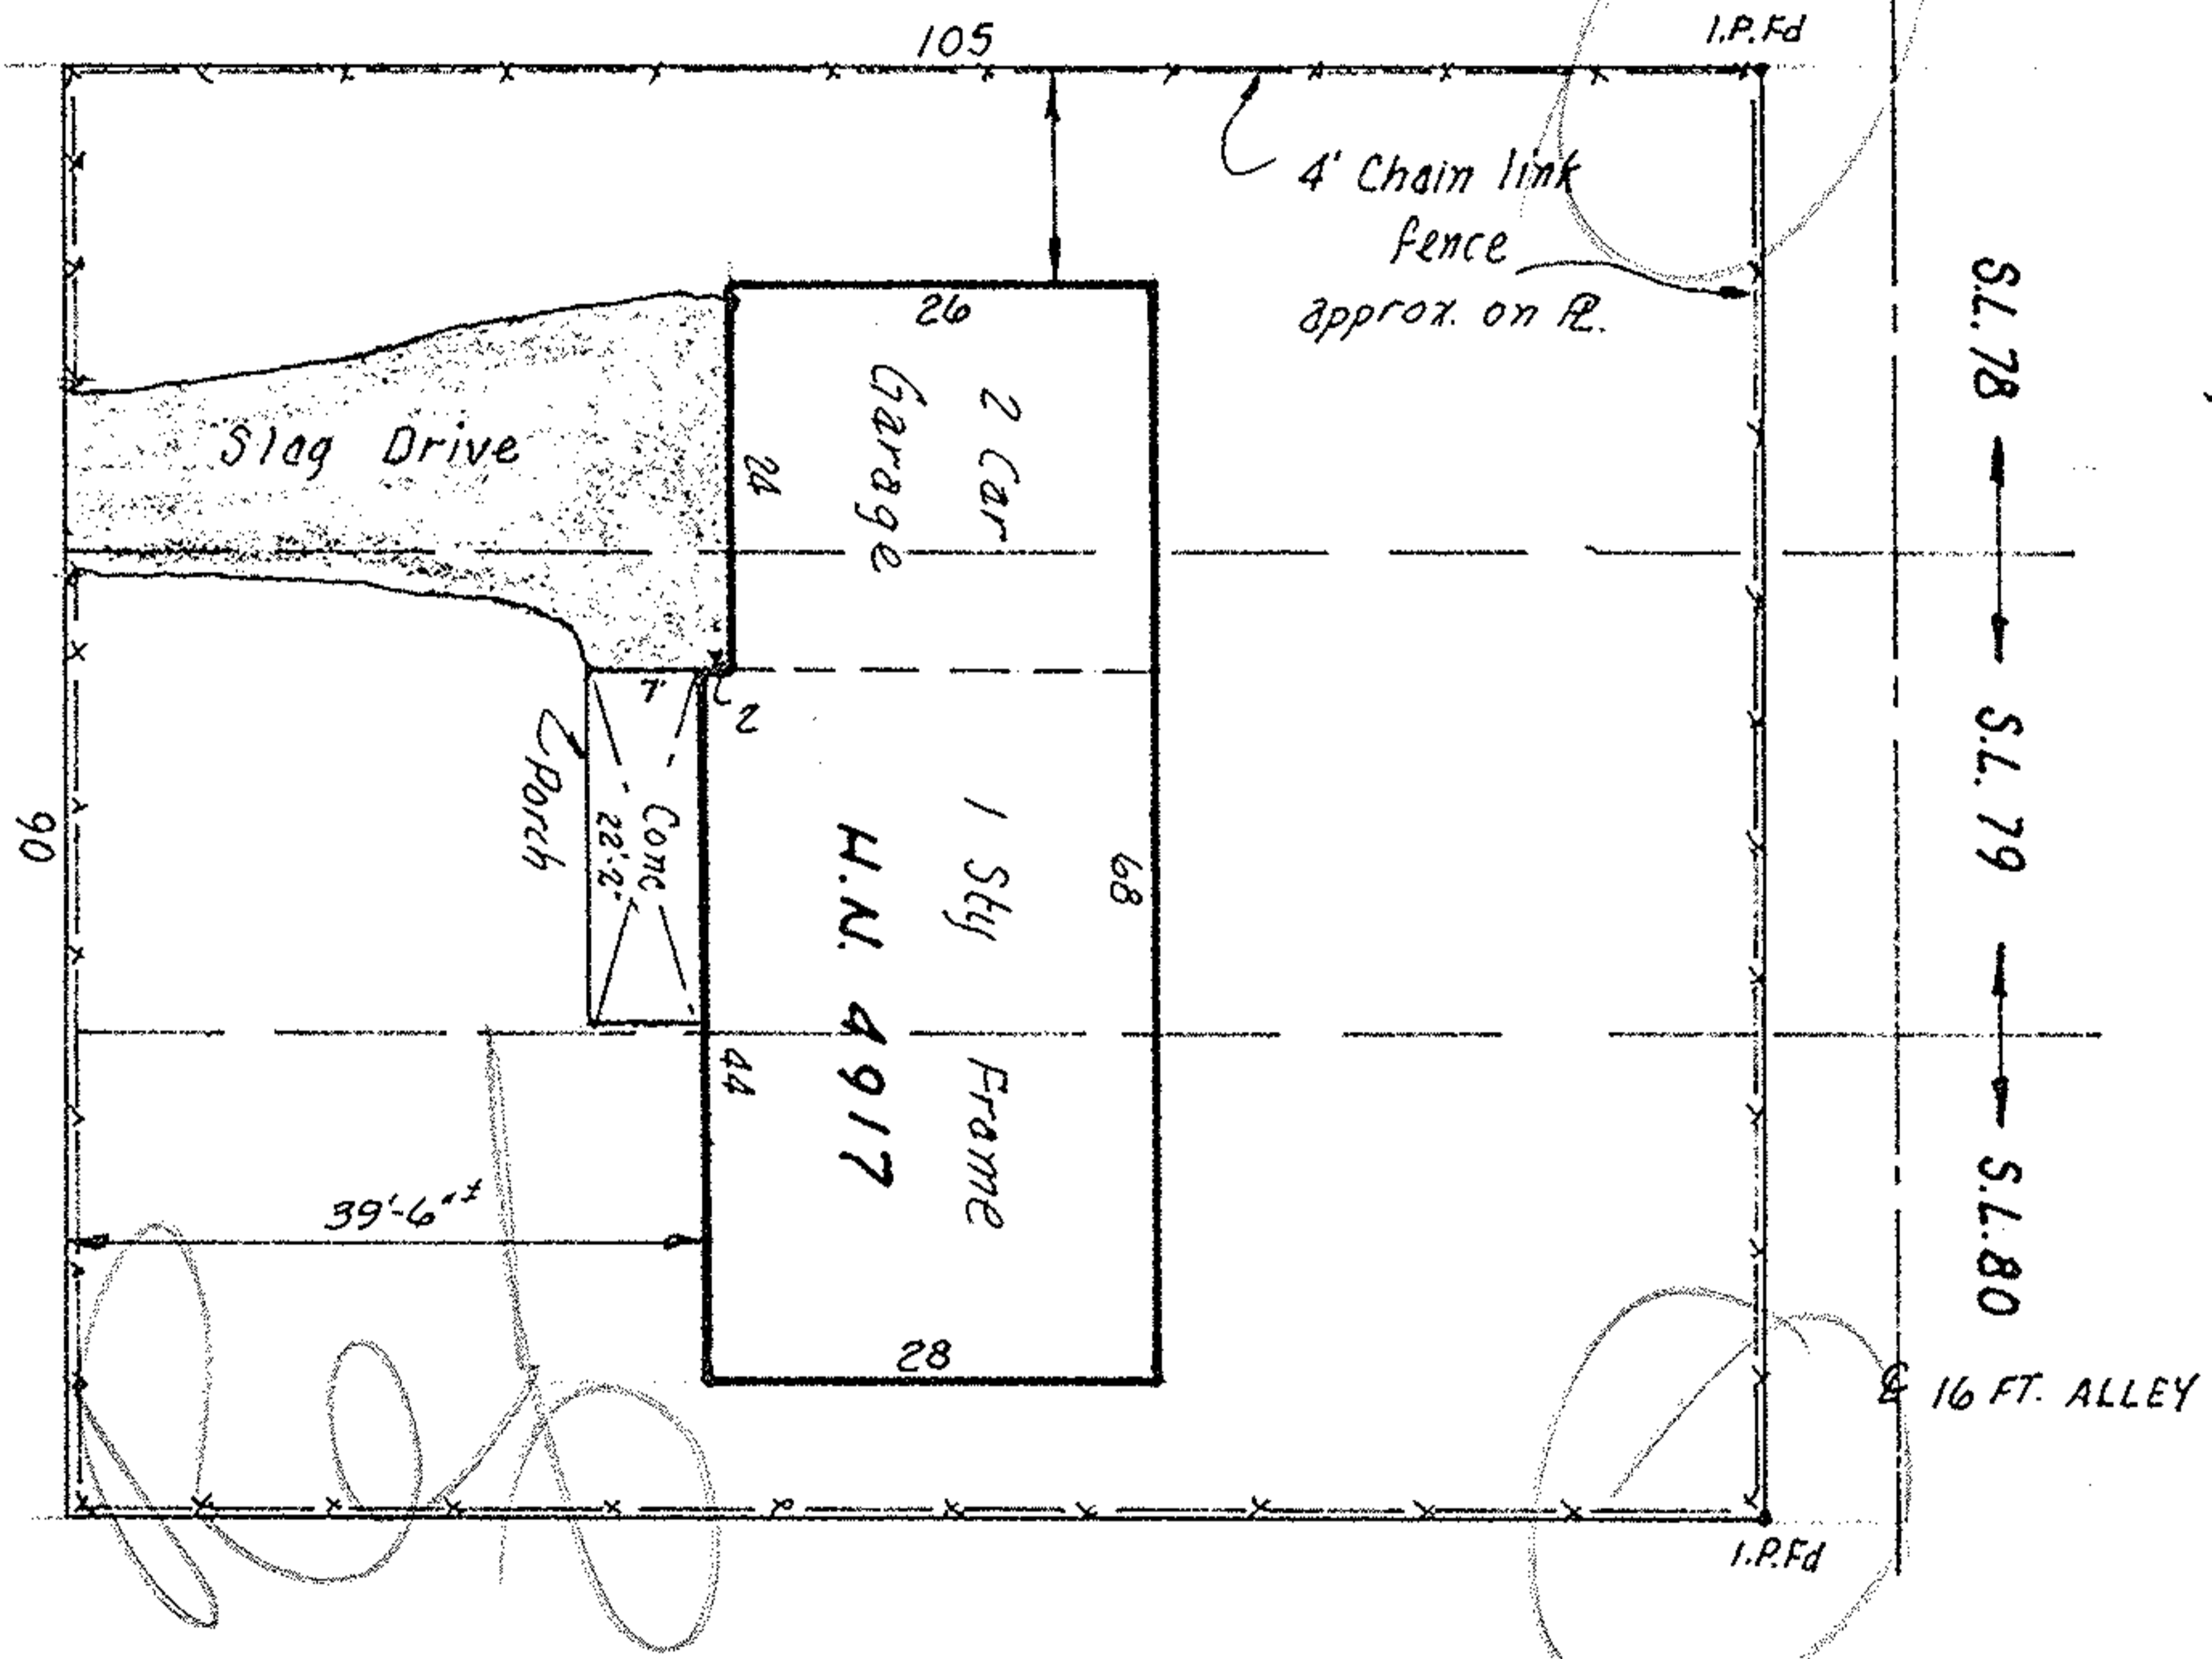

SUBLOTS # 78, 79 & 80 of LIBERTY SUBD'N
 PLAT VOL. 9, PG 26 - PART of ORIG.
 SHEFFIELD TWP. LOTS 75 & 76.

McGLINCHY & ASSOCIATES
 JULY 2, 1975 # 75382-D