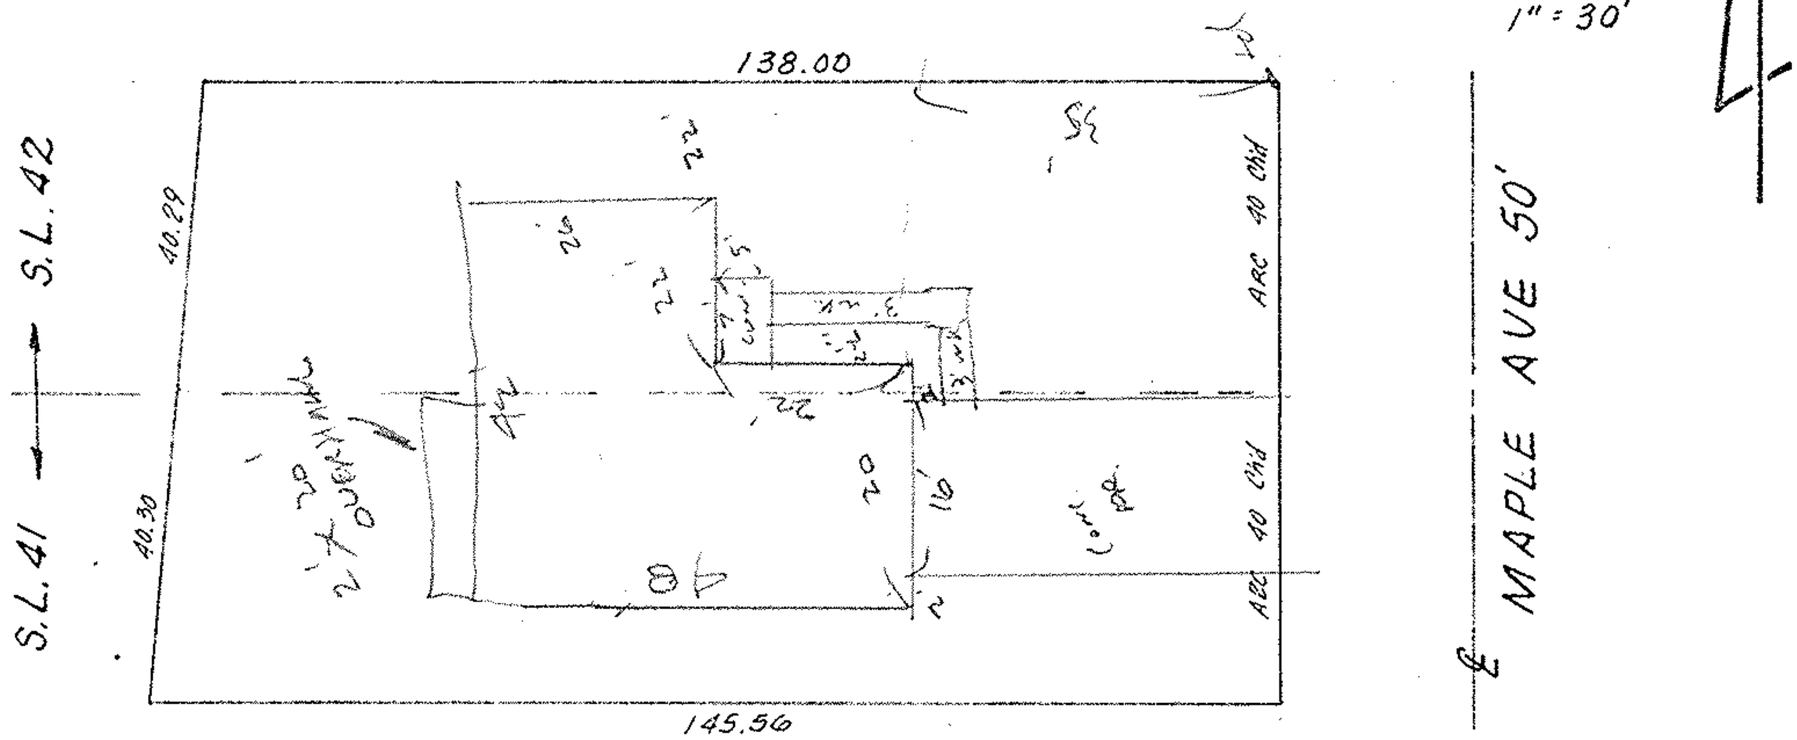

drawn by

SUBLOTS #41 & 42 of BLOCK 'C' of BORDER CITIES CO'S
SHORE SUBDIVISION & BUCKEYE COUNTRY CLUB
PLAT VOL. 10 PAGES 30-32
PART of ORIG. SHEFFIELD TWP. LOT 35
NOW in CITY of SHEFFIELD LAKE, OHIO

McGLINCHY & ASSOCIATES
JUNE 14, 1977 #772007