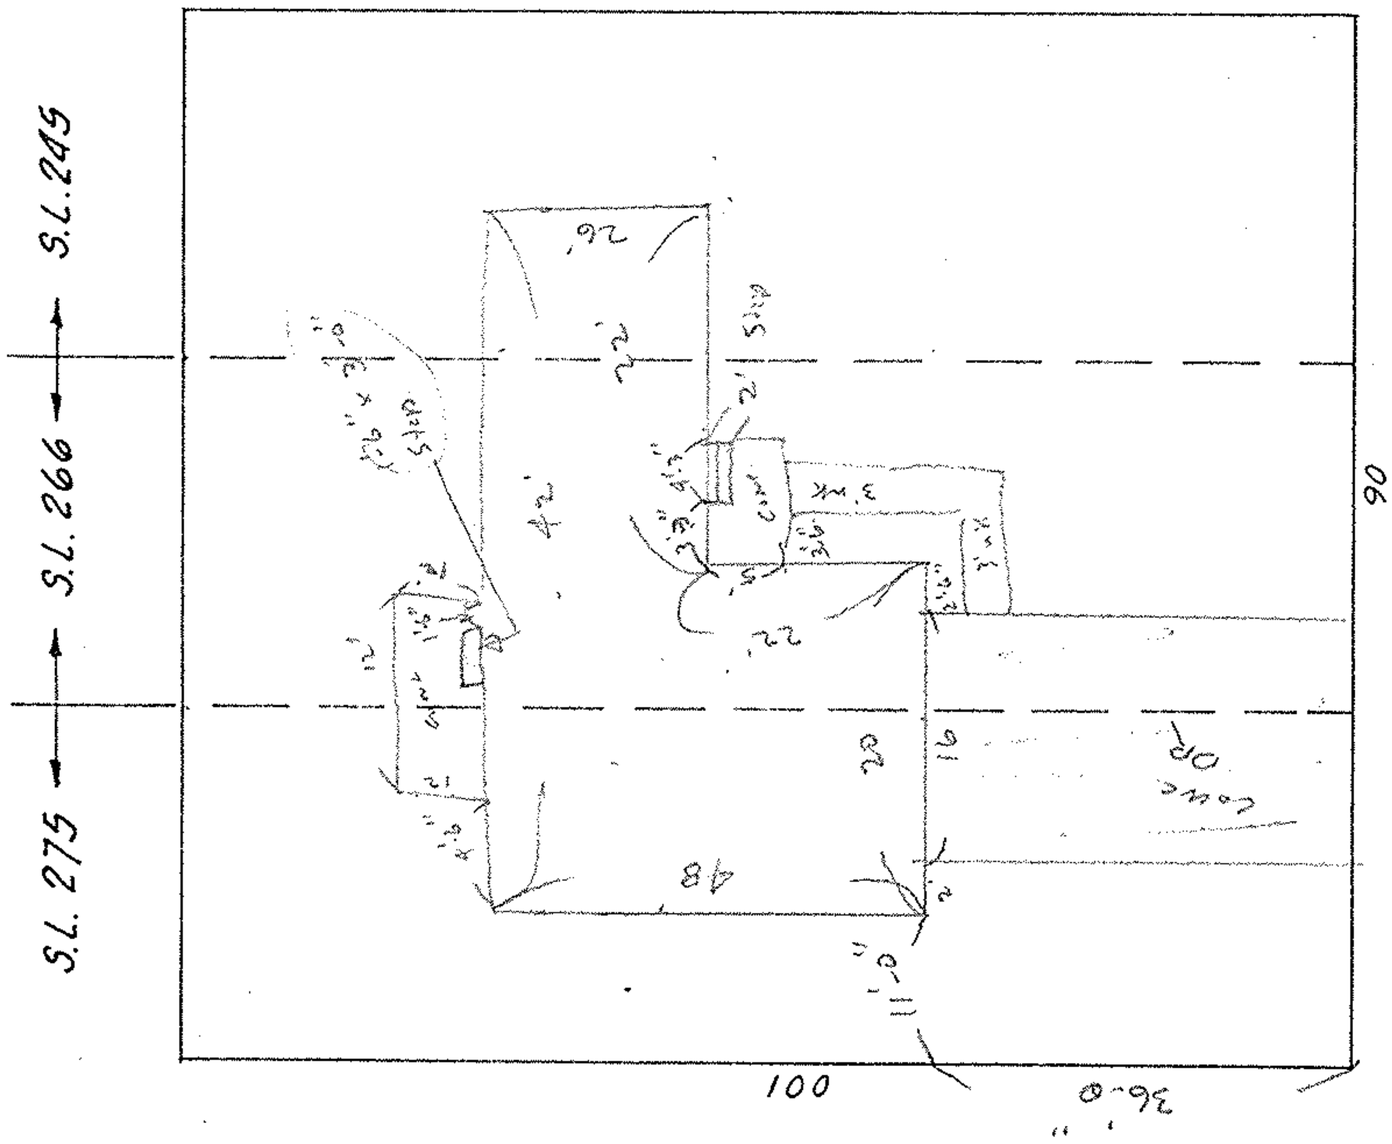

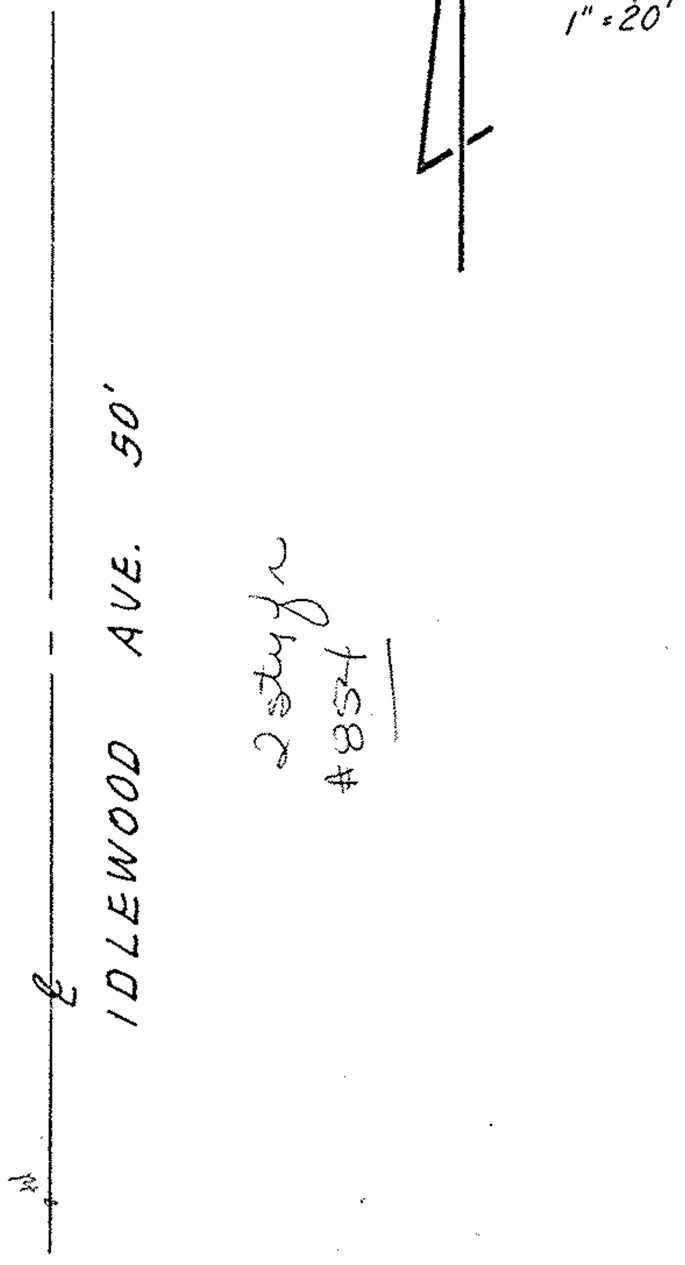

SUBLOTS #245, 266 & 275 of BLOCK 'D' of
CLEVELAND BEACH ALLOTMENT
PLAT VOL. 9, PG. 30 :: PART of ORIG.
SHEFFIELD TWP. LOT 40 - NOW in CITY of
SHEFFIELD LAKE, OHIO

McGLINCHY & ASSOCIATES
APRIL 21, 1977 #771845

MidT E-8557