



SUBLOT #103 of NEW ENGLAND ESTATES SUBDN. NO. 3
 PLAT VOL. 30 PAGE 65
 PART of ORIG. EATON
 NOW in VILLAGE of GRAFTON, OHIO TWP. LOT 99

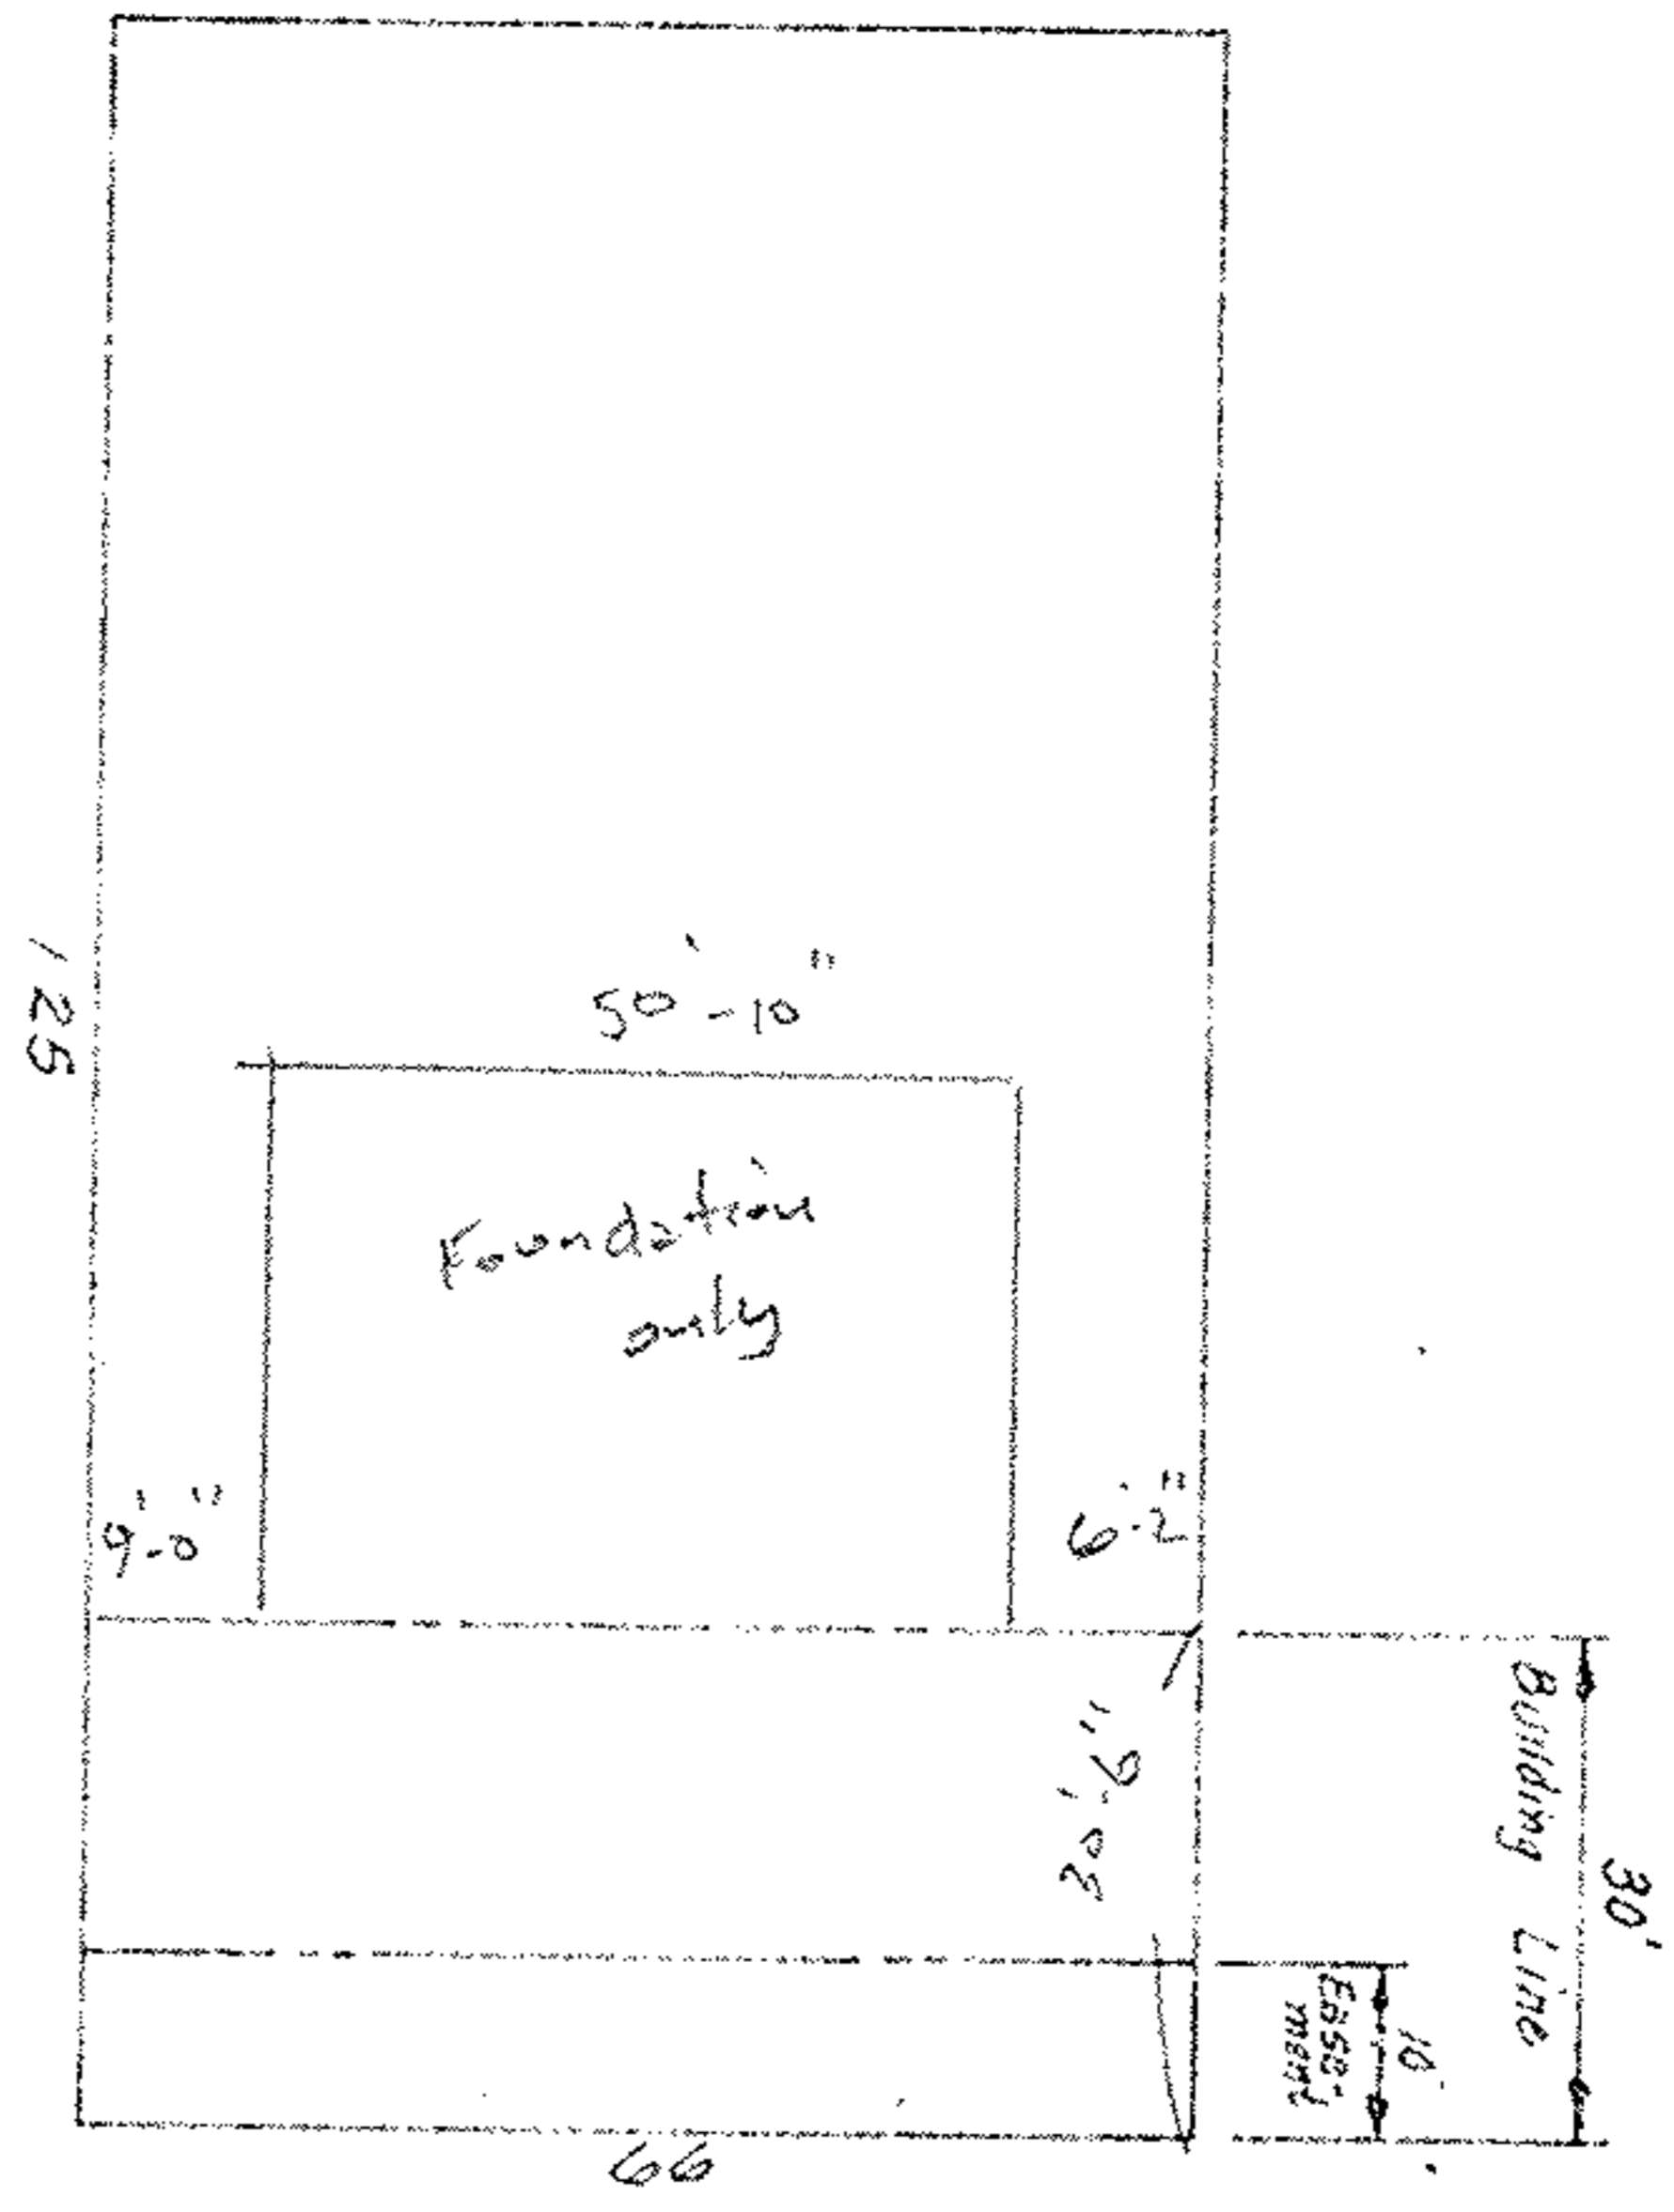

WASHINGTON DRIVE 50'

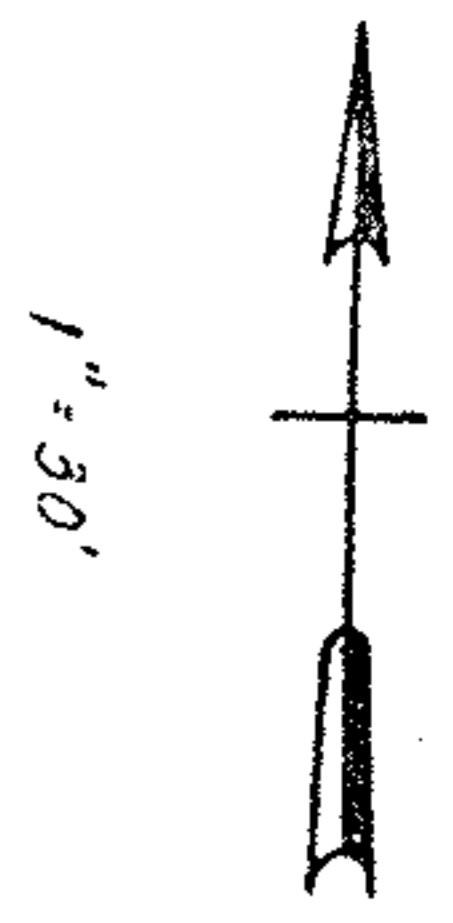

McGLINCHY & ASSOCIATES
 NOV. 1977 #772751