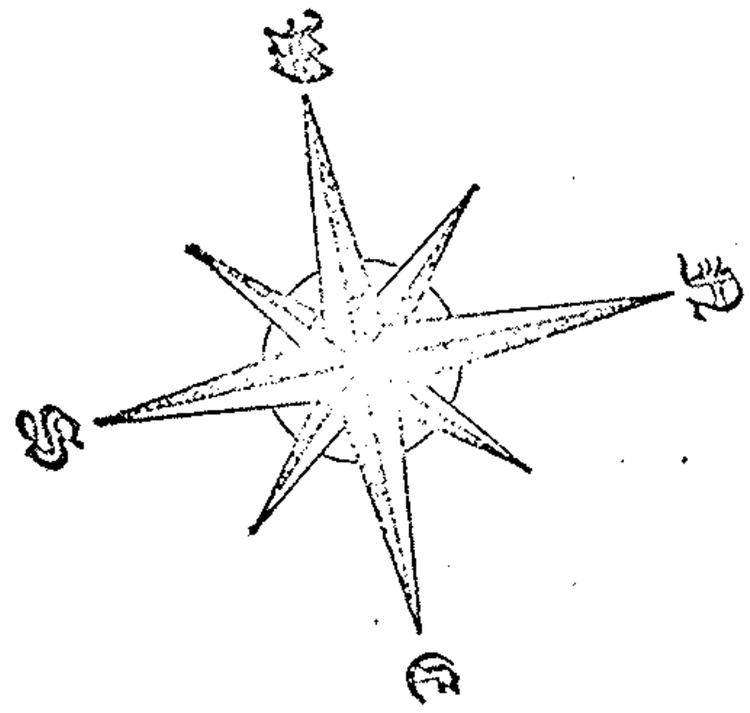

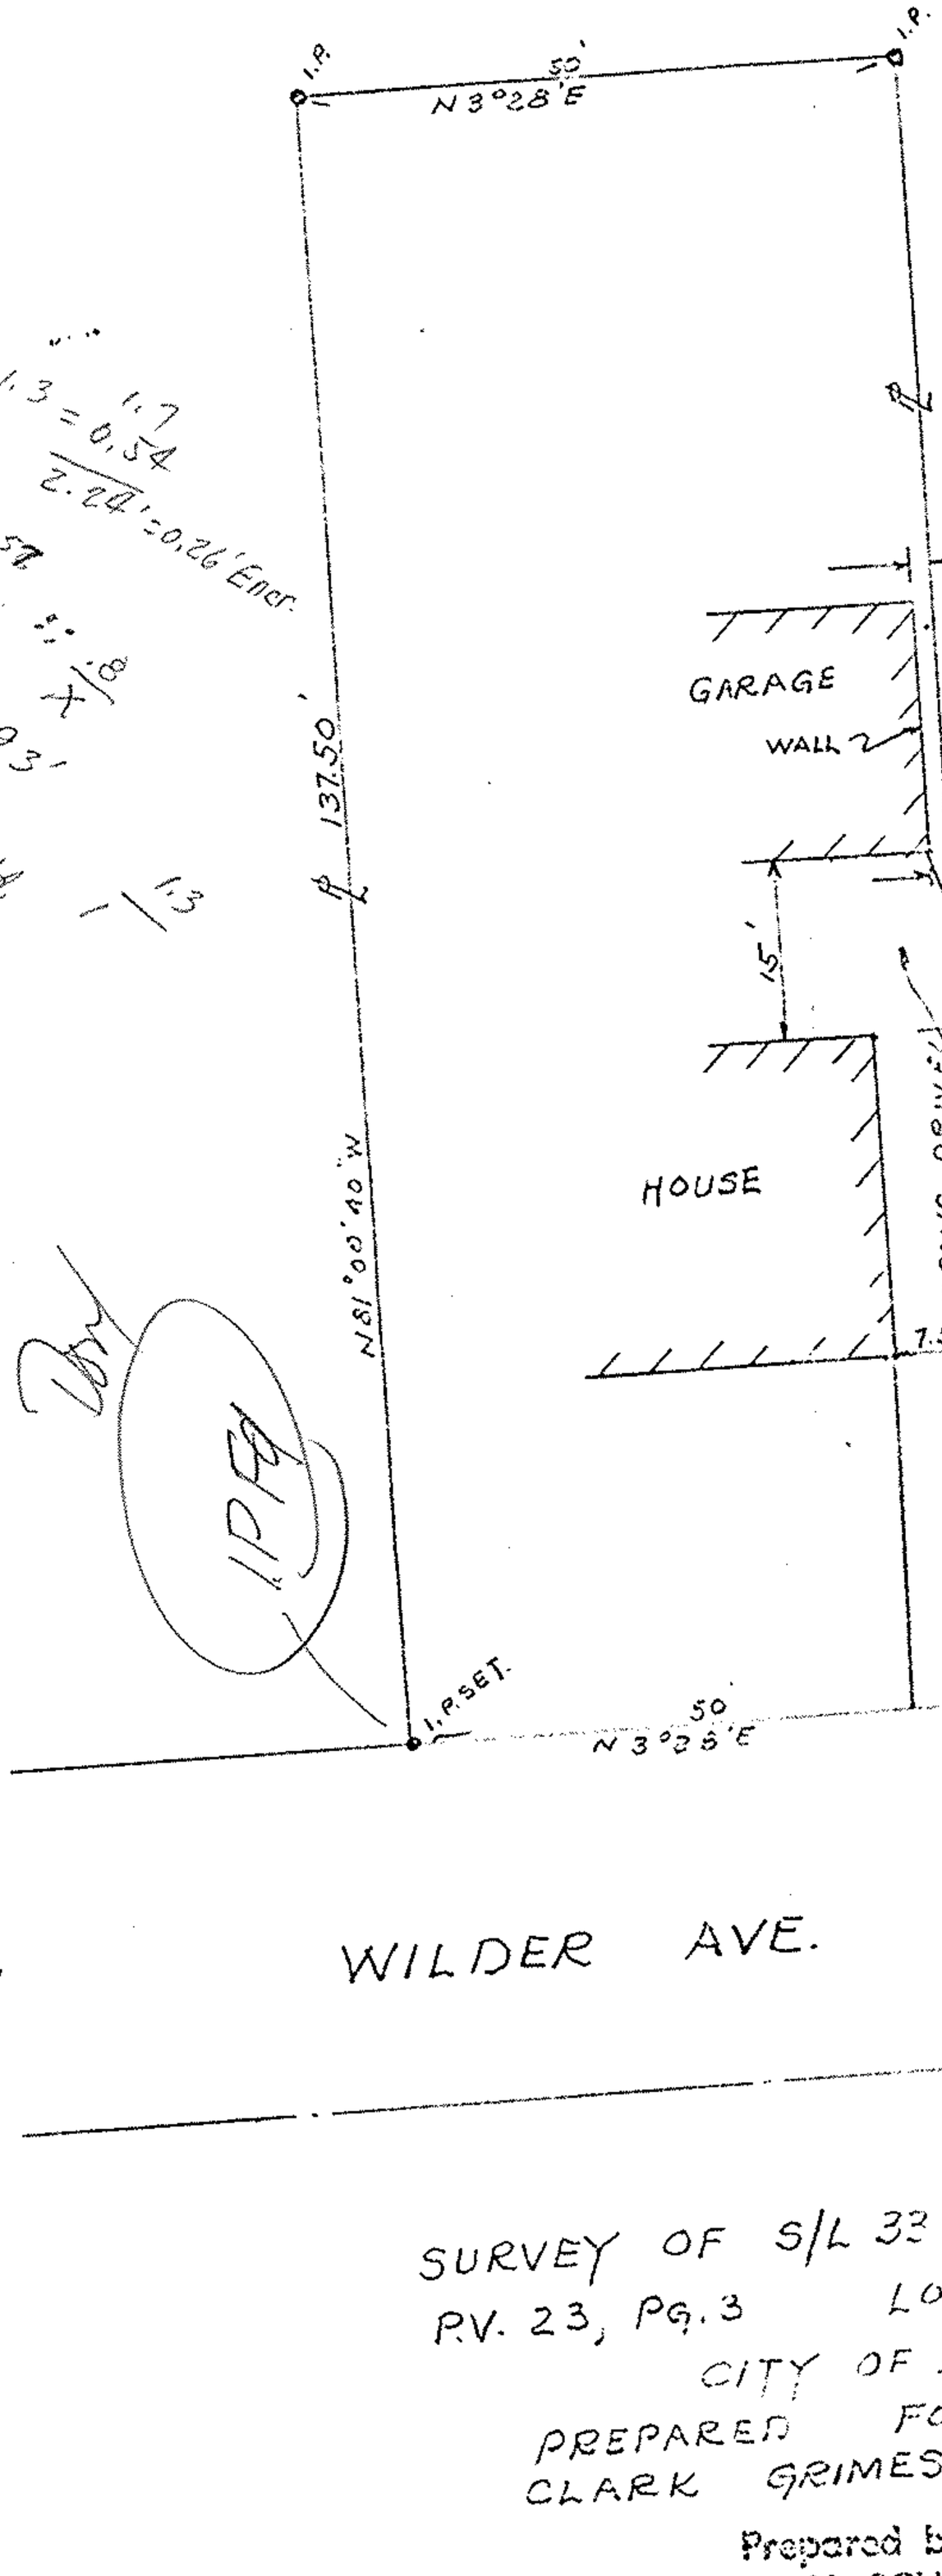

SURVEY OF S/L 33 ABBE KNOLL SUBD. #1
P.V. 23, PG. 3 LORAIN CO. OHIO
CITY OF ELYRIA

PREPARED FOR
CLARK GRIMES ELYRIA, OHIO

Prepared by
JAMES H. SCHMIDT
Registered Surveyor
307 Robinson Bldg., Elyria, O.

4/10/67

SCALE 1"=20'

#68133