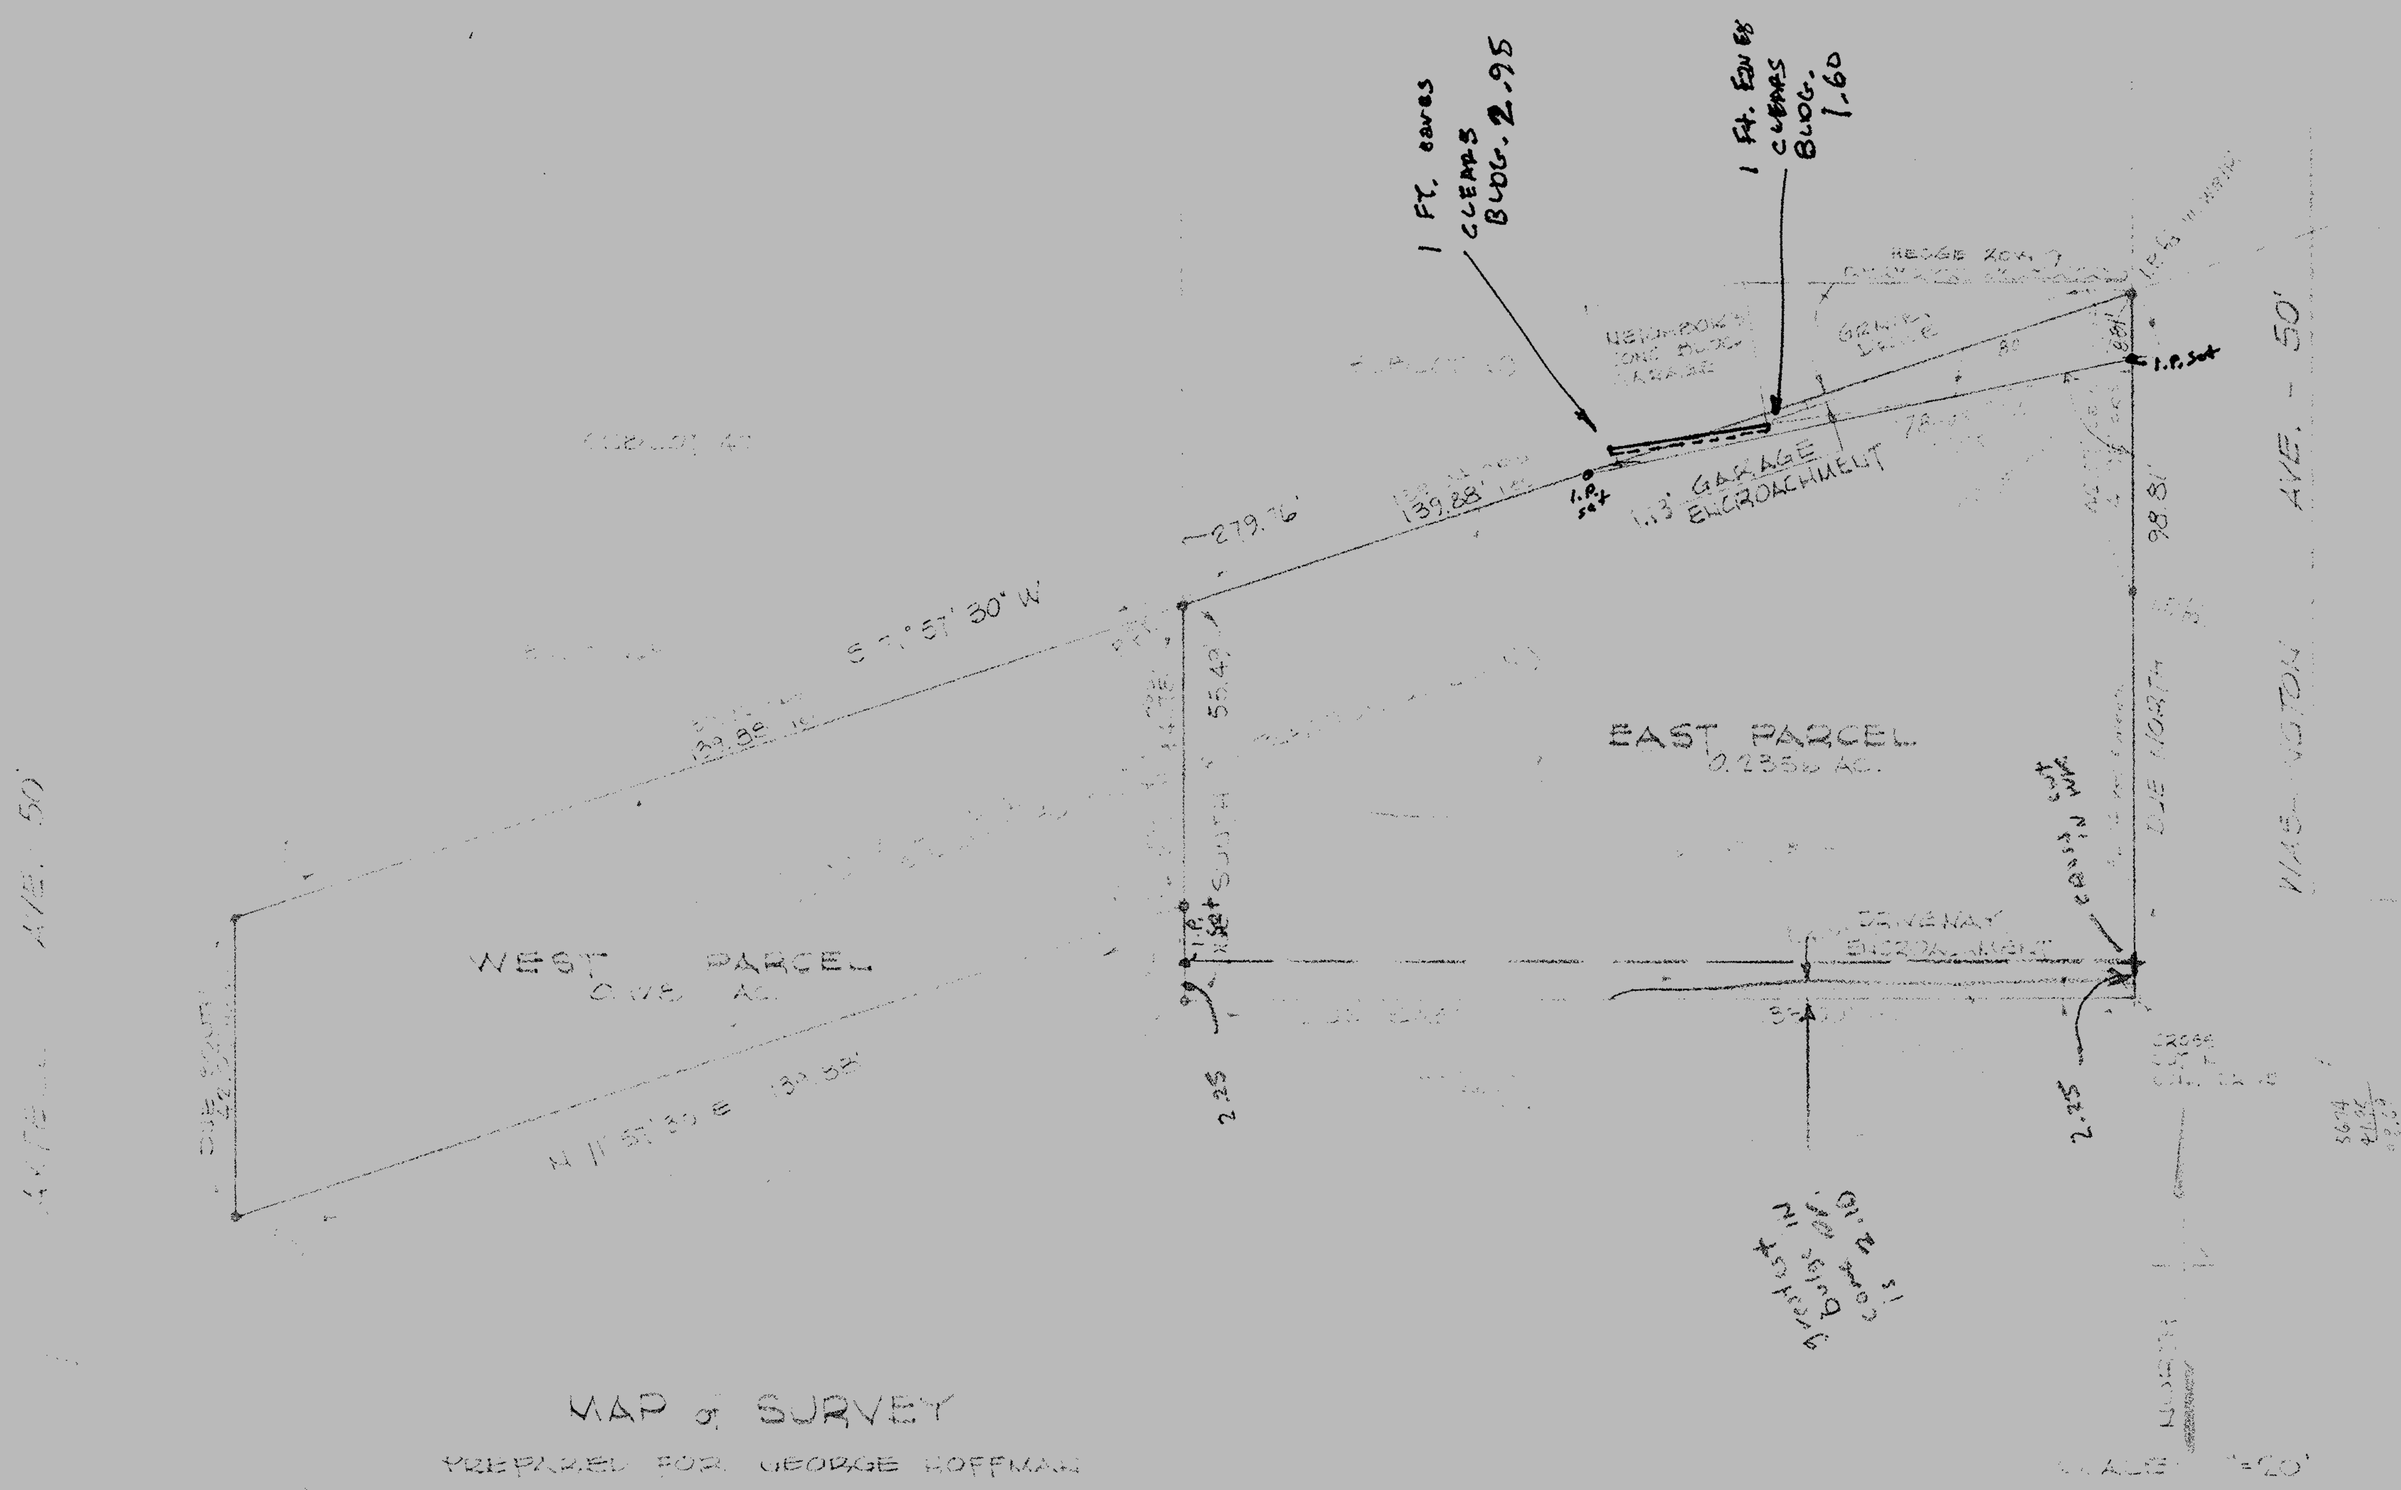

MAP of SURVEY

PREPARED FOR GEORGE HOFFMAN

PART of AXTELL HOMESTEAD ADDITION - PLAT VOL. [illegible]

PART of ORIGINAL AMHERST TOWNSHIP LOT No. 23

CITY of AMHERST LORAIN COUNTY OHIO

McGLINCHY and ASSOCIATES INC.

PROFESSIONAL ENGINEERS and SURVEYORS

ELYRIA OHIO

APRIL [illegible] #[illegible]