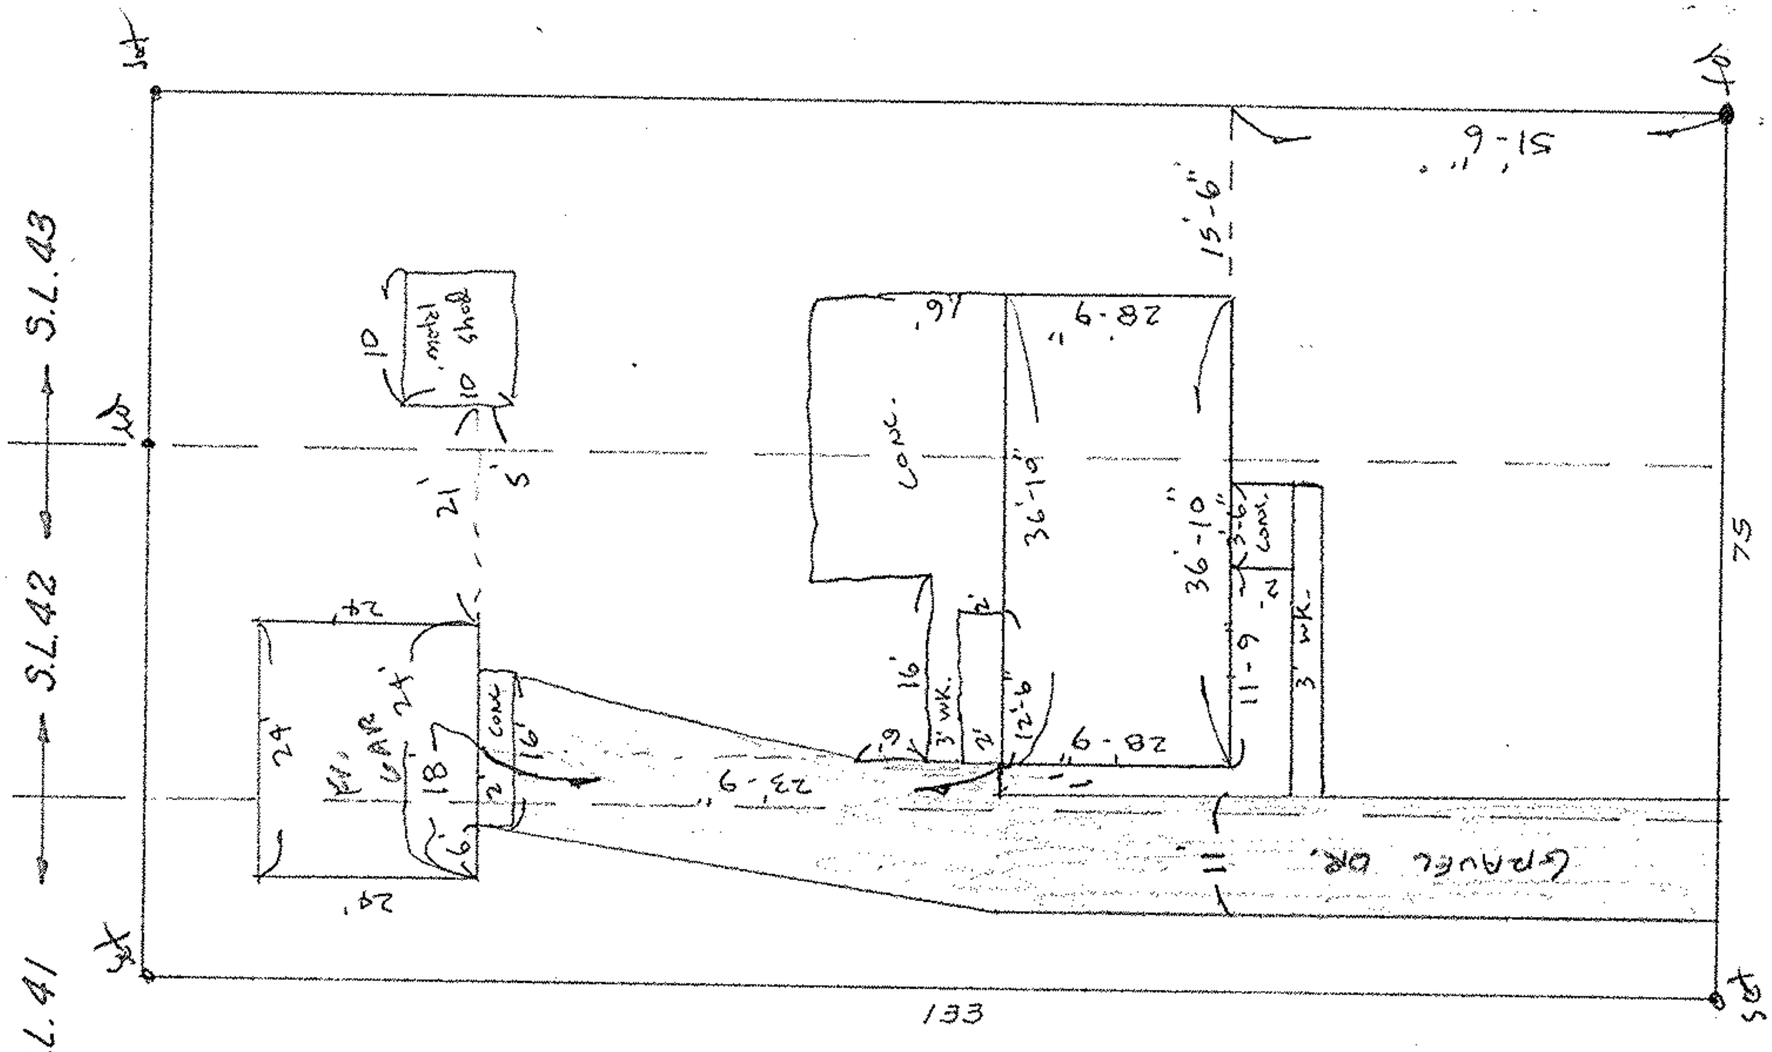

PART of SUBLOT 41 plus ALL of SUBLOTS #42 & 43 of BLOCK 'G' of CLEVELAND ROAD HOMESITES - PART of ORIG. RIDGEVILLE TWP. LOT 17. - NOW in CITY of NORTH RIDGEVILLE, OHIO

McGLINCHY & ASSOCIATES
MAR. 1977 771653