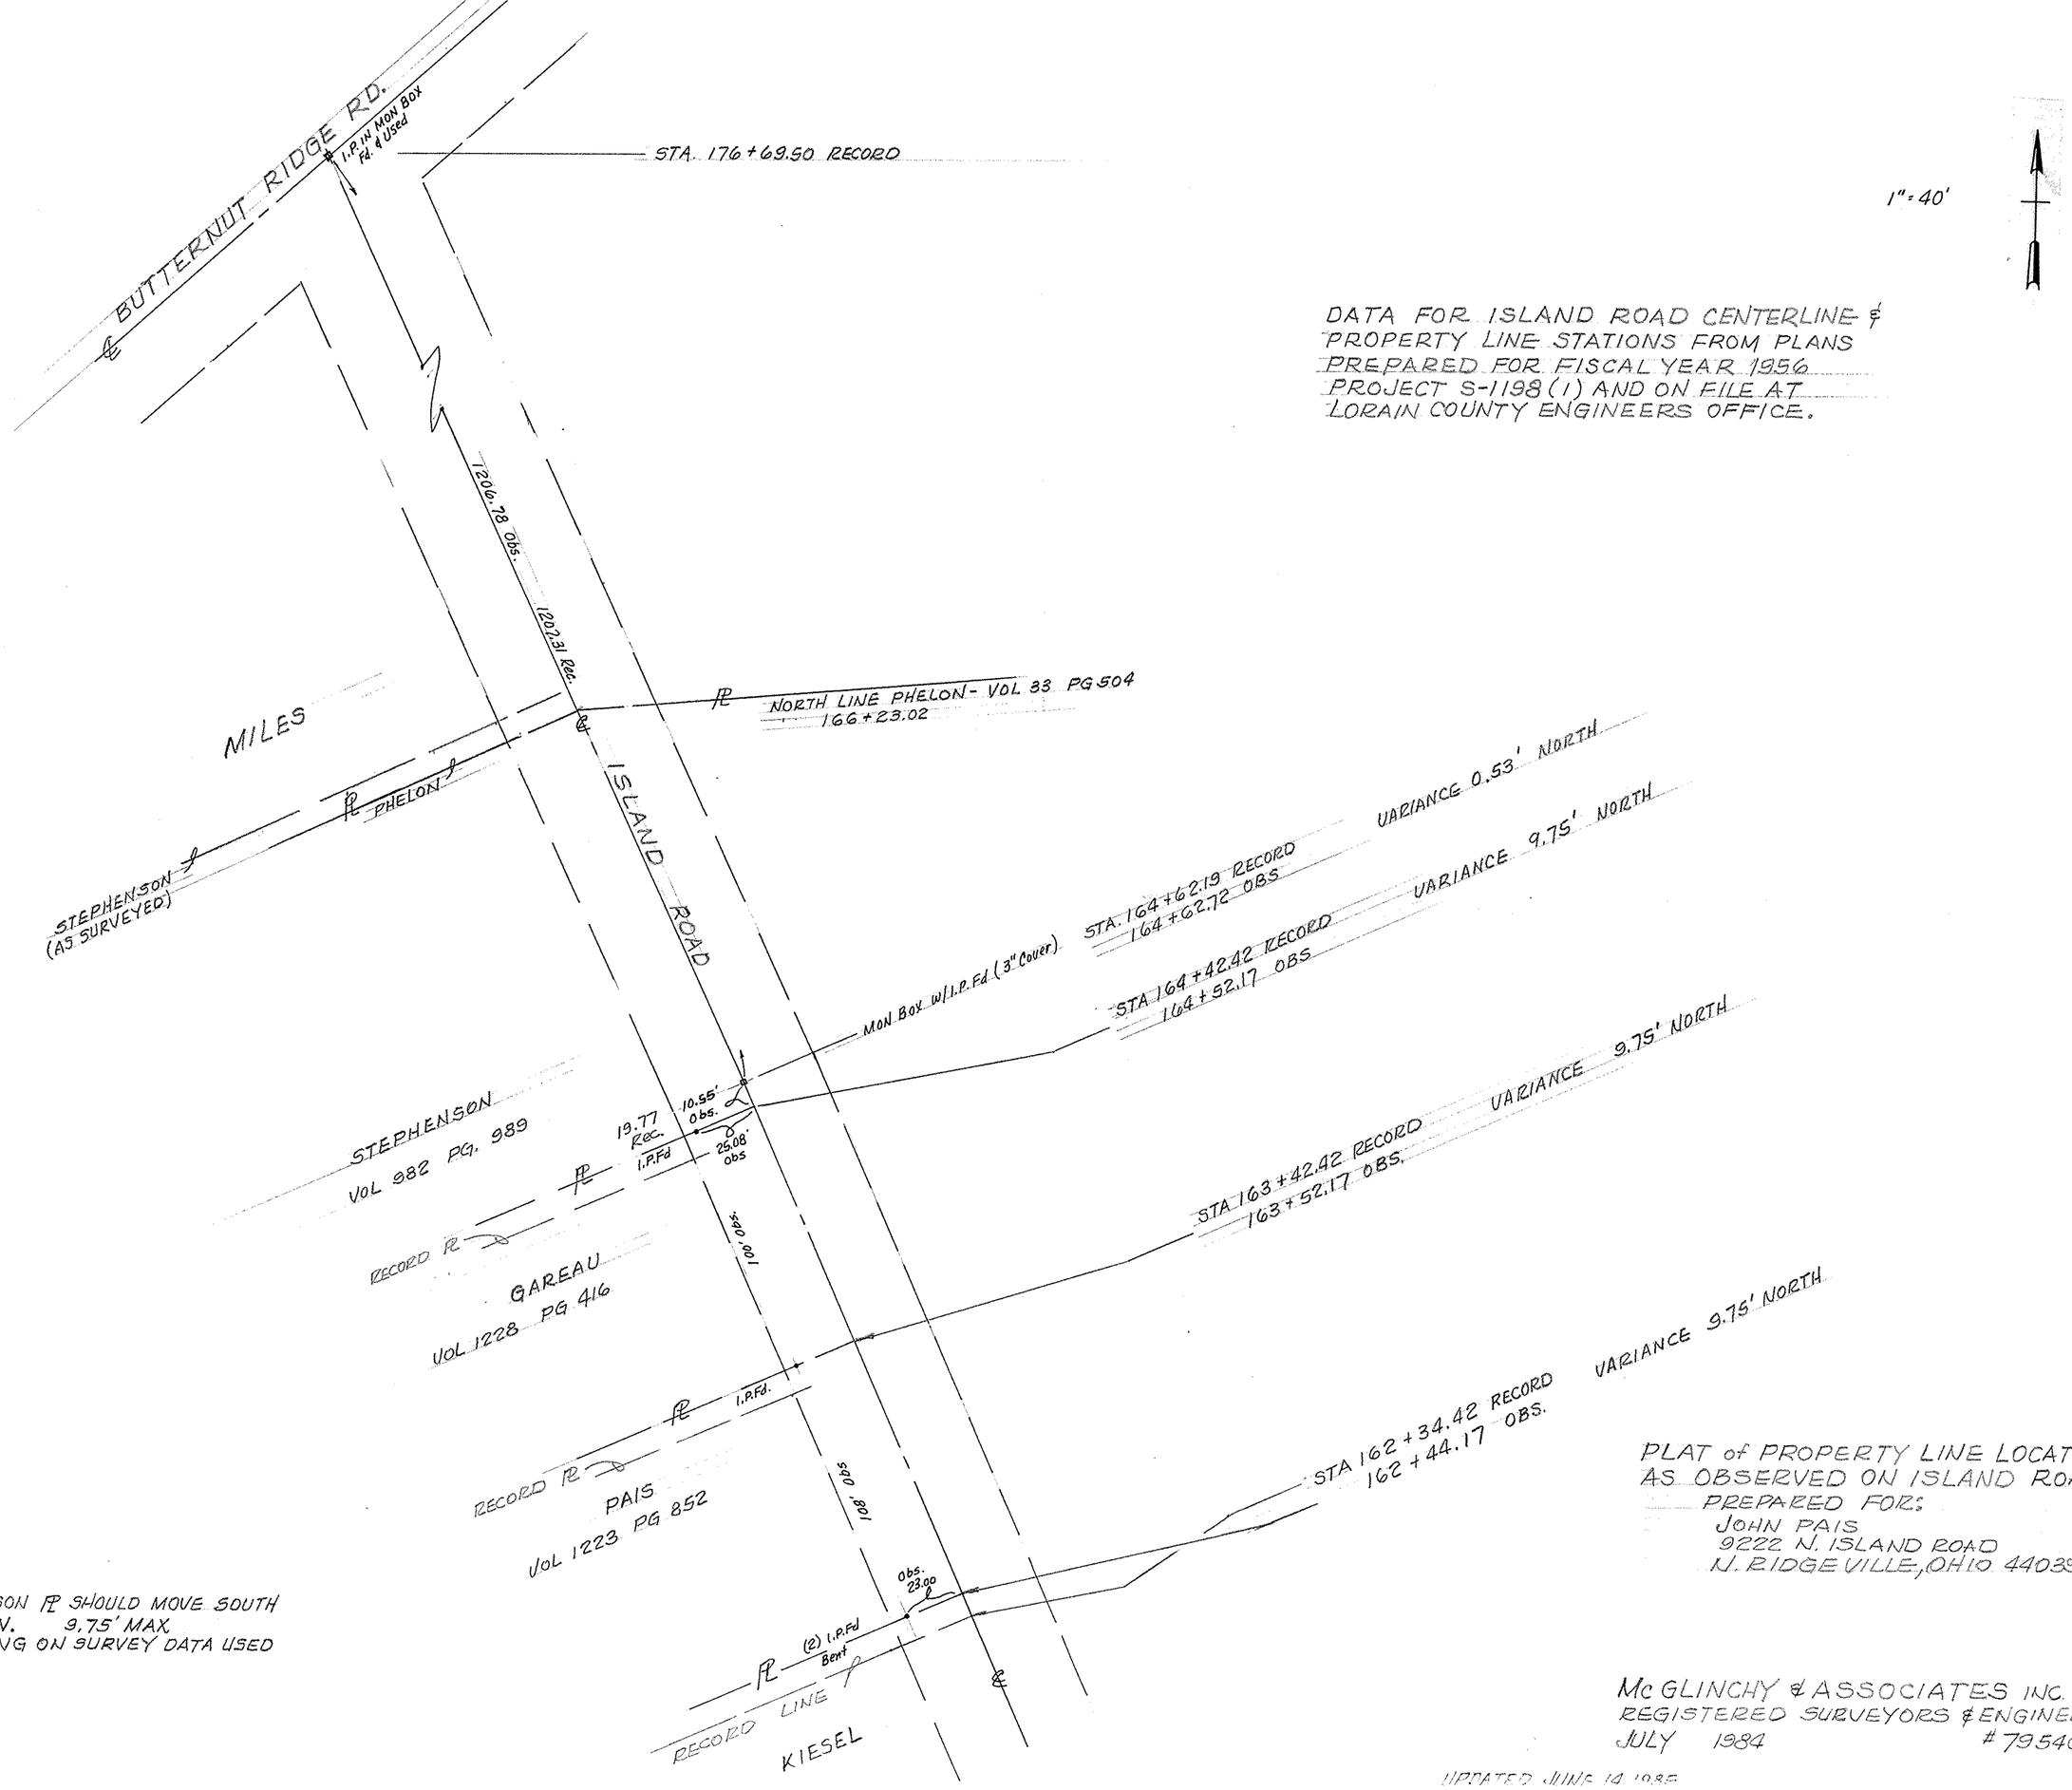

STEPHENSON ℞ SHOULD MOVE SOUTH
8.21' MIN. 9.75' MAX.
DEPENDING ON SURVEY DATA USED

PLAT of PROPERTY LINE LOCATIONS
AS OBSERVED ON ISLAND ROAD.
PREPARED FOR:
JOHN PAIS
9222 N. ISLAND ROAD
N. RIDGEVILLE, OHIO 44039

McGLINCHY & ASSOCIATES INC.
REGISTERED SURVEYORS & ENGINEERS
JULY 1984 #7954058

UPDATED JUNE 14 1985