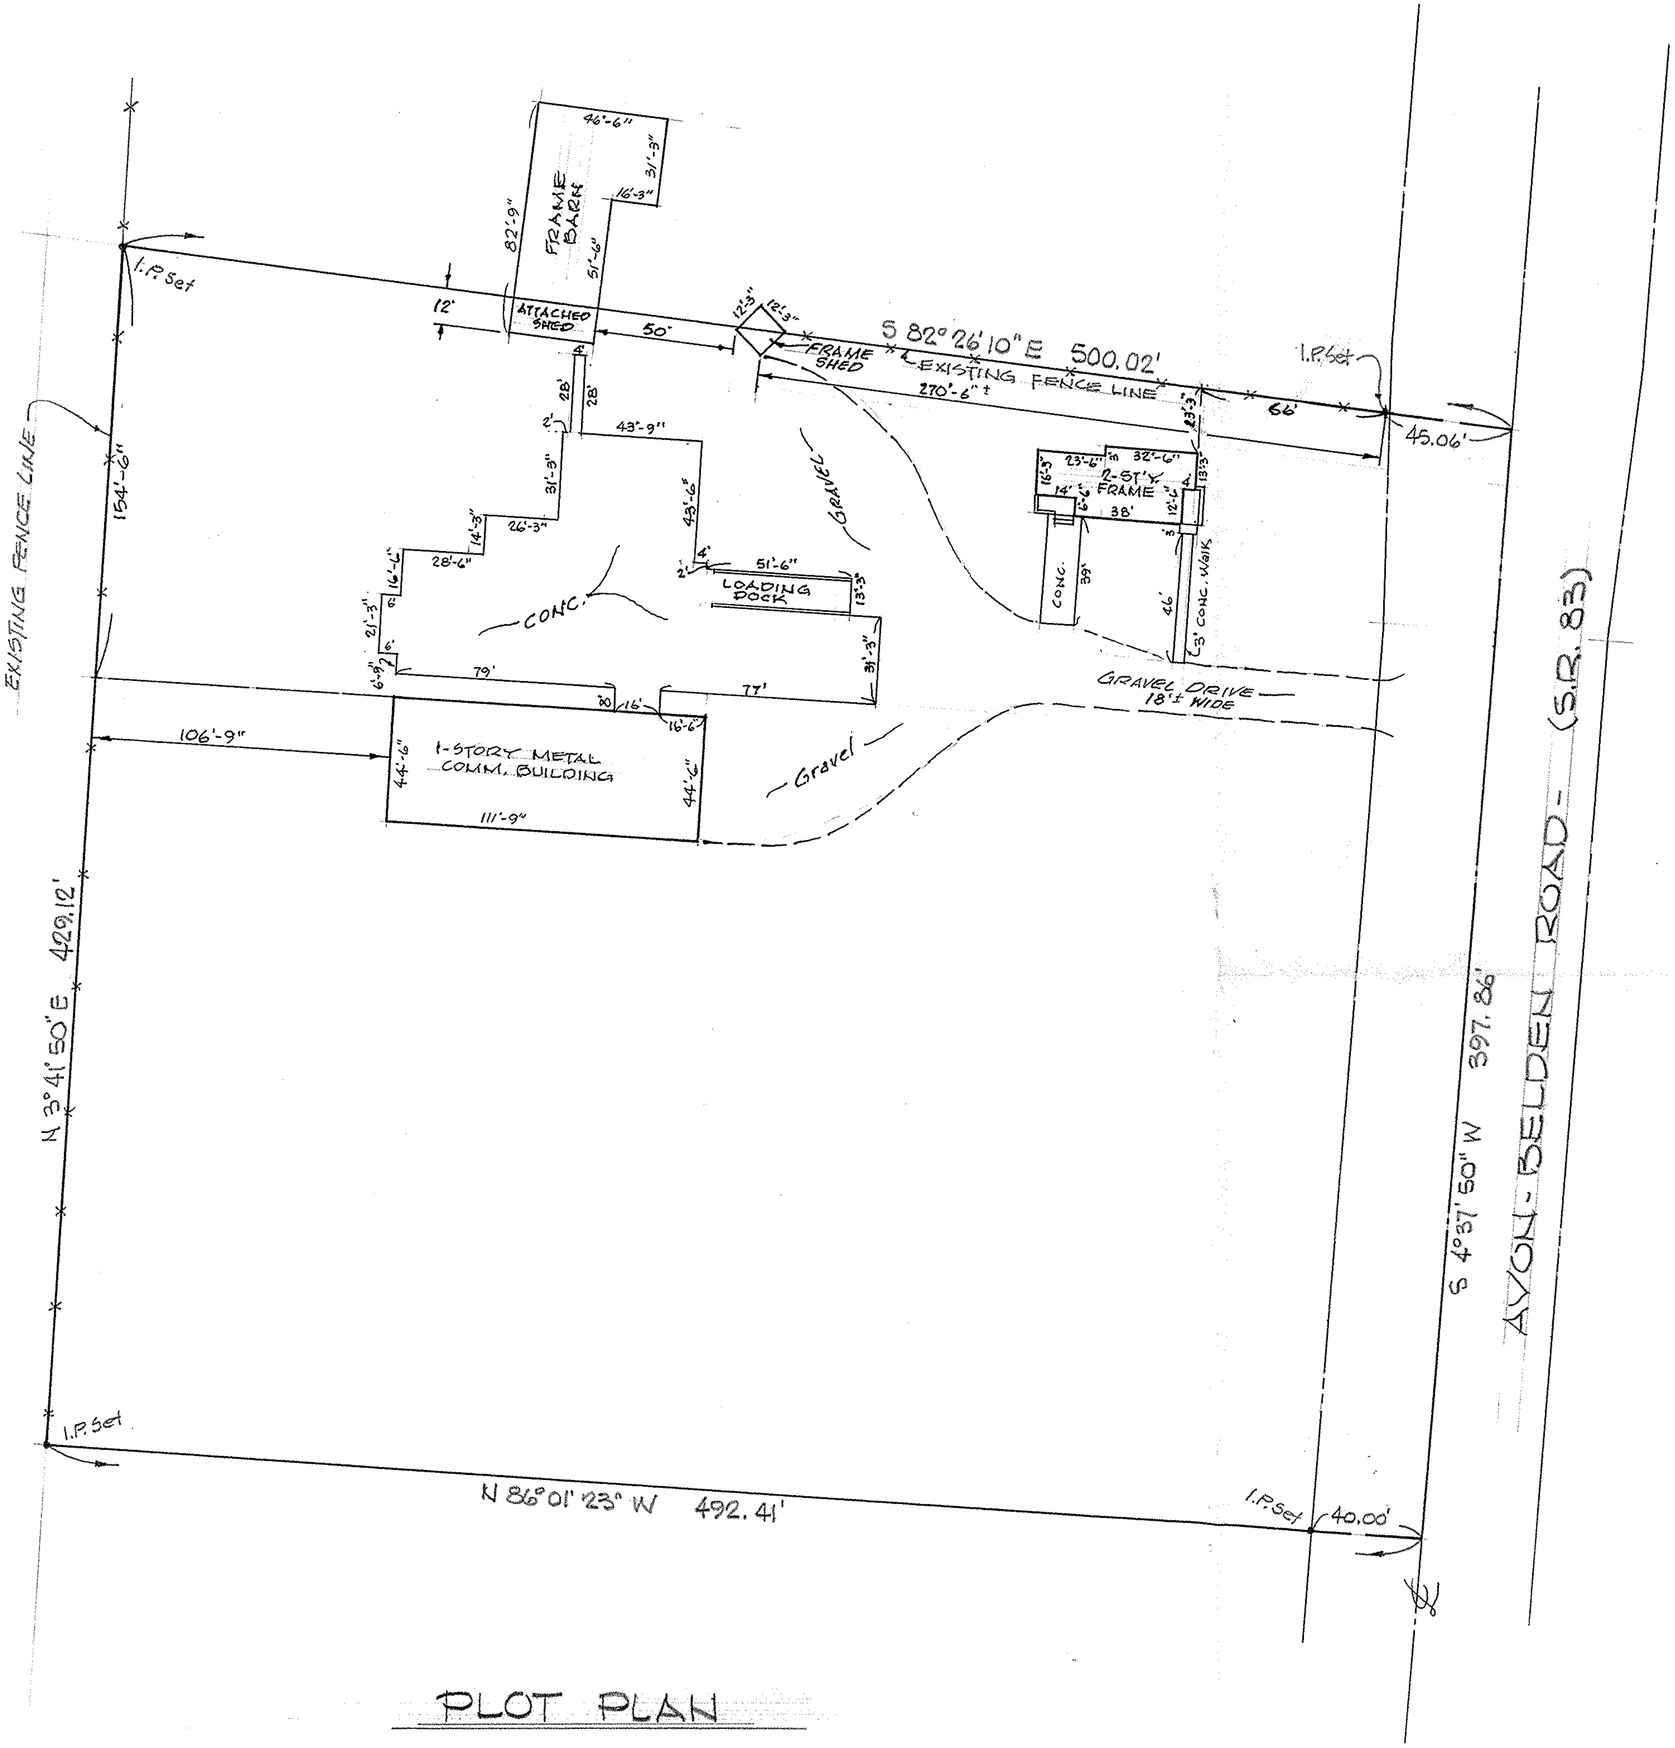

PLOT PLAN

PREPARED FOR ROSSBOROUGH MFG. Co.

PART of ORIGINAL EATON TWP. LOT 54
TOWNSHIP of EATON, LORAIN COUNTY, OHIO

McGLINCHY and ASSOCIATES INC.
PROFESSIONAL ENGINEER and SURVEYORS
ELYRIA OHIO
DECEMBER, 1979 #796019-A