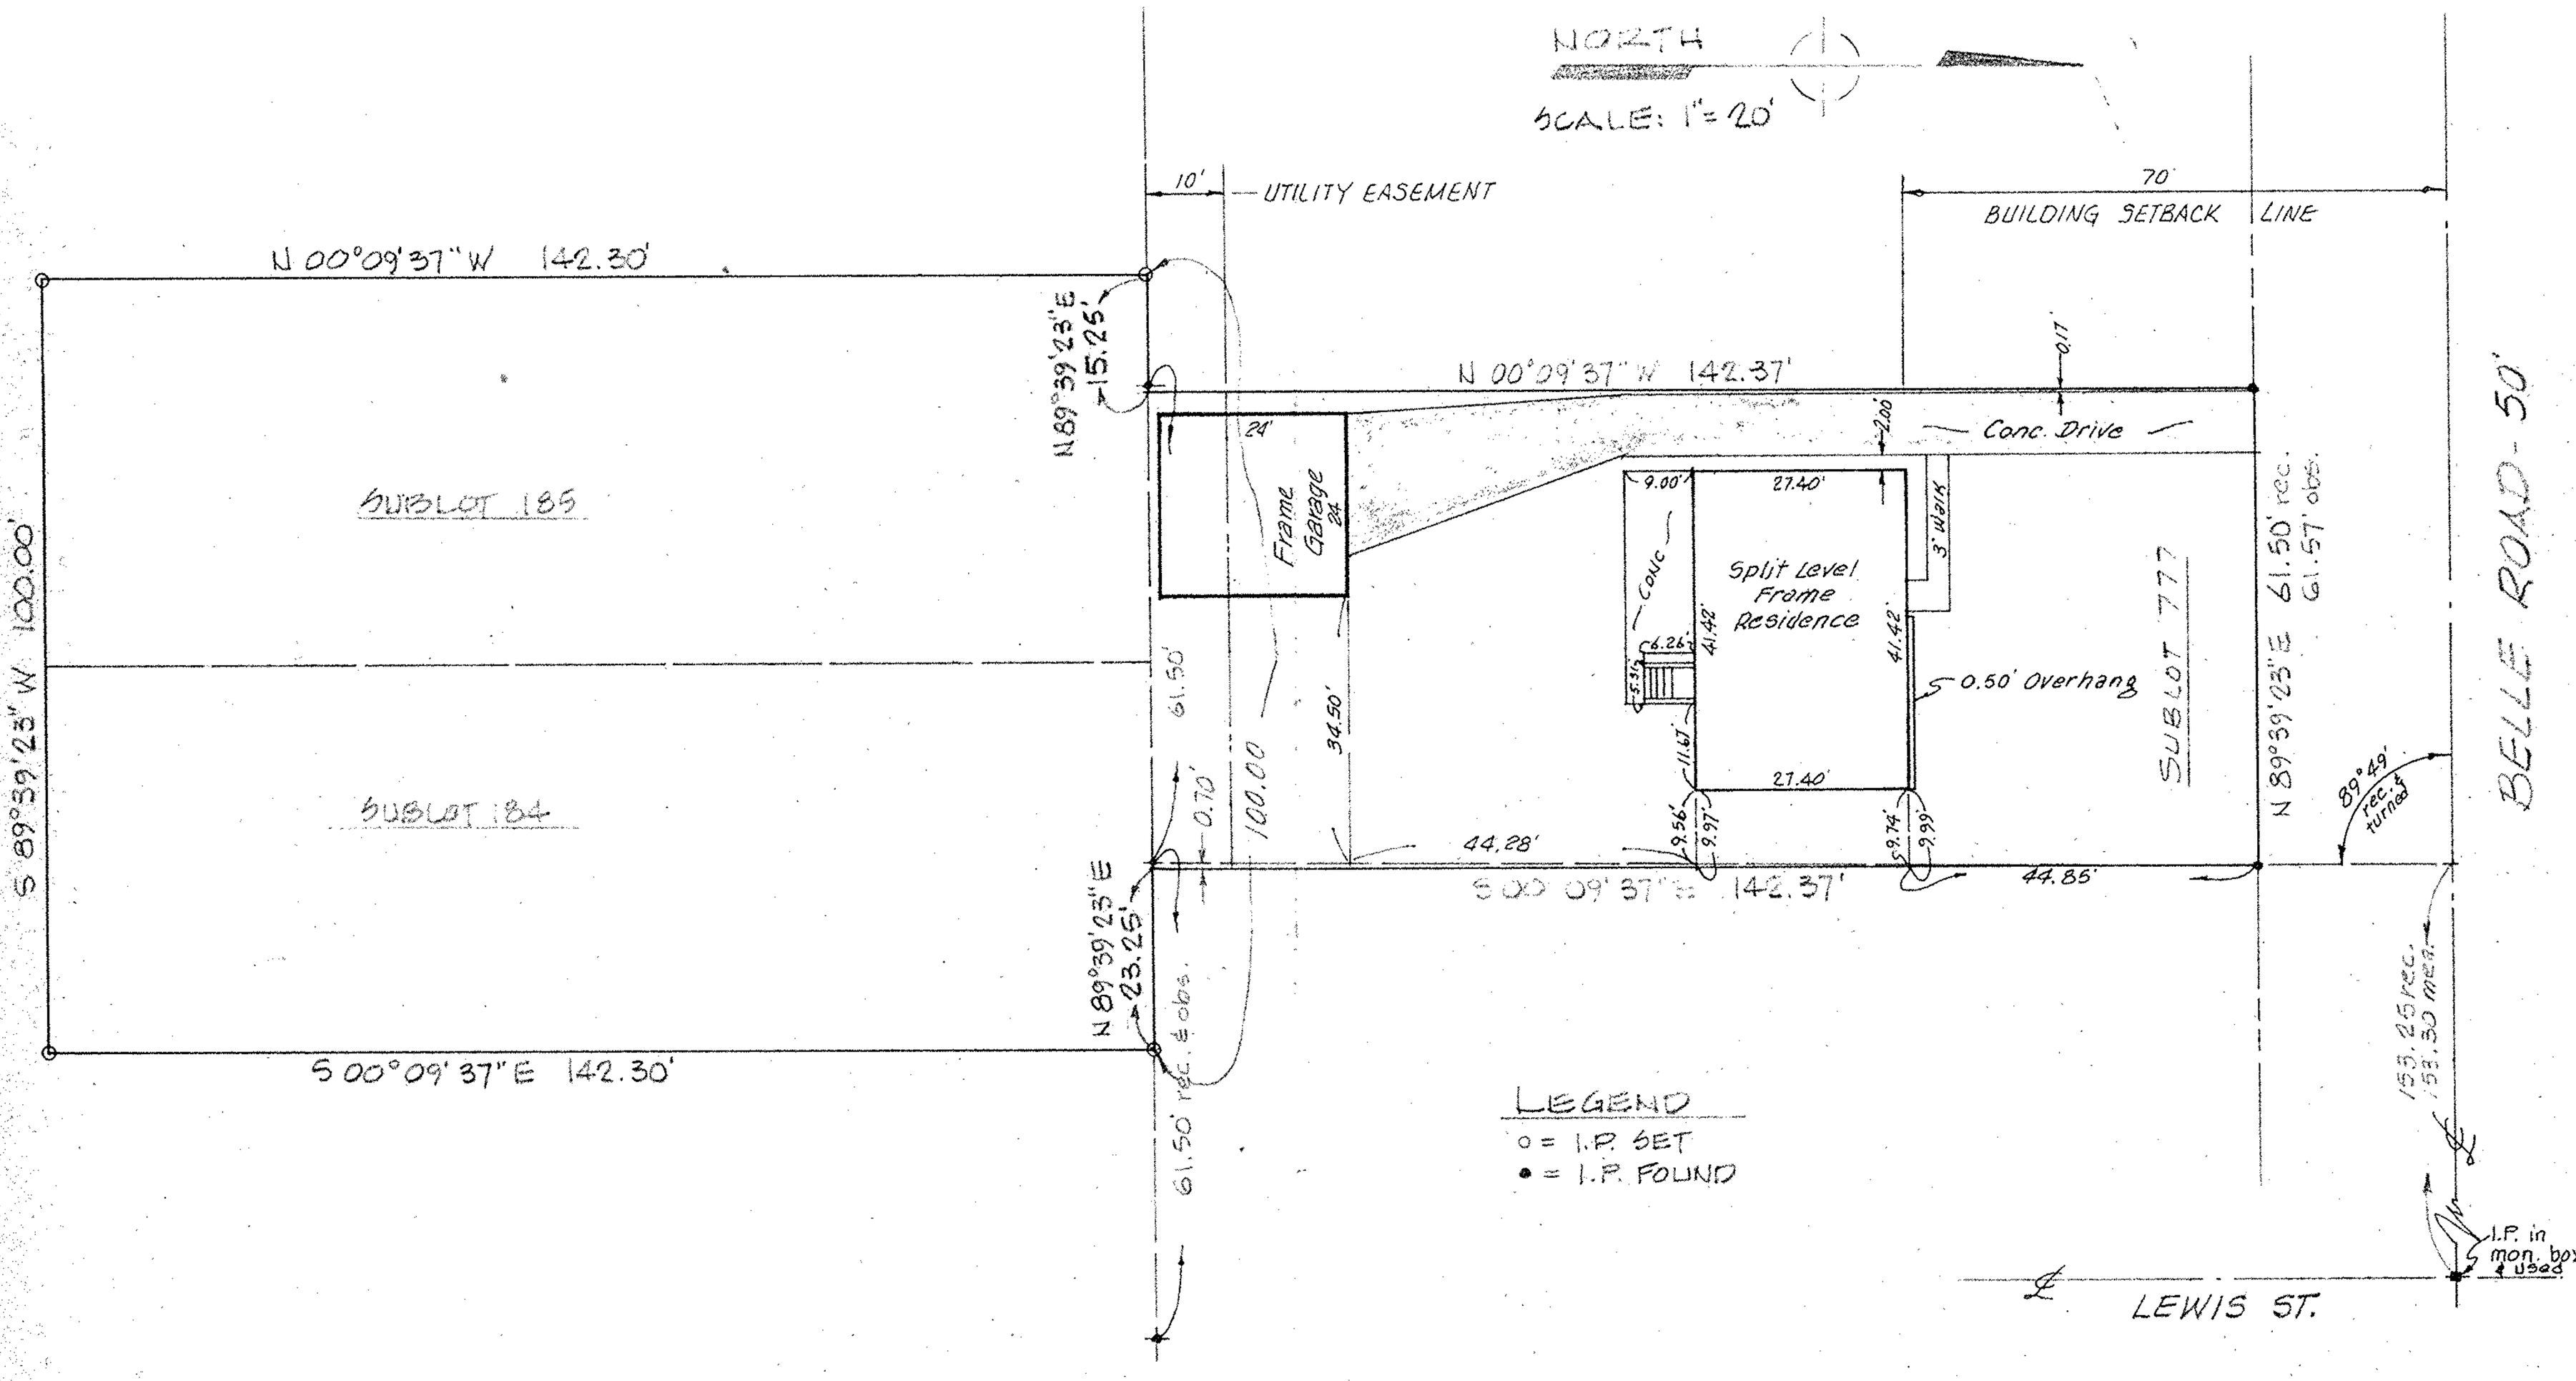

LEGEND
o = I.P. SET
• = I.P. FOUND

MAP of SURVEY

PREPARED FOR ROBERT C. ALBERS

SUBLOT Nos. 184 & 185 in BELDEN PARK SUB'D. (PLAT VOL. 12, PG. 8 & 9) and
SUBLOT No. 777 in BELDEN PARK SUB'D No. 2 (PLAT VOL. 18, PG. 24)
CITY of AVON LAKE, LORAIN COUNTY, OHIO

McGLINCHY & ASSOCIATES INC
PROFESSIONAL ENGINEER & SURVEYORS
110½ MIDDLE AVE. ELYRIA, OHIO
SEPTEMBER 2, 1981 #817000

9/25/81 ADDED ESM'T & BLDG SETBACK LINES 10/7/81 CORR. GARAGE LOC.