# PLAT OF SURVEYS FOR
# MRS. EVA L. RIDER

ORIGINAL LOT NO. 22 TRACT NO. 11
CAMDEN TWP. – LORAIN COUNTY – OHIO
SCALE: 1" = 120'
PARCELS 1-2-3 & 4 SURVEYED AUGUST-1978
Gary E. Pentfound Reg. Surveyor No. 4957
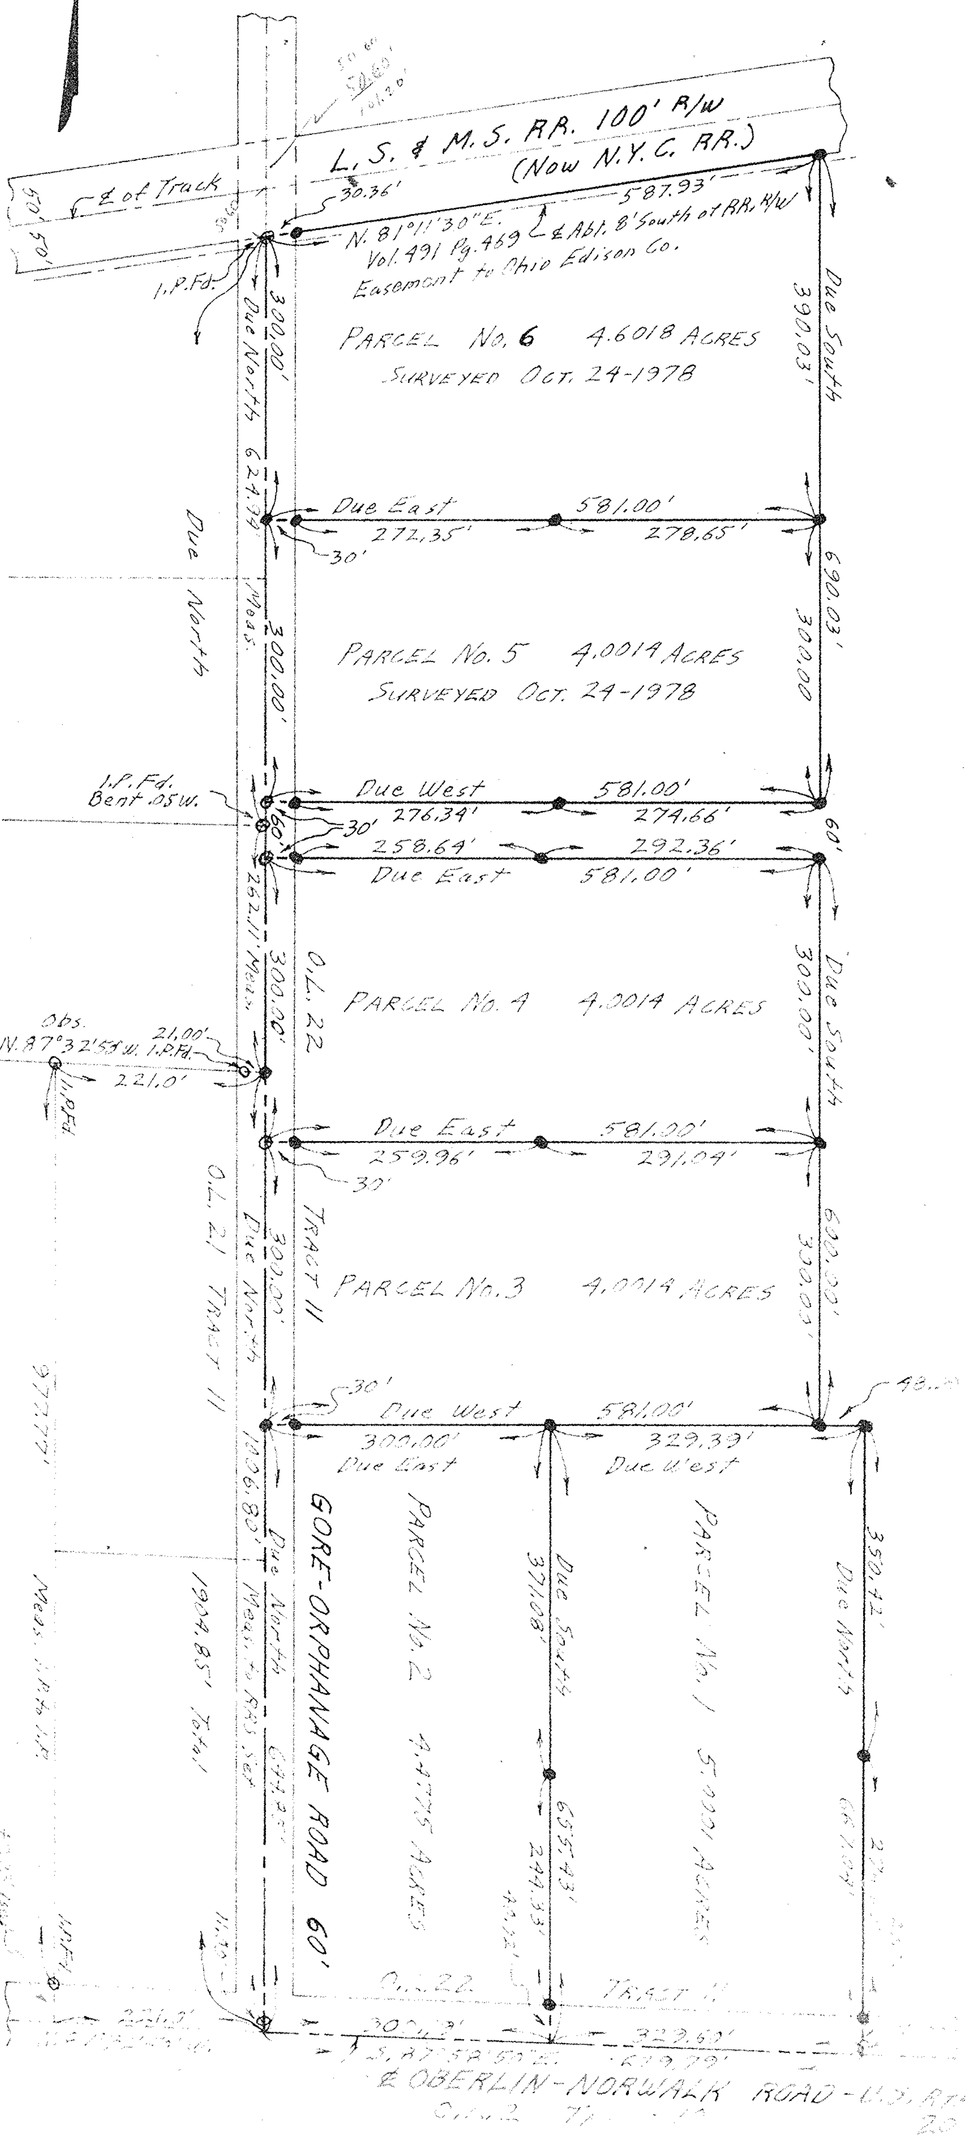
NOTES: ● indicates iron pin set.
○ indicates railroad spike set in pavement unless otherwise designated.